


Claim Map for Permit G 18514, Application G 18893, Township 15S Range 5W Sections 9
Benton County Tax Lot 155080000700

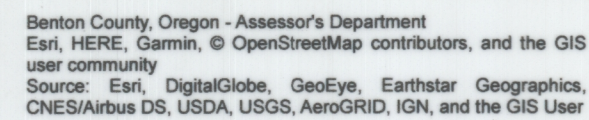

AREA OF USE BY QTR-QTR				
TAX LOT	ACRES	40	160	SECTION
700	6.34	NW	NE	9

Certified Water Right Examiner
76773WRE
Steven I. Recca
Steven I Recca
June 29, 2007
STATE OF OREGON

EXPIRATION DATE:12/31/22

OWRD