

# **WELL AND POD LOCATIONS**

WELL 1 (KLAM 2289): T37S, R10E, W.M., SEC. 30, NE1/4 NW1/4; 1250 FEET SOUTH & 2560 FEET WEST FROM THE NORTHEAST CORNER OF SECTION 30.

WELL 2 (KLAM 50445): T37S, R10E, W.M., SEC. 19, SE1/4 SW1/4; 670 FEET NORTH & 2760 FEET WEST FROM THE SOUTHEAST CORNER OF SECTION 19.

WELL 3 (KLAM 10082): T37S, R10E, W.M., SEC. 19, SW1/4 NE1/4; 1630 FEET SOUTH AND 2220 FEET WEST FROM THE NORTHEAST CORNER OF SECTION 19.

POD 1: T37S, R10E, SEC. 19, SW1/4 NE1/4; 2520 FEET SOUTH & 2100 FEET WEST FROM THE NORTHEAST CORNER OF SECTION 19.

POD 2: T37S, R9E, SEC. 23, NE1/4 SW1/4; 2530 FEET NORTH & 2380 FEET EAST FROM THE SOUTHWEST CORNER OF SECTION 23.


## **NOTES**

1. THE PURPOSE OF THIS MAP IS TO IDENTIFY THE LOCATION OF THE WATER RIGHT ONLY, AND IS NOT INTENDED TO PROVIDE DIMENSIONS OR LOCATION OF PROPERTY LINES.
2. PRIORITY DATE FOR CERTIFICATE 22847 IS AUGUST 2, 1948. PRIORITY DATE FOR CERTIFICATE 33176 IS AUGUST 2, 1948. PRIORITY DATE FOR CERTIFICATE 83328 IS FEBRUARY 27, 1995. PRIORITY DATE FOR CERTIFICATE 87897 IS JANUARY 7, 1999. PRIORITY DATE FOR CERTIFICATE 88113 IS FEBRUARY 27, 1995.

## **LEGEND**

SECTION LINE	0.5 SWNE	CERTIFICATE 22847 (IRRIGATED BY WELLS 1, 2, & 3)
1/4 1/4 LINE	12.5 NESW	CERTIFICATE 88113 (IRRIGATED BY WELLS 1, 2, & 3)
TAX LOT LINE	2.2 SWNE	CERTIFICATE 22847 (IRRIGATED BY WELLS 1, 2, & 3)
CREEK/DITCH	3.3 SENW	CERTIFICATE 83328 (IRRIGATED BY WELLS 1, 2, & 3)
BURIED PIPE	6.8 SENW	CERTIFICATE 83328 SUPPLEMENTAL IRRIGATION (IRRIGATED BY WELLS 1, 2, & 3) AND CERTIFICATE 33176 PRIMARY IRRIGATION (IRRIGATED BY PODS 1 & 2)
ROAD	26.2 NWSE	CERTIFICATE 83328 (IRRIGATED BY WELLS 1, 2, & 3)
FLOW DIRECTION	0.9 SENW	CERTIFICATE 22847 (IRRIGATED BY WELLS 1, 2, & 3)
SECTION CORNER	1.1 SENW	CERTIFICATE 87897 (IRRIGATED BY WELLS 1, 2, & 3)
TAX LOT NUMBER		
POA		
POD		
CENTER PIVOT CIRCLE		

RECEIVED  
SEP 16 2022  
OWRD

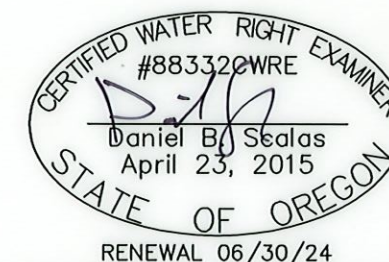

## **CLAIM OF BENEFICIAL USE AND FINAL PROOF MAP**

FOR  
JOSEPH HARTER, SUSAN HARTER,  
ANDREW HARTER, & KERRY HARTER  
T37S, R10E, SEC. 19, 20, 29, & 30  
KLAMATH COUNTY, OREGON  
TRANSFER T-13424

**ADKINS** ENGINEERING & SURVEYING  
o / 541.884.4666  
w / AdkinsEngineering.com

1435 ESPLANADE AVENUE, KLAMATH FALLS, OR 97601

SERVING S. OREGON & N. CALIFORNIA

ENGINEERING • SURVEYING • PLANNING • TESTING

3597-01

9/2/2022