


CRAIG AND JILL BLACKBURN
FINAL PROOF SURVEY

Situated in the Northwest quarter of Section 30,
Township 11 South, Range 40 East of the
Willamette Meridian, Baker County, Oregon

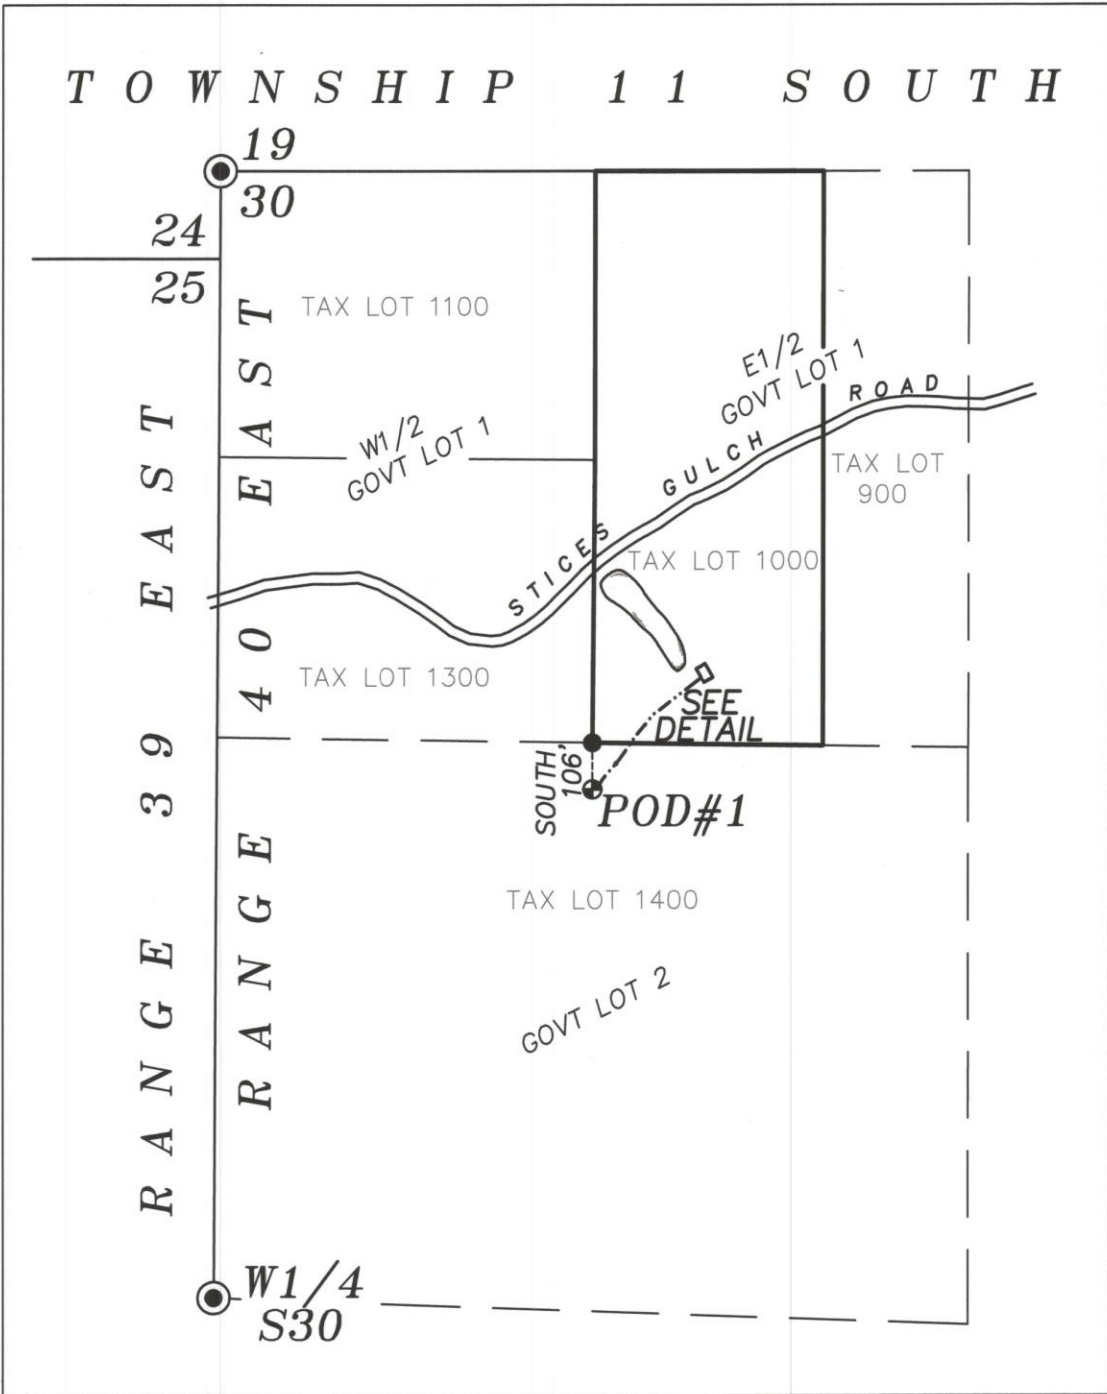


SCALE: 1"=400'

LEGEND

- Point of Diversion Spring Box
- Cistern
- Survey Monument
- Water Line
- Ditch

September 8, 2022
CLAIM OF BENEFICIAL USE
FOR AN EXPANDED DOMESTIC RIGHT
FOR
CRAIG AND JILL BLACKBURN
BY
BAGETT, GRIFFITH AND BLACKMAN
2006 ADAMS AVE
LA GRANDE, OREGON 97850

APPLICATION NO. S-72737
PERMIT NUMBER S-52628

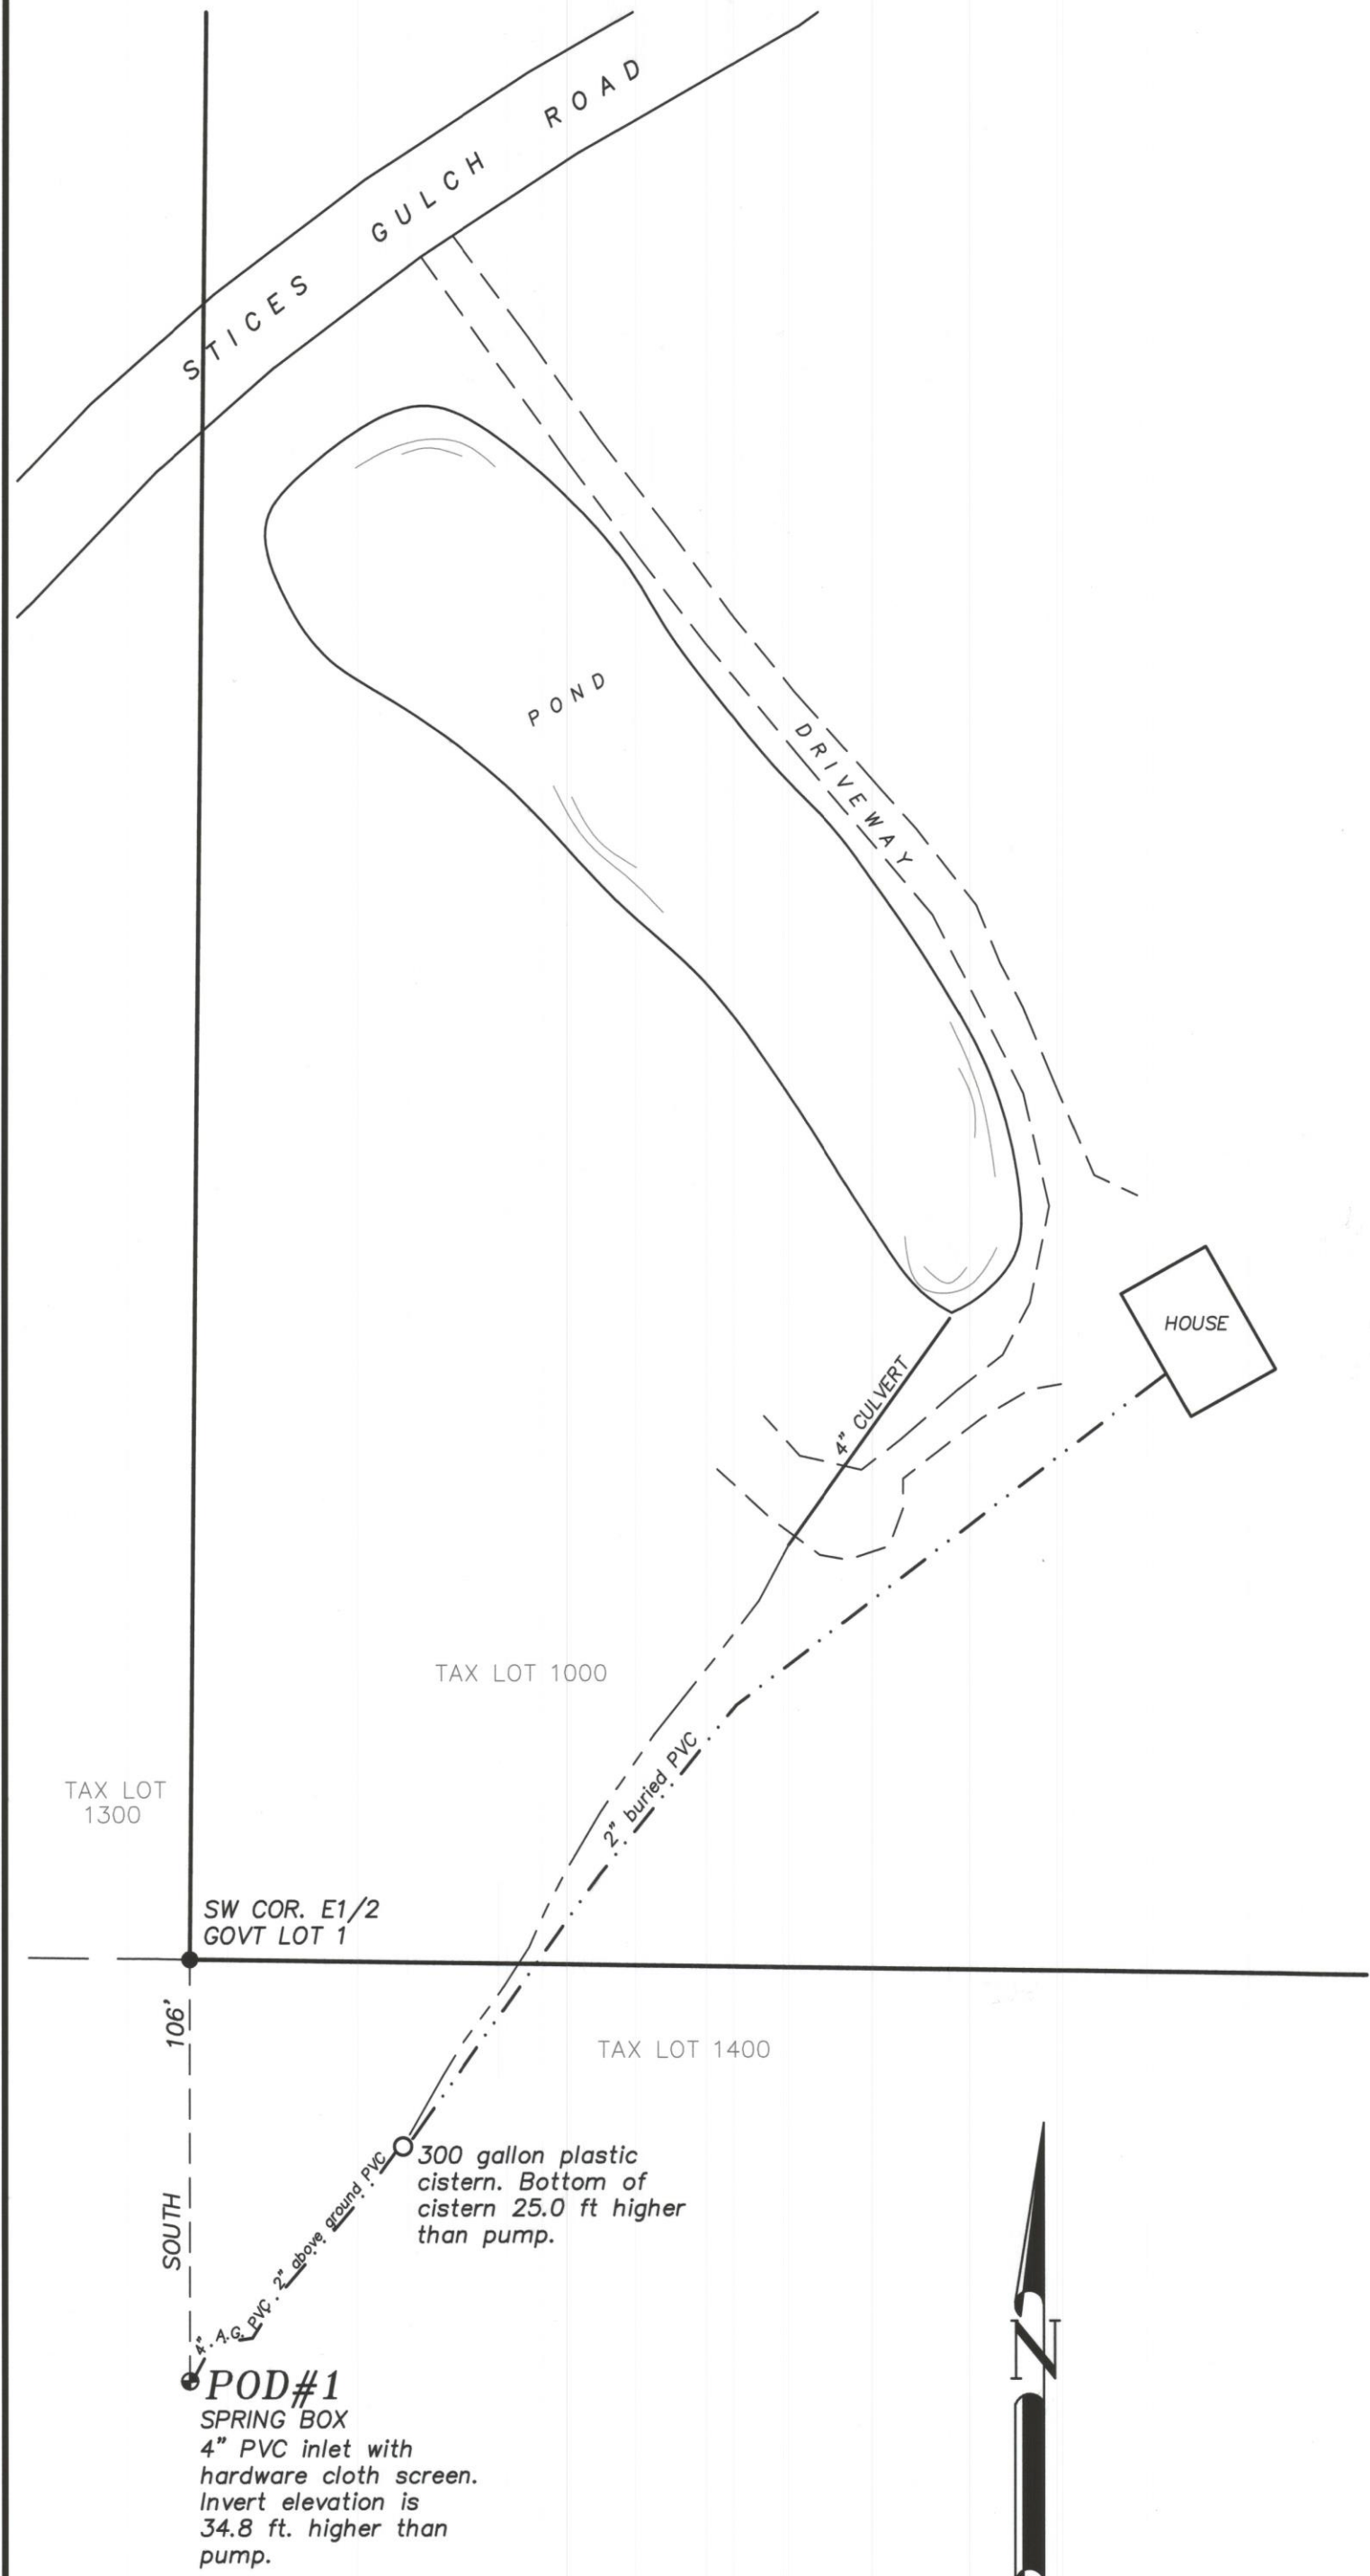

DETAIL SCALE: 1"=40'

RECEIVED
SEP 20 2022
OWRD



NOTE: The preparation of this map was for the purpose of identifying the location of proposed water rights and is not intended to provide dimensions or location of property ownership lines. Location information hereon was furnished by the applicant.

COBU MAP#2036