

Request for Assignment

OREGON



Oregon Water Resources Department
725 Summer Street NE, Suite A
Salem, Oregon 97301-1266
(503) 986-0900
www.oregon.gov/owrd

If the Department determines that the application is incomplete, fees have not been paid, or the required documents are not acceptable, the application and all fees submitted will be returned to the applicant.

If for multiple rights, a separate form and fee for each right will be required.

I, John Atkinson
(Name of Current Holder of Record)
501 Rachel Lynn Way Roseburg OR ⁹⁷⁴⁷¹ 541-580-1251
(Mailing Address) (City) (State) (Zip) (Phone #)

- hereby assign all my interest in and to the entire application/permit/transfer order/limited license/groundwater statement; (example, sold all the land authorized under the right)
- hereby assign all my interest in and to a portion of application/permit/transfer order/limited license/groundwater statement; (You must include a map showing the portion of the application/permit/transfer order/limited license/groundwater statement to be assigned. Example, sold a portion of the land authorized under the right)
- hereby assign a portion of my interest in and to the entire application/permit/transfer order/limited license/groundwater statement; (example, adding an additional person)

Application # S-85266 ; Permit # S-53937 ; Transfer Order # _____
Limited License # _____ ; Groundwater Statement # _____

as filed in the office of the Water Resources Director, to:

Patricia K. Baumgartner
(Name of New Owner)
PO Box 93 Lakeside, OR 97449 707-291-5756
(Mailing Address) (City) (State) (Zip) (Phone #)

Note: If there are other owners of the property described in the application, permit, transfer order, limited license, or groundwater statement, you must provide a list of all other owners' names and mailing addresses and attach it to this form. Write the initials (first letters) of your first and last names at the spot indicated below.

JA I hereby certify that I have notified all other owners of the property described in this application, permit, transfer order, limited license, or groundwater statement of this Request of Assignment.

Witness my hand this 29 day of Aug, 2022
(Day) (Month) (Year)

Signature of Current Holder of Record John R Atkinson

Failure to provide any of the required information will result in the return of your application.

This certifies assignment and record change at Oregon Water Resources Department effective 8:00 a.m. on date of receipt at Salem, Oregon.
Fee receipt # 158982 PS-1
For Director by Mary F. Bjork, Program Analyst in Water Rights Division. MFB

The completed "Request for Assignment" form *must* be submitted to the Department along with the recording fee of \$120.

RECEIVED

SEP 15 2022

OWRD

Part. Assign - Approve
MOB 9-19-2022

Request for Assignment

OREGON



Oregon Water Resources Department
725 Summer Street NE, Suite A
Salem, Oregon 97301-1266
(503) 986-0900
www.oregon.gov/owrd

If the Department determines that the application is incomplete, fees have not been paid, or the required documents are not acceptable, the application and all fees submitted will be returned to the applicant.

If for multiple rights, a separate form and fee for each right will be required.

I, Tui Peleti TL 500
(Name of Current Holder of Record)
8 Camino Barcelona Pl Henderson, NV 89011 949-235-6171
(Mailing Address) (City) (State) (Zip) (Phone #)

hereby assign all my interest in and to the entire application/permit/transfer order/limited license/groundwater statement; (example, sold all the land authorized under the right)

hereby assign all my interest in and to a portion of application/permit/transfer order/limited license/groundwater statement; (You must include a map showing the portion of the application/permit/transfer order/limited license/groundwater statement to be assigned. Example, sold a portion of the land authorized under the right)

hereby assign a portion of my interest in and to the entire application/permit/transfer order/limited license/groundwater statement; (example, adding an additional person)

Application # S-85266 ; Permit # S-53937 ; Transfer Order # _____;

Limited License # _____ ; Groundwater Statement # _____;

RECEIVED
AUG 24 2022
OWRD

as filed in the office of the Water Resources Director, to:

Steven G. Sogge & Linda J. Sogge
(Name of New Owner)
36230 Enterprise Rd Creswell, OR 97426 541-225-7423
(Mailing Address) (City) (State) (Zip) (Phone #)

Note: If there are other owners of the property described in the application, permit, transfer order, limited license, or groundwater statement, you must provide a list of all other owners' names and mailing addresses and attach it to this form. Write the initials (first letters) of your first and last names at the spot indicated below.

TP I hereby certify that I have notified all other owners of the property described in this application, permit, transfer order, limited license, or groundwater statement of this Request of Assignment.

Witness my hand this 20 day of August, 2022
(Day) (Month) (Year)

Signature of Current Holder of Record Tui Peleti

Failure to provide any of the required information will result in the return of your application.

Part. Assign - Approve
MJB 9-19-2022

This certifies assignment and record change at Oregon Water Resources Department effective 8:00 a.m. on date of receipt at Salem, Oregon.
Fee receipt # 138982 ps 2
For Director by Mary F. Bjork, Program Analyst in Water Rights Division. MFB


The completed "Request for Assignment" form *must* be submitted to the Department along with the recording fee of \$120.




RENEWAL DATE 12/31/2023

**T23S R12W, WM
COOS COUNTY, OR**

- POD - Spring
- Storage Tank
- Pipeline
- House
- Section
- Quarter Quarter
- Tax Lot

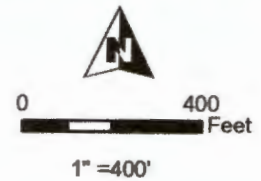

* = Peleti to Sogge Assignment
 ** = Atkinson to Baumgartner Assignment

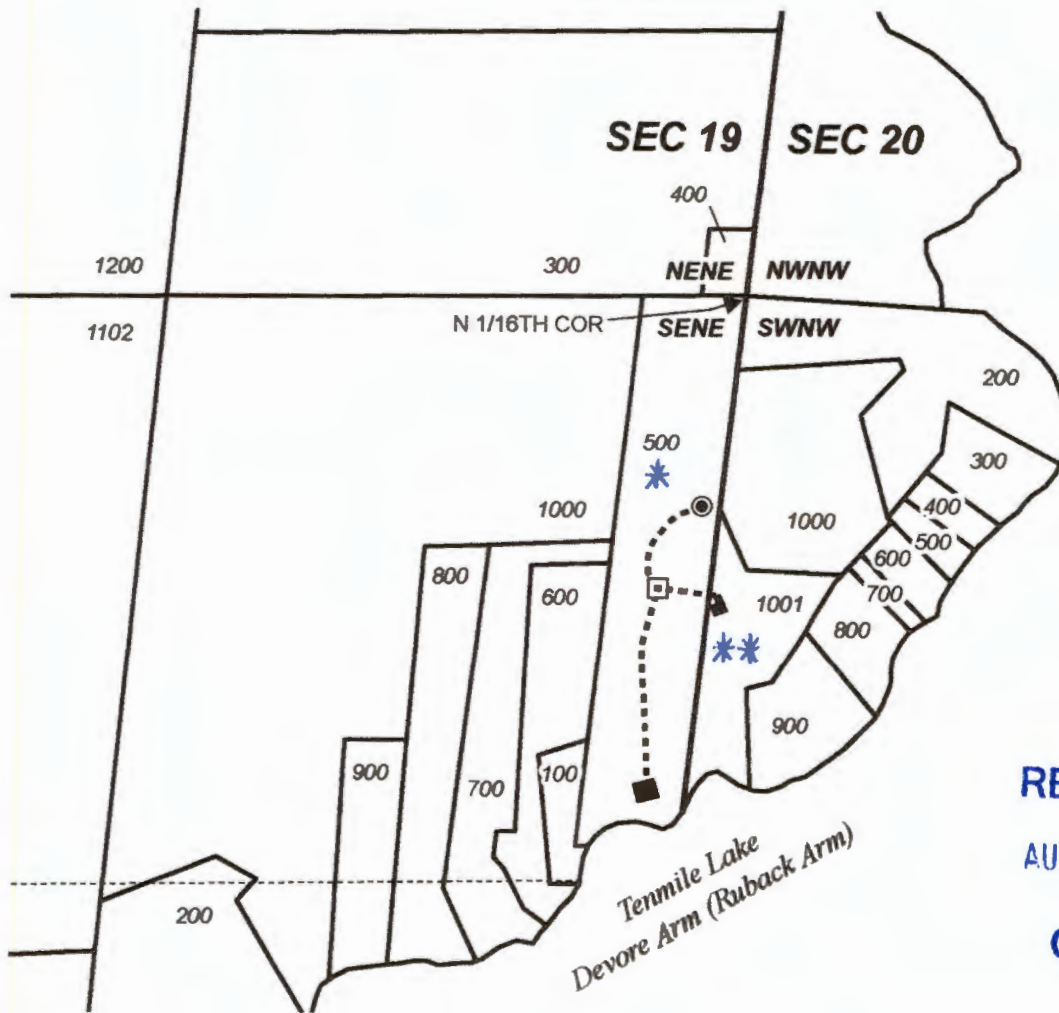

RECEIVED
 AUG 24 2022
 OWRD

POD Location:
 470' S, 100' W of N 1/16th Cor
 Common to Section 19 & 20



Date: 7/16/2022

**Claim of Beneficial Use Map
 Peleti**

Ap S-85266 Permit S-53937

Project #22018

This map is not intended to provide legal dimensions or locations of property ownership lines.

WATER RIGHT SERVICES, LLC
 PO BOX 1830, BEND, OR 97709
 WWW.OREGONWATER.US CCB # 197121
 johnshort@usa.com 541-389-2837