

SW COR.
DLC 49


RECEIVED

AUG 14 1995

RECEIVED



SCALE: 1"=400'

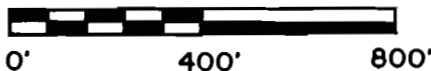

REPSLEGER ROAD

CALICO CREEK

EX.
HOUSE

1/4 LINE

480'

PROPOSED
OUTFALL

530'

PROPOSED
INTAKE STRUCTURE
(POINT OF
DIVERSION)

PROPOSED
POND

1/16 LINE


1/16 LINE

CREEK
(INTERMITTENT)

NE 1/4, SE 1/4

SECTION LINE

N 21°57' W 2260'

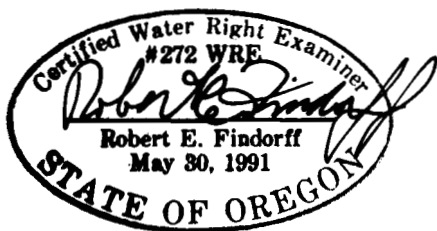

Revised 8/15/95 to correct
R4W. R.E.F.

WATER RIGHTS
SURVEY FOR
STEVEN & VERA KILSTON
NE 1/4, SE 1/4, SEC. 23,
T20S, R4W, W.M.,
LANE COUNTY, OR
T.L. 20-04-23-1500

Geomax
OF OREGON, INC.

ENGINEERING, LAND SURVEYING, BUILDING DESIGN
806 N. NINTH STREET COTTAGE GROVE, OREGON 97424
TELEPHONE: (503) 942-0126 FAX: (503) 942-7935

THIS MAP IS FOR THE PURPOSE OF IDENTIFYING
THE WATER RIGHT ONLY AND IS NOT TO
PROVIDE LEGAL DIMENSIONS OR LOCATIONS OF
PROPERTY OWNERSHIP LINES.

23 24
26 25

Application No. R-74213
Permit No.

JOB NO. 92183
DRAWN: T.F.J. CHECKED: R.E.F.
9/10/93