


Claim of Beneficial Use

Application G-13868, Permit G-13083 (PA T-9455)

Red Hills Farm LLC

Township 4S, Range 3W, W.M.

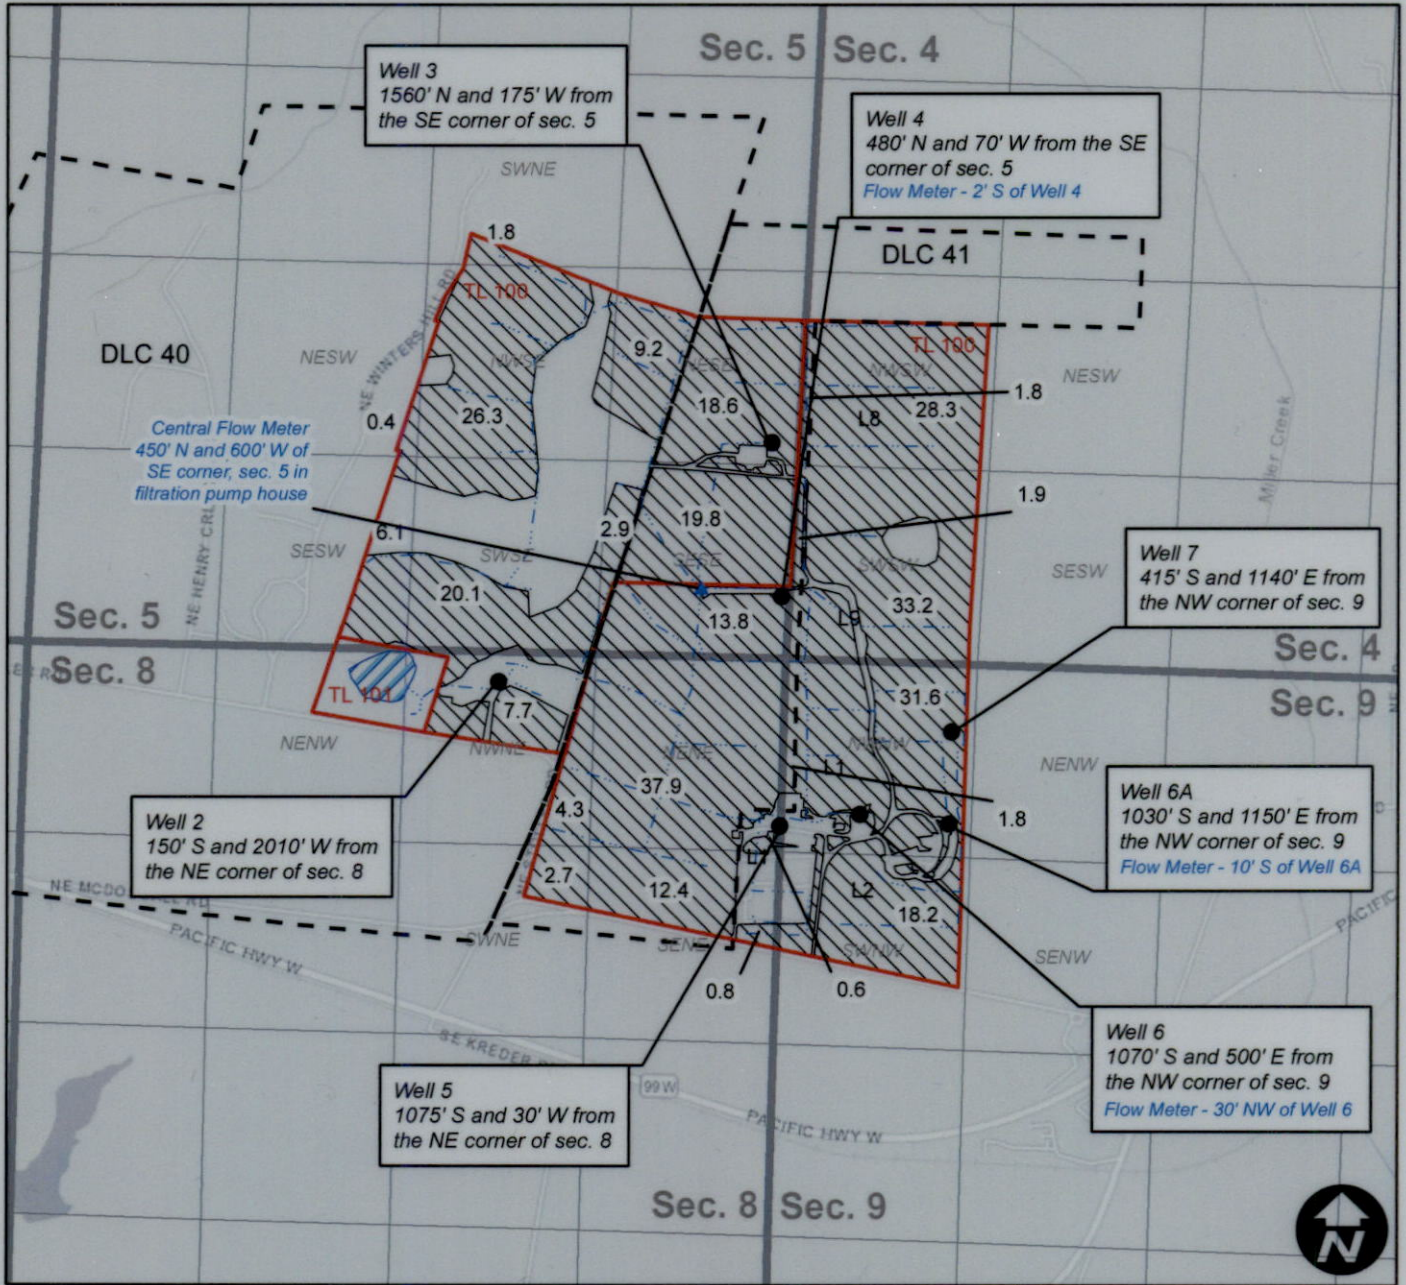

This map is not intended to provide legal dimensions or locations of property ownership lines.

Legend

- POU (302.2 ac.)
- Tax Lot
- Stoller Reservoir
- DLC
- Mainline

0 660 1,320 2,640 Feet



EXPIRES: 12-31-2022