

THIS MAP WAS PREPARED FOR
ASSESSMENT PURPOSE ONLY

SECTION 33 T.11S. R.6W. W.M.


BENTON COUNTY

0 200 400 800 Feet

11 6 3

4/27/2018

Cancelled No:
300
200
1400

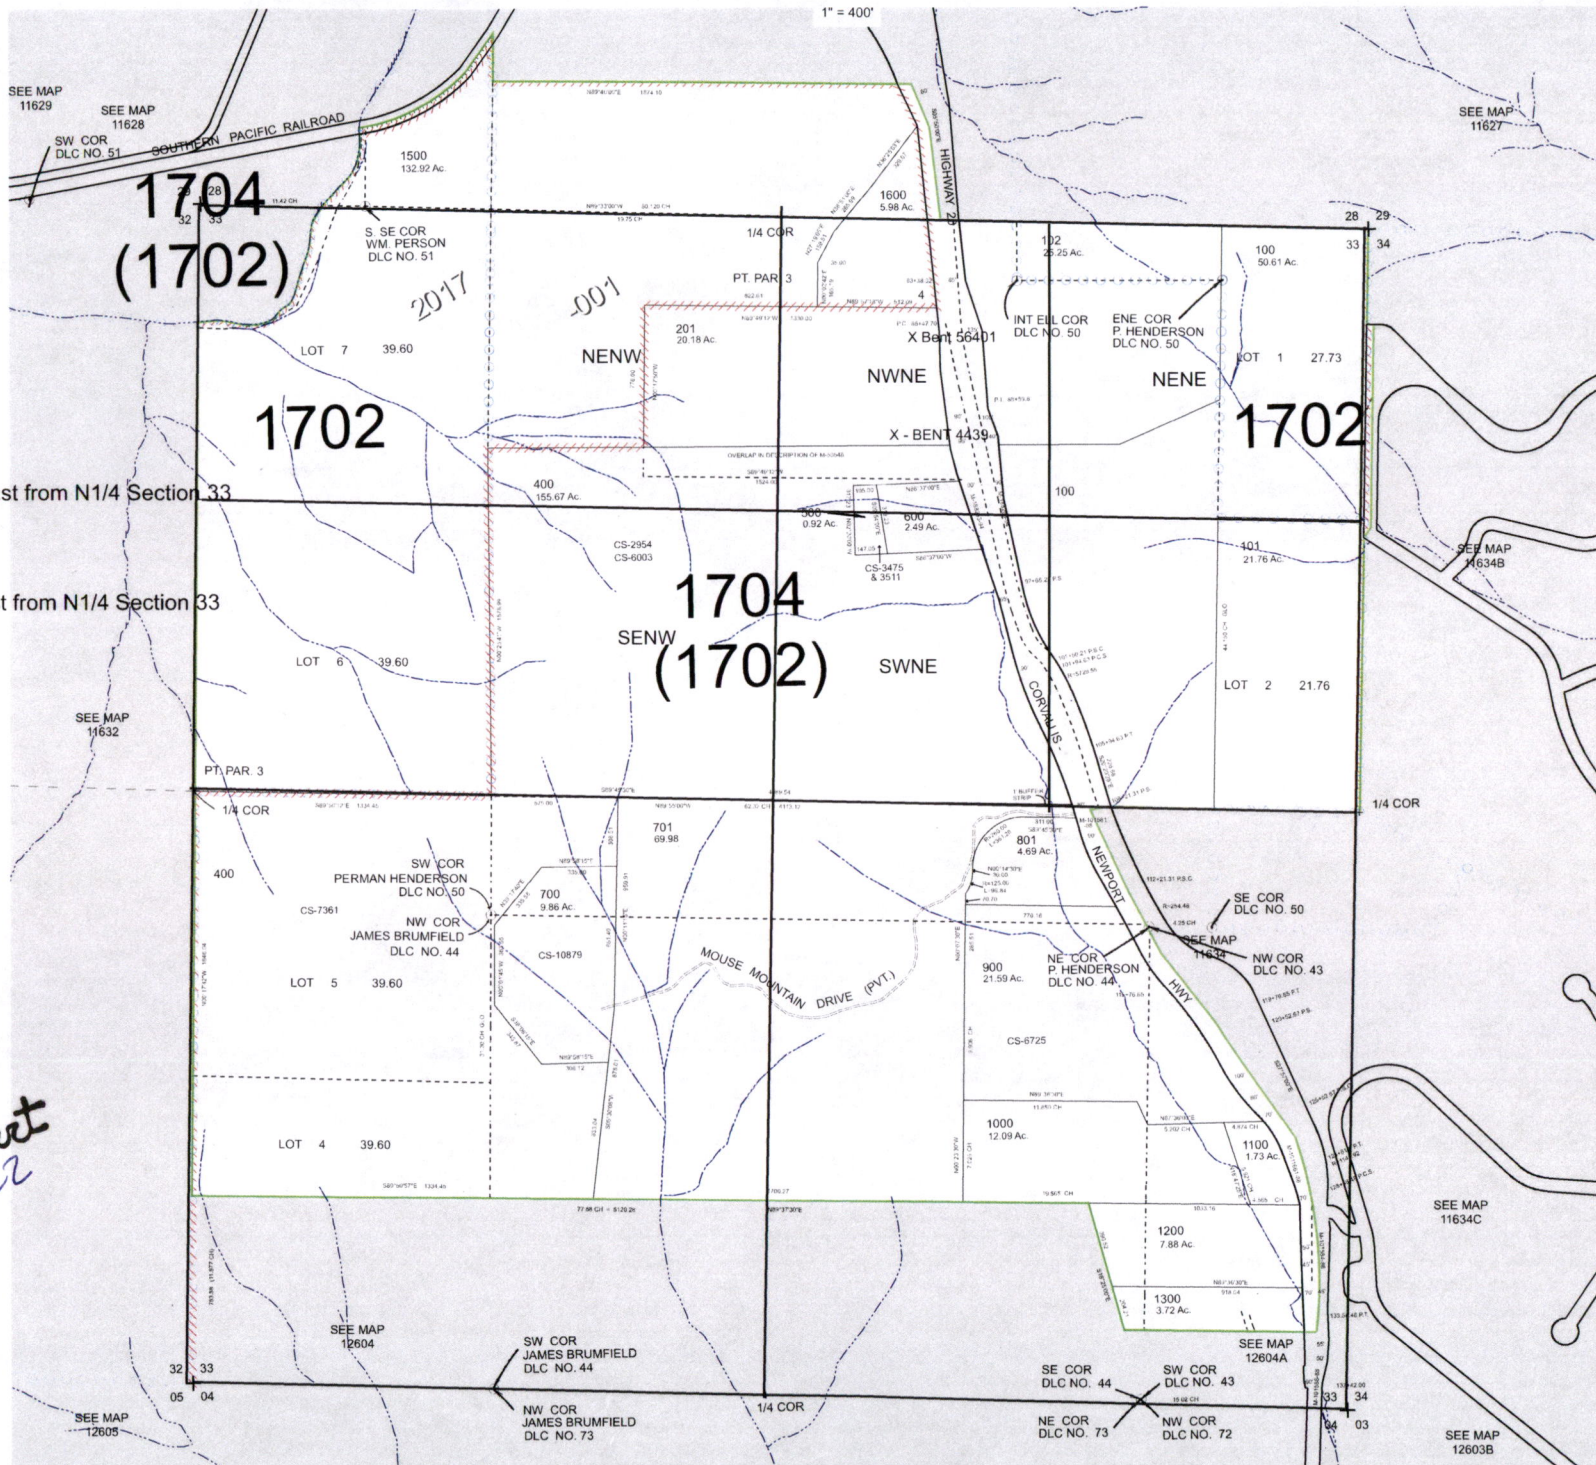

BENT 56401 - 450 South & 610 East from N1/4 Section 33

BENT 4439 900 South & 480 East from N1/4 Section 33

X - BENT 56401

X - BENT 4439

Place of Use Tax Lot 201 and 400
NWNE, NENW

Levi Beekart
9-20-2022

11 6 3: