


Claim of Beneficial Use

Application S-85624, Permit S-54076

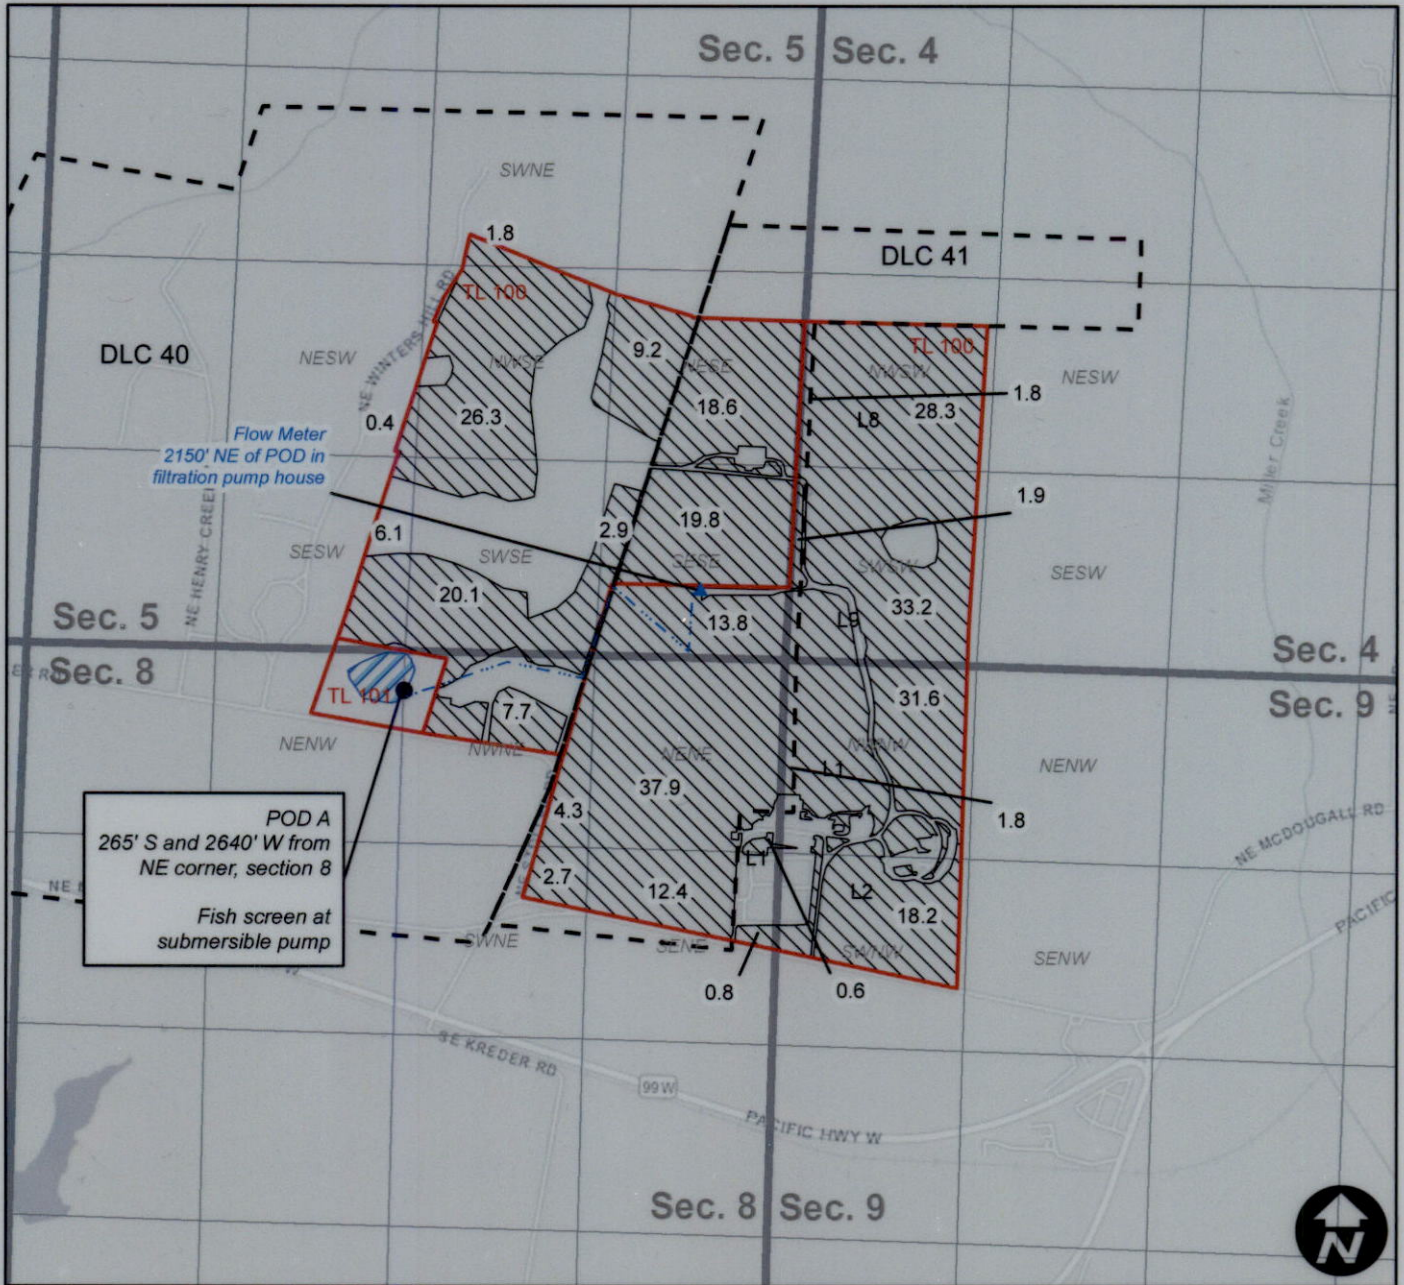


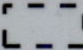

Red Hills Farm LLC

Township 4S, Range 3W, W.M.



This map is not intended to provide legal dimensions or locations of property ownership lines.

Legend

-  POU (302.2 ac.)
-  Tax Lot
-  Stoller Reservoir
-  DLC
-  Mainline

0 660 1,320 2,640 Feet



EXPIRES: 12-31-2022