Claim of Beneficial Use
Application G-16016, Permit G-15661/G-18706 (PA T-13630)
Red Hills Farm LLC

Township 4S, Range 3W, W.M.

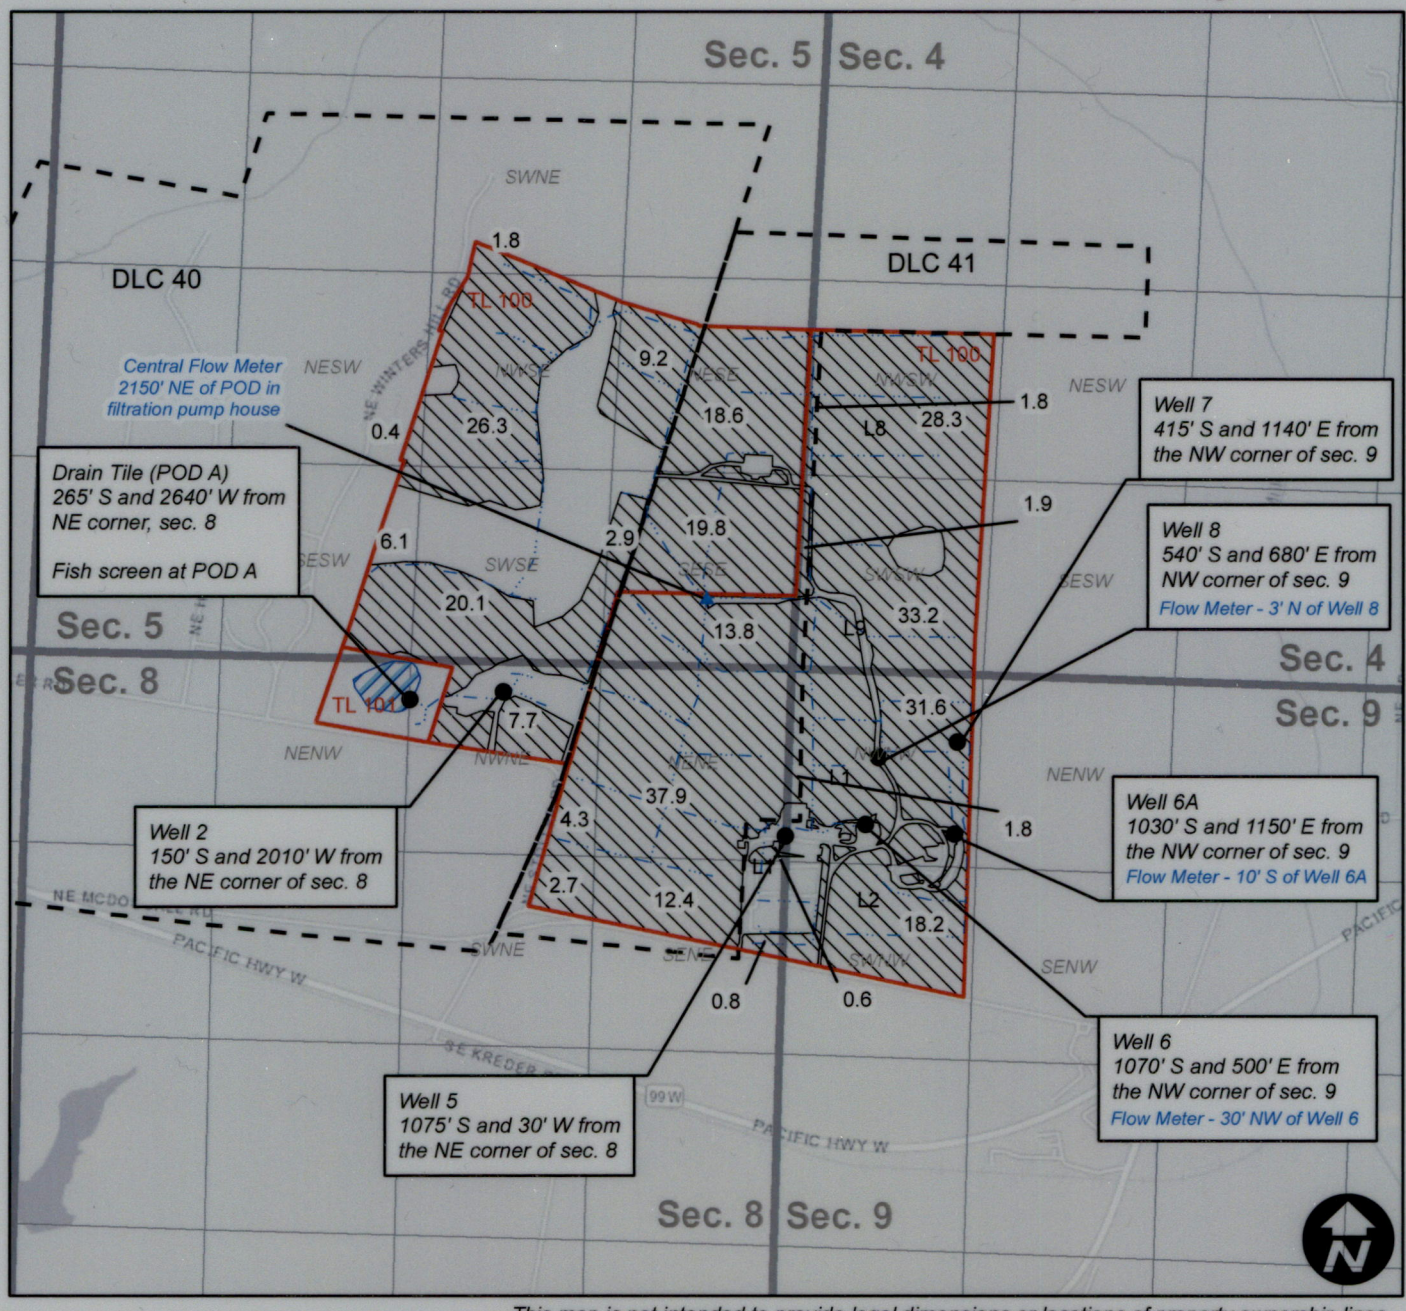

This map is not intended to provide legal dimensions or locations of property ownership lines.

0 660 1,320 2,640 Feet

Legend

- POU (302.2 ac.)
- Tax Lot
- Stoller Reservoir
- DLC
- Mainline

RECEIVED
SEP 30 2022
OWRD

CERTIFIED WATER RIGHT EXAMINER
30680
William E. McGill
WILLIAM E. McGILL
MAY 3, 2011
STATE OF OREGON
EXPIRES: 12-31-2022

WILL MCGILL SURVEYING LLC