


SCALE 1:6000



RECEIVED
JUN 26 1992

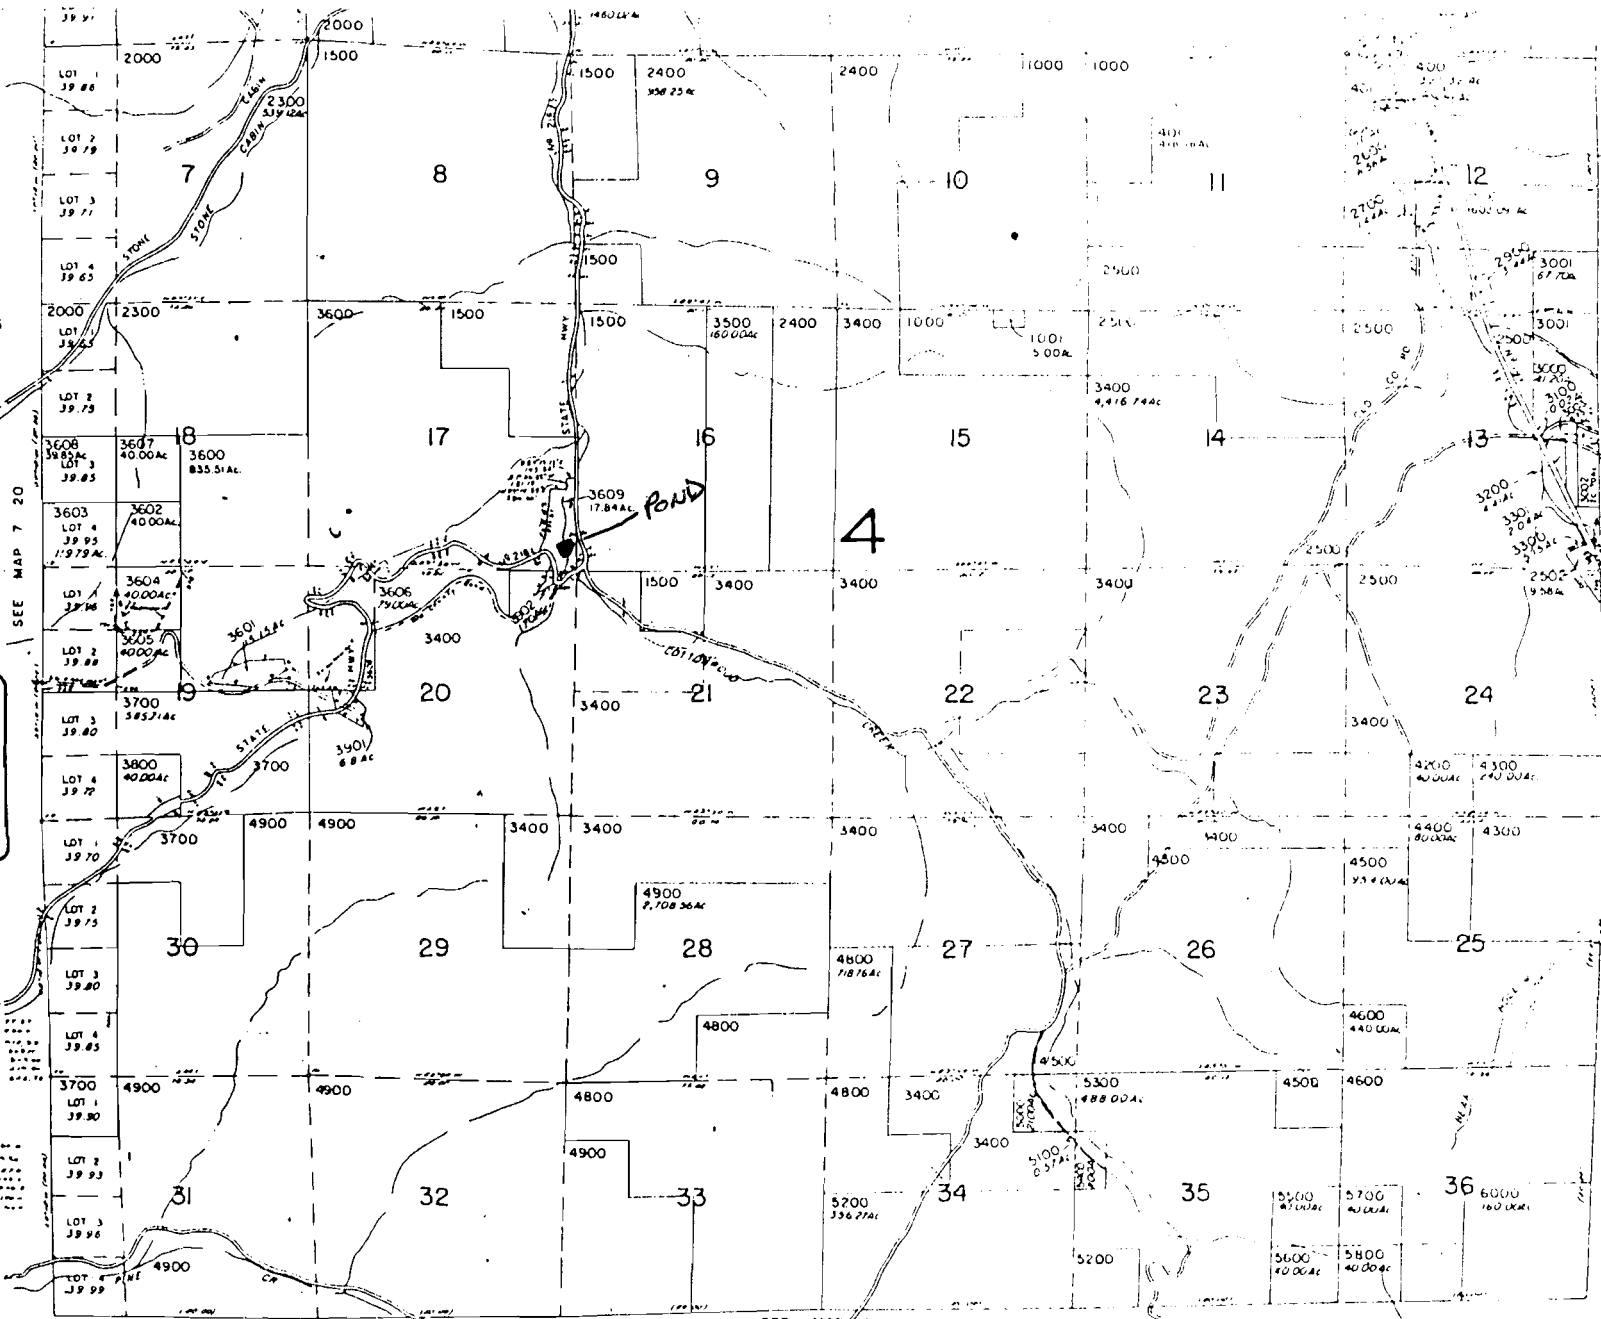

SEE MAP 8 21

Ted
WHEELER
7 21


P-14199

JUN 30 1994
ZD RES