
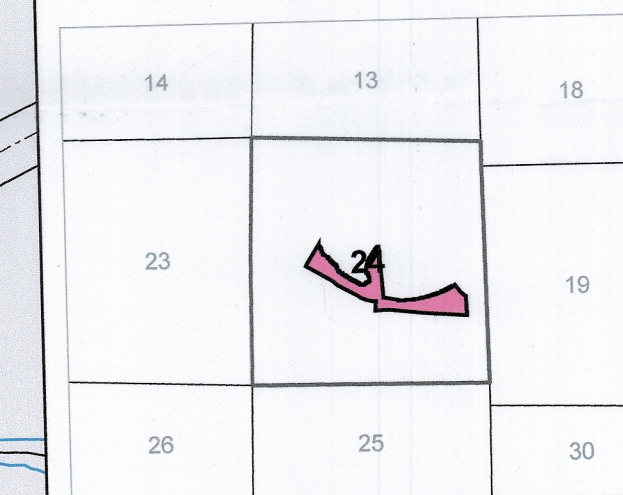
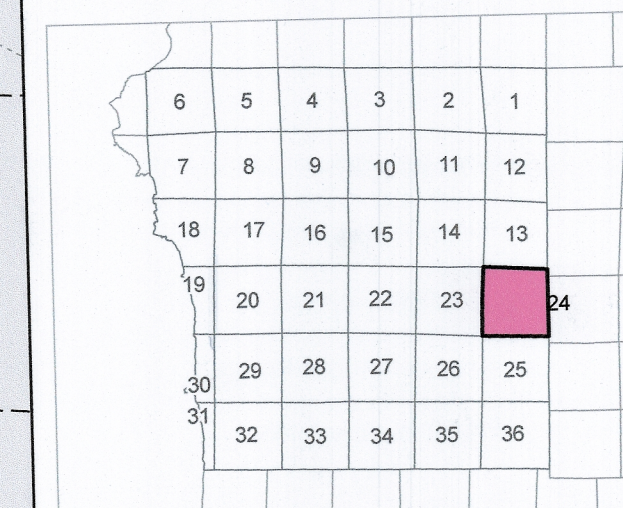


Scale 1:2,400

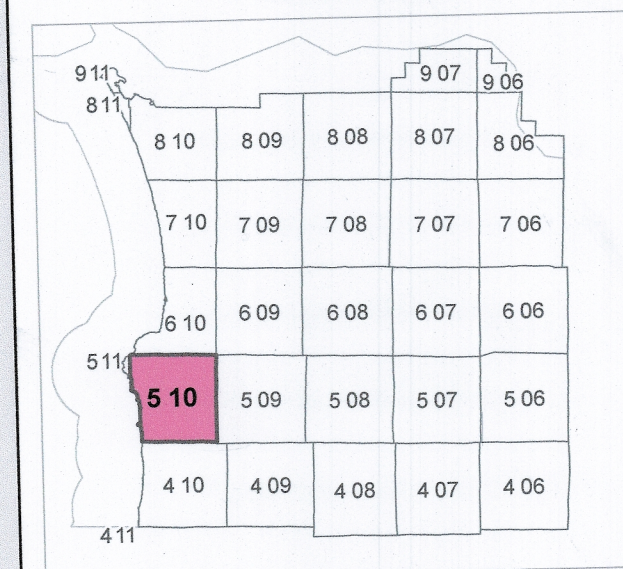

CANCELLED TAXLOT NUMBERS

301	401	900
-----	-----	-----

RECEIVED


OCT 03 2022

ONRD

FOR ADDITIONAL MAPS VISIT OUR WEBSITE AT
www.co.clatsop.or.us

This map was produced using Clatsop County GIS data. The data is maintained by Clatsop County to support its governmental activities. Clatsop County is not responsible for any map errors, possible misuse, or misinterpretation.

PLOT DATE: 10/30/2019

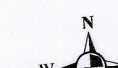

10-02
10-03
10-02

SEE MAP 5 10 24B
SEE MAP 5 10

NO. 26

SUNSET

RIVER

HIGHWAY

NO. 26
PARTITION
PLAT
1991-016

10-02
1991-016

Parcel 1
700
13.16 AC.

Parcel 2
780
0.18 AC.

Parcel 3
500
1.08 AC.

Parcel 4
400
1.38 AC.

Parcel 5
300
1.33 AC.

Parcel 6
200
1.81 AC.

Parcel 7
100
2.24 AC.

650'

172'

105'

182'

Center Section 24

Division Point

NE 1/4 of SW 1/4 of section 24 T5N Range 10W 6M

105' from Hwy 26 centerline to diversion point on Mill Creek
172' from east property line of lot 500
650' South from center of section 24

182' from SE corner of lot 500 to
1/4 Corn Section 24
T5N R 10W 6M