


RECEIVED

OCT 14 2022

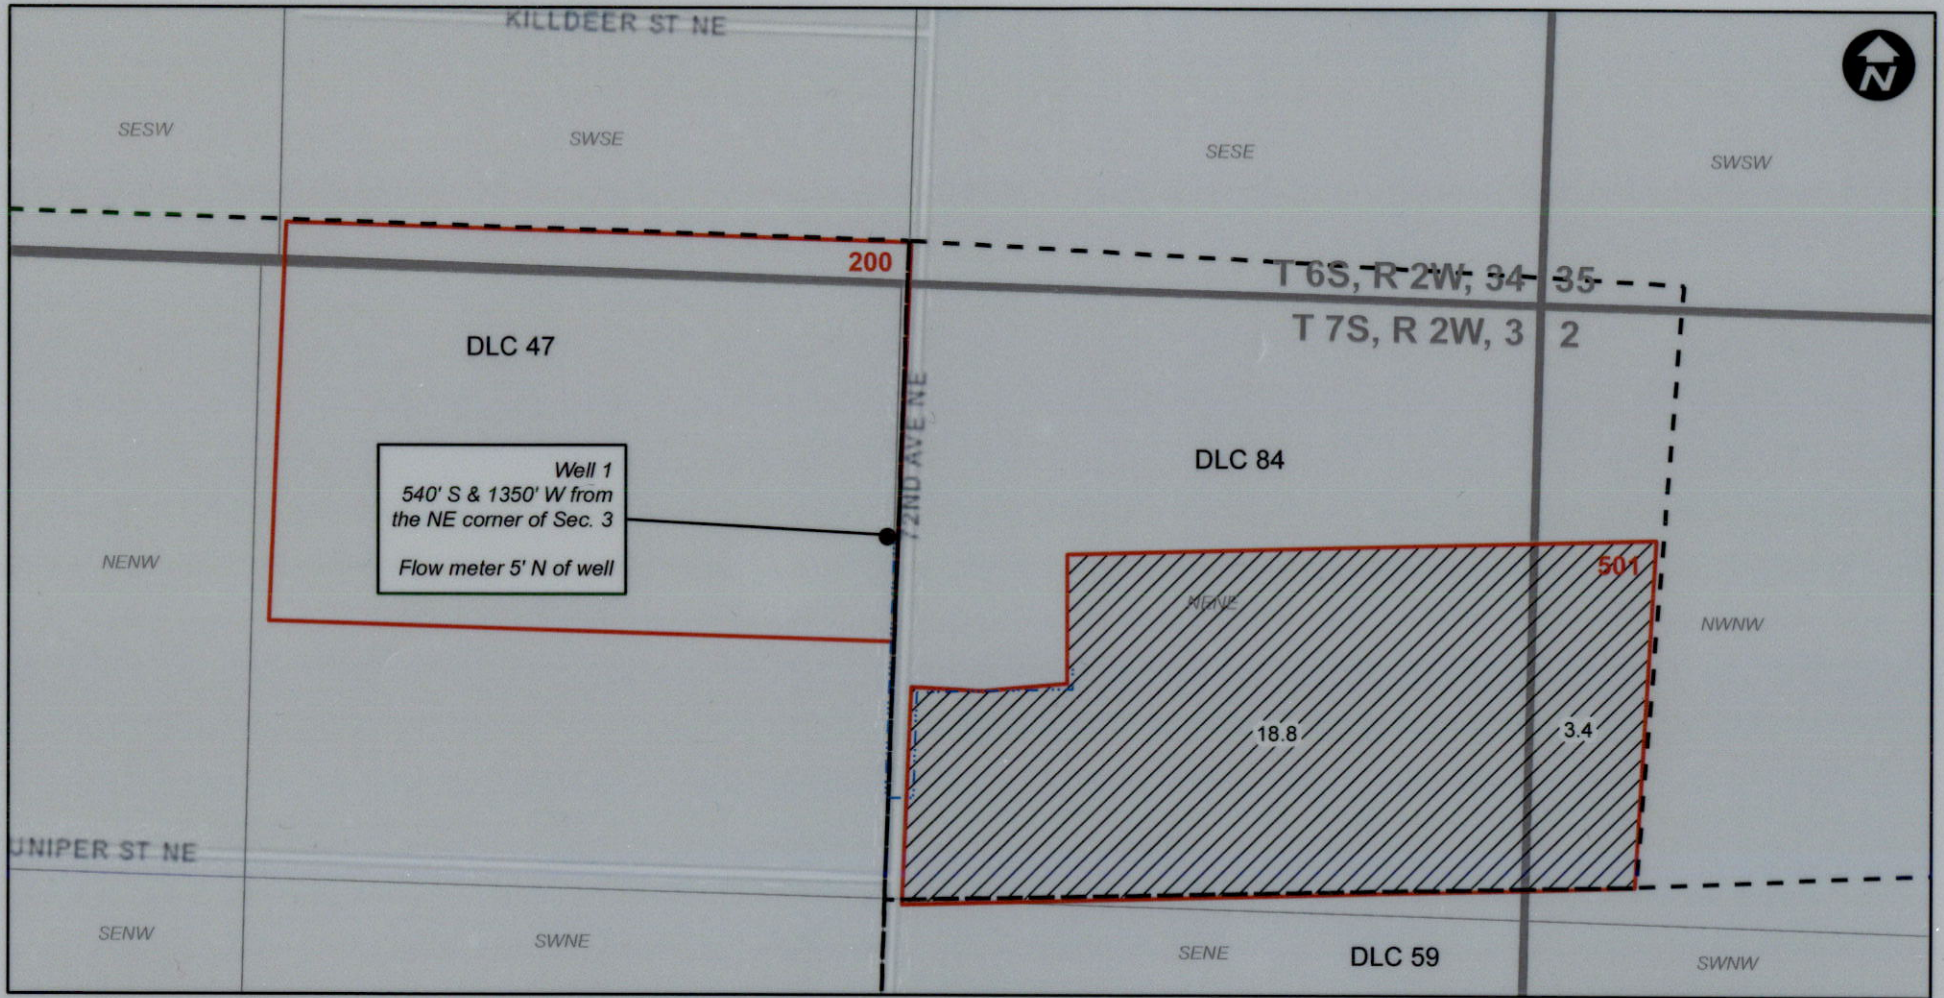



OWRD


Claim of Beneficial Use Transfer T-11523 - Ditchen Berry Company, LLC



This map is not intended to provide legal dimensions or locations of property ownership lines.

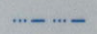Legend

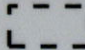-  Mainline
-  Tax Lots
-  T-11523 POU (New POA)
-  DLC

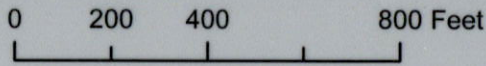

EXPIRES: 12-31-2022