

RECEIVED

OCT 17 2022

OWRD



Oregon Water Resources Department
725 Summer Street NE, Suite A
Salem, Oregon 97301
(503) 986-0900
www.wrd.state.or.us

Ownership Update
For Certificated Rights
Only

NO FEES ARE REQUIRED TO SUBMIT THIS FORM

NOTICE: A certificate of water right typically stays with the land. In order to track water right ownership, the Department requests that this form be submitted to the Department. To update multiple rights, a separate form is required for each right.

If you have any questions about this form, please contact your local watermaster, or call the Water Resources Department at (503) 986-0900.

This form is not for Applications, Permits, Transfers, Groundwater Registrations, or Limited Licenses. To notify the Department of changes in ownership to these types of authorizations, an Assignment is required.

Current Landowner Information

Name: MICHELLE A FLOYD
Mailing Address: 208 BRAMBLE WAY
City: ROSEBURG State: OR Zip: 97410
Phone (Home): Work: Other:

Property Description

County: DOUGLAS Township: 27S Range: R-4W Section: 21
Taxlot Number(s): 1300, 400, 1400
Street Address of water right property: 208 BRAMBLE WAY, ROSEBURG OR 97410
Water Right Information: Application: - 31855 Permit: - 28301 Certificate #: 35827

Are all the lands associated with this water right owned by the requester? Yes [checked] No [] If No, include a map showing the portion of the right involved.

Name of individual completing this form: MICHELLE A FLOYD Phone: (714) 679-3395
Signature of requestor: [Signature] Date: 10-8-22

The Department does not change names on certificates. This form will be placed in the file for future reference only. The Department does not provide acknowledgement that this form has been received.

Abstract of Permit No. 28361

Application No. 37855 Certificate No. 35827

Name Jay K. Hovey & Sally Hovey
 Address Idleyld Route, Box 485 F
 Roseburg, Oregon

Source of water supply North Fork of Deer Creek, trib. South Umpqua River

Use Irrigation

Point of diversion 520' N. & 1000' W. from SE cor. Cox DLC 44, being within NE $\frac{1}{4}$ SW $\frac{1}{4}$, as projected within Cox DLC 44, Sec. 21, T. 27 S., R. 4 W., W. M., county of Douglas

Number of acres 1.6

673-6774

DESCRIPTION OF LAND TO BE IRRIGATED OR PLACE OF USE

Twp.	Range	Sec.	NE $\frac{1}{4}$				NW $\frac{1}{4}$				SW $\frac{1}{4}$				SE $\frac{1}{4}$				
			NE $\frac{1}{4}$	NW $\frac{1}{4}$	SW $\frac{1}{4}$	SE $\frac{1}{4}$	NE $\frac{1}{4}$	NW $\frac{1}{4}$	SW $\frac{1}{4}$	SE $\frac{1}{4}$	NE $\frac{1}{4}$	NW $\frac{1}{4}$	SW $\frac{1}{4}$	SE $\frac{1}{4}$	NE $\frac{1}{4}$	NW $\frac{1}{4}$	SW $\frac{1}{4}$	SE $\frac{1}{4}$	
27S	4W	21									1.6								
As projected within Cox DLC 44																			
RECEIVED																			
OCT 17 2022																			
OWRD																			

Priority date July 27, 1962

Amount of water 0.02 c.f.s.

Time limit to begin construction

Time limit to complete construction extended to extended to

Time limit to completely apply water extended to extended to


Remarks: The amount of water used for irrigation, together with the amount secured under any other right existing for the same lands, shall be limited to one-eightieth of one cubic foot per second per acre, or its equivalent for each acre irrigated and shall be further limited to a diversion of not to exceed 2 $\frac{1}{2}$ acre feet per acre for each acre irrigated during the irrigation season of each year; provided further that the right to use water for irrigation shall be limited to the period when the flow of the South Umpqua River is more than 60 c.f.s. at its mouth, and shall conform to such reasonable rotation system as may be ordered by the proper state officer.

mor

Basin 16, Vol. 1

APPLICATION
MAP ON FILE

T. 27 S. R. 4 W. W.M.

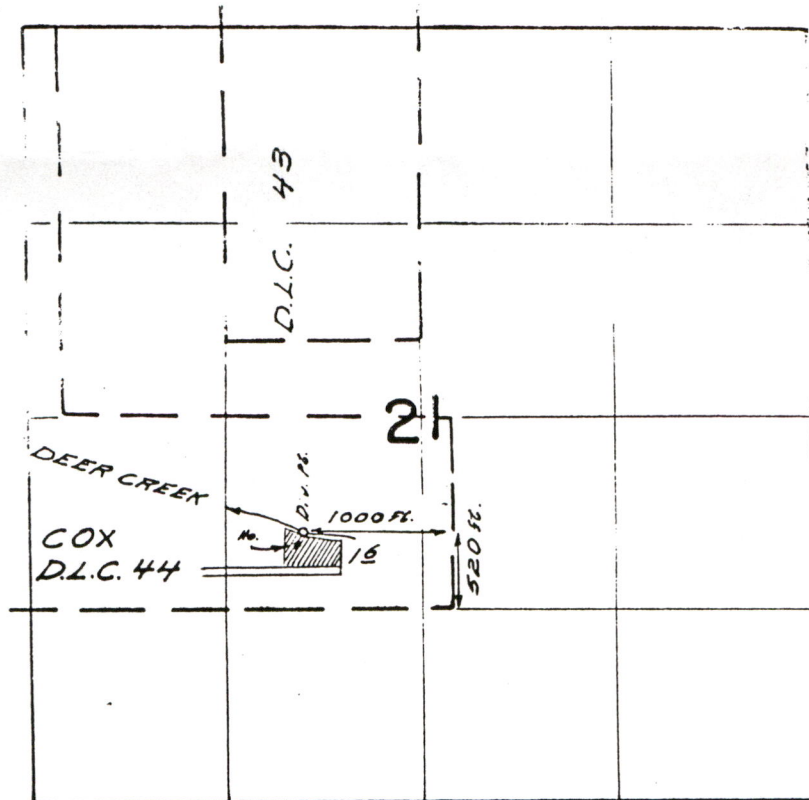

RECEIVED

OCT 17 2022

OWRD

FINAL PROOF SURVEY
UNDER

Application No. 37855 Permit No. 28361
IN NAME OF

Jay K. & Sally Hovey

Surveyed April 17 1967, by W.D. Ruppert
June 27, 1968