

**CLAIM OF
BENEFICIAL USE
for Transfer with Multiple
Changes - Groundwater**



Oregon Water Resources Department
725 Summer Street NE, Suite A
Salem, Oregon 97301-1266
(503) 986-0900
www.oregon.gov/OWRD

RECEIVED

OCT 17 2022

OWRD

A fee of \$230 must accompany this form for any Transfer final orders including a water right with a priority date of July 9, 1987, or later.

Example – A transfer involves 5 rights and one of the rights has a priority date of July 9, 1987, or later, the fee is required.

A separate form shall be completed for each transfer.

This form is subject to revision. **Begin each new claim** by checking for a new version of this form at: <https://www.oregon.gov/OWRD/Forms/Pages/default.aspx>

The completion of this form is required by OAR 690-014-0100(1) and 690-014-0110(4).

Please type or print in dark ink. If this form is found to contain errors or omissions, it may be returned to you. **Every item must have a response.** If any requested information does not apply to the claim, insert "NA." **Do not delete or alter any section of this form unless directed by the form.** The Department may require the submittal of additional information from any water user or authorized agent.

"Section 7" of this form is intended to aid in the completion of this form and should not be submitted.

A claim of beneficial use includes both this report and a map. If the map is being mailed separately from this form, please include a note with this form indicating such.

If you have questions regarding the completion of this form, please call 503-979-9103.

The Department has a program that allows it to enter into a voluntary agreement with an applicant for expedited services. Under such an agreement, the applicant pays the cost to hire additional staff that would not otherwise be available. This program means a certificate may be issued in about a month. For more information on this program see:

<https://www.oregon.gov/OWRD/programs/WaterRights/RA/Pages/default.aspx>

GENERAL INFORMATION

Type of Authorized Change

This Claim is being submitted for a transfer involving multiple changes.

YES

Mark all that apply:

- 1. Change in POA(s) or Additional POA(s)
- 2. Change in Place of Use
- 3. Change in Character of Use

A separate section will be completed for each type of change authorized in the transfer final order.

1. File Information

APPLICATION # T-12336

2. Property Owner (current owner information)

APPLICANT/BUSINESS NAME Golden Rule Farms, Inc.		PHONE NO.	ADDITIONAL CONTACT NO.
ADDRESS PO Box 255			
CITY Christmas Valley	STATE OR	ZIP 97641	E-MAIL

If the current property owner is not the transfer holder of record, it is recommended that an assignment be filed with the Department. ***Each transfer holder of record must sign this form.***

3. Transfer holder of record (this may, or may not, be the current property owner)

TRANSFER HOLDER OF RECORD Same as above		
ADDRESS		
CITY	STATE	ZIP

4. Date of Site Inspection:

8/22/2022

5. Person(s) interviewed and description of their association with the project:

NAME	DATE	ASSOCIATION WITH THE PROJECT
Charlie Branstetter	8/22/2022	Farm Manager

6. County:

Harney

7. If any property described in the place of use of the transfer final order is excluded from this report, identify the owner of record for that property (ORS 537.230(5)):

OWNER OF RECORD NA		
ADDRESS		
CITY	STATE	ZIP

Add additional tables for owners of record as needed

RECEIVED
OCT 17 2022
OWRD

**SECTION 2
SIGNATURES**

CWRE Statement, Seal and Signature

The facts contained in this Claim of Beneficial Use are true and correct to the best of my knowledge.



CWRE NAME Scott D Montgomery		PHONE NO. 541-548-5833	ADDITIONAL CONTACT NO. 541-420-0401
ADDRESS PO Box 767			
CITY Terrebonne	STATE OR	ZIP 97760	E-MAIL scott@apeands.com

Transfer Holder of Record Signature or Acknowledgement

Each transfer holder of record must sign this form in the space provided below.

The facts contained in this Claim of Beneficial Use are true and correct to the best of my knowledge. I request that the Department issue a water right certificate.

SIGNATURE	PRINT OR TYPE NAME	TITLE	DATE
	Tim Puckett	President, Golden Rule Farms, Inc	10-6-22

**RECEIVED
OCT 17 2022
OWRD**

SECTION 3
Changes Made

Note: The Claim only needs to describe the changes that were authorized in the transfer final order.

Change #1

Change in POA(s) or Additional POA(s)

Did the transfer order authorize a change in the points of appropriation or additional points of appropriation? **YES**

If "NO", this Section can be deleted.

1. New or additional point of appropriation name or number:

POINT OF APPROPRIATION (POA) NAME OR NUMBER (CORRESPOND TO MAP)	WELL LOG ID # FOR ALL WORK PERFORMED ON THE WELL (IF APPLICABLE)	WELL TAG # (IF APPLICABLE)	SOURCE (IF LISTED IN TRANSFER FINAL ORDER)
Briggs 2	HARN 1460		Malheur Lake Basin

Attach each well log available for the well (include the log for the original well and any subsequent alterations, reconstructions, or deepenings)

If well logs are available, items A and B below can be deleted

2. Variations:

Was the use developed differently from what was authorized by the transfer final order, or extension final? **YES**

If yes, describe below.

(e.g. "The order allowed three new/additional points of appropriation. The water user only developed one of the points.")

The transfer authorized two wells. The water user is only using one on this transfer water right

RECEIVED
OCT 17 2022
OWRD

3. Claim Summary:

NEW OR ADDITIONAL POA NAME OR #	MAXIMUM RATE AUTHORIZED	CALCULATED THEORETICAL RATE BASED ON SYSTEM	AMOUNT OF WATER MEASURED
Briggs 2	0.39 cfs	4.01 cfs	2.01 cfs

System Description

Are there multiple new or additional Points of Appropriation (POA)?

NO

POA Name or Number this section describes (only needed if there is more than one):

Briggs 2 (HARN 1460)

RECEIVED

OCT 17 2022

A. POA System Information

OWRD

Provide the following information concerning the point of appropriation. Information provided must describe the equipment used to appropriate water from the point of appropriation.

1. Pump Information

MANUFACTURER	MODEL	SERIAL NUMBER	TYPE (CENTRIFUGAL, TURBINE OR SUBMERSIBLE)	INTAKE SIZE	DISCHARGE SIZE
Goulds	L2CMC	WC3451	Turbine	16"	8"

2. Motor Information

MANUFACTURER	HORSEPOWER
Nidec	75

3. Theoretical Pump Capacity

HORSEPOWER	OPERATING PSI	LIFT FROM SOURCE TO PUMP *IF A WELL, THE WATER LEVEL DURING PUMPING	LIFT FROM PUMP TO PLACE OF USE	TOTAL PUMP OUTPUT (IN CFS)
75	40	30'	0'	4.01

4. Provide pump calculations:

$$Q = \frac{7.04 \text{ ft}^3/\text{s}/\text{hp} \times \text{hp}}{\text{Total head, ft}} = \frac{(7.04)(75)}{131.6} = 4.01 \text{ cfs}$$

$$\text{Total head} = 101.6' + 30' + 0' = 131.6'$$

5. Measured Pump Capacity (using meter if meter was present and system was operating)

INITIAL METER READING	ENDING METER READING	DURATION OF TIME OBSERVED	TOTAL PUMP OUTPUT (IN CFS)
95376.5 gal x 1000	95382.8 gal x 1000	7 min	2.01

Reminder: For pump calculations use the reference information at the end of this document.

6. Additional notes or comments related to the system:

B. Groundwater Source Information (Well and Sump)

1. Is the appropriation from a dug well (sump)?

NO

RECEIVED

OCT 17 2022

OWRD

Change #2

Change in Place of Use

Did the transfer order authorize a change in the place of use?

YES

If "NO", this Section can be deleted.

RECEIVED

1. Claim Summary – Authorized Use:

If Irrigation or Nursery Use:

OCT 17 2022

THE # OF ACRES ALLOWED	THE # OF ACRES DEVELOPED
31.0	31.0

OWRD

If the new use(s) was not irrigation or nursery:

NEW USE(S)	WAS THE NEW PLACE OF USE DEVELOPED TO THE FULL EXTENT AUTHORIZED UNDER THE ORDER? (INCLUDE THE LOCATION OF THE DEVELOPED PLACE USE ON THE CLAIM MAP)
	NA

2. Variations:

Was the use developed differently from what was authorized by the transfer final order?

No

If yes, describe below.

(e.g. "The order authorized a change in place of use for 40 acres. The water user only developed 38 acres.")

Change #3

Change in Character of Use

Did the transfer order authorize a change in character of use?

NO

RECEIVED

OCT 17 2022

OWRD

**SECTION 4
CONDITIONS**



All conditions contained in the transfer final order, or any extension final order shall be addressed. Reports that do not address all performance related conditions will be returned.

1. Time Limits:

Describe how the water user has complied with each of the development timelines established in the transfer final order and any extensions of time issued for the transfer:

	DATE FROM TRANSFER	DATE THE AUTHORIZED CHANGES WERE COMPLETED *THIS DATE MUST FALL BETWEEN THE "ISSUANCE DATE" AND THE "COMPLETENESS DATE"
ISSUANCE DATE	01/31/17	
COMPLETENESS DATE FROM ORDER (C)	10/01/22	08/22/22

* MUST BE WITHIN PERIOD BETWEEN TRANSFER FINAL ORDER, OR ANY EXTENSION FINAL ORDER ISSUANCE AND THE DATE TO COMPLETE THE CHANGE

2. Is there an extension final order(s)? **NO**

3. Measurement Conditions:

a. Does the transfer final order, or any extension final order require the installation of a meter or other approved measuring device? **YES**

b. Has a meter been installed? **YES**

c. Meter Information

POA NAME OR #	MANUFACTURER	SERIAL #	CONDITION (WORKING OR NOT)	CURRENT METER READING	DATE INSTALLED
Briggs #2	Lindsay Growsmart	IM 3000	Running	95382.8 gal x 1000	Spring 2022

4. Recording and reporting conditions

a. Is the water user required to report the water use to the Department? **NO**

5. Other conditions required by the transfer final order or extension final order:

a. Were there special well construction standards? **NO**

b. Was submittal of a ground water monitoring plan required? **NO**

c. Other conditions? **NO**

If "YES" to any of the above, identify the condition and describe the water user's actions to comply with the condition(s):

The flowmeter is installed between the well & center pivot sprinkler. The meter is shared by another water right under T-12420 & POU is located east of well. Only one system can operate at a time & recording the flowmeter reading each time the system is changed is necessary to keep track of use.

SECTION 5
ATTACHMENTS

Provide a list of any additional documents you are attaching to this report:

ATTACHMENT NAME	DESCRIPTION
Well log	HARN 1460
Site photos	Time & location stamped photos of irrigation system & place of use

RECEIVED

OCT 17 2022

OWRD

SECTION 6

CLAIM OF BENEFICIAL USE MAP

The Claim of Beneficial Use Map must be submitted with this claim. Claims submitted without the Claim of Beneficial Use map will be returned. The map shall be submitted on poly film at a scale of 1" = 1320 feet, 1" = 400 feet, or the original full-size scale of the county assessor map for the location.

The changes that were authorized under the transfer final order must be mapped based on the developed locations; new or additional points of appropriation and place of use.

In cases where the order involved additional points of appropriation, the additional points should be mapped based on their developed locations. The original points of appropriation should be mapped based on the original right of record at the time the transfer final order was issued.

In cases where the order involved changing the place of use for a portion of a water right, the portion of the place of use being changed should be mapped based on the developed location. If the transfer also included portions of the place of use that were not being modified, but were receiving a new or additional point of appropriation, the place of use for those lands should be mapped based on the original right of record at the time the transfer final order was issued.

Provide a general description of the survey method used to prepare the map. Examples of possible methods include, but are not limited to, a traverse survey, GPS, or the use of aerial photos. If the basis of the survey is an aerial photo, provide the source, date, series and the aerial photo identification number.

The irrigation system & place of use were tied to approximate boundaries using a Trimble GeoXT 6000 GIS data collector. Point data was imported into Trimble Path Finder software and converted to statewide Lambert Projection. Point data was compared with recent aerial imagery for accuracy.

RECEIVED

OCT 17 2022

OWRD

Map Checklist

Please be sure that the map you submit includes ALL the items listed below.

(Reminder: Incomplete maps and/or claims may be returned.)

- Map on polyester film
- Appropriate scale (1" = 400 feet, 1" = 1320 feet, or the original full-size scale of the county assessor map)
- Township, Range, Section, Donation Land Claims, and Government Lots
- If irrigation, number of acres irrigated within each projected Donation Land Claims, Government Lots, Quarter-Quarters
- Locations of fish screens and/or fish by-pass devices in relationship to point of diversion
- Locations of meters and/or measuring devices in relationship to point of diversion or appropriation
- Conveyance structures illustrated (pumps, reservoirs, pipelines, ditches, etc.)
- Point(s) of diversion or appropriation (illustrated and coordinates)
- Tax lot boundaries and numbers
- Source illustrated if surface water
- Disclaimer ("This map is not intended to provide legal dimensions or locations of property ownership lines")
- Application and permit number or transfer number
- North arrow
- Legend
- CWRE stamp and signature

RECEIVED

OCT 17 2022

OWRD

OMRD

OCT 17 5055

RECEIVED

NOV 23 1988

28/312/100

STATE OF OREGON
WATER WELL REPORT
(as required by ORS 537.765)

WATER RESOURCES DEPT.
SALEM, OREGON

(START CARD) # 5237

1460
Harm

(1) OWNER:

Name Fred Briggs
Address Box 582
City Lakeview State Or. Zip _____
Well Number: BRIGGS 2

(2) TYPE OF WORK:

New Well Deepen Recondition Abandon

(3) DRILL METHOD

Rotary Air Rotary Mud Cable
 Other _____

(4) PROPOSED USE:

Domestic Community Industrial Irrigation & stock
 Thermal Injection Other _____

(5) BORE HOLE CONSTRUCTION:

Special Construction approval Yes No Depth of Completed Well 35 ft.
Yes No
Explosives used Type _____ Amount _____

HOLE			SEAL			Amount sacks or pounds
Diameter	From	To	Material	From	To	
20"	0	18'	cement	0	18'	10 sacks
16"	18	35'				

How was seal placed: Method A B C D E
 Other _____

Backfill placed from _____ ft. to _____ ft. Material _____
Gravel placed from _____ ft. to _____ ft. Size of gravel _____

(6) CASING/LINER:

Casing:	Diameter	From	To	Gauge	Steel	Plastic	Welded	Threaded
		16"	+1	25'	.250	<input checked="" type="checkbox"/>	<input type="checkbox"/>	<input checked="" type="checkbox"/>
Liner:					<input type="checkbox"/>	<input type="checkbox"/>	<input type="checkbox"/>	<input type="checkbox"/>

Final location of shoe(s) 25

(7) PERFORATIONS/SCREENS: NO

Perforations Method _____
 Screens Type _____ Material _____

From	To	Slot size	Number	Diameter	Tele/pipe size	Casing	Liner
						<input type="checkbox"/>	<input type="checkbox"/>
						<input type="checkbox"/>	<input type="checkbox"/>
(8) WELL TESTS: Minimum testing time is 1 hour

Pump Bailer Air Flowing Artesian

Yield gal/min	Drawdown	Drill stem at	Time
500	0	35'	1 hr.

Temperature of water 51 Depth Artesian Flow Found _____
Was a water analysis done? Yes By whom _____
Did any strata contain water not suitable for intended use? Too little
 Salty Muddy Odor Colored Other _____
Depth of strata: _____

(9) LOCATION OF WELL by legal description:

County Harney Latitude _____ Longitude _____
Township 27 S N or S, Range 31 E E or W, WM.
Section 1 NW 1/4 NE 1/4
Tax Lot 100 Lot _____ Block _____ Subdivision _____
Street Address of Well (or nearest address) 35 miles S of Burns near Sodhouse-Princeton Rd at Briggs ranch

(10) STATIC WATER LEVEL:

12 ft. below land surface. Date 11-10-88
Artesian pressure _____ lb. per square inch. Date _____

(11) WATER BEARING ZONES:

Depth at which water was first found _____

From	To	Estimated Flow Rate	SWI
25	35	500	12

(12) WELL LOG:

Ground elevation 4150

Material	From	To	SWI
Soil	0	1	0
Rock, grey hard	1	25	0
Cinders, red water bearing	25	35	12

RECEIVED

OCT 17 2022

OWRD

Date started 11-7-88 Completed 11-10-88

(unbonded) Water Well Constructor Certification:

I certify that the work I performed on the construction, alteration, abandonment of this well is in compliance with Oregon well construction standards. Materials used and information reported above are true to my best knowledge and belief.

WWC Number _____
Signed _____ Date _____

(bonded) Water Well Constructor Certification:

I accept responsibility for the construction, alteration, or abandonment of work performed on this well during the construction dates reported above. My work performed during this time is in compliance with Oregon well construction standards. This report is true to the best of my knowledge and belief.

WWC Number 1254
Signed Harold Woodruff Date 11-10-88

OWRD

OCT 12 2022

RECEIVED

OCT 17 2022

OWRD

18:01 22-08-2022

Lat: 43° 15' 30.92" N Lon: 118° 48' 35.75" W

Evid. Use → Garland Acres WLR3

T-12420

OMBD

OCT 13 2022

RECEIVED

RECEIVED

OCT 17 2022

OMRD

OMARD
DELTA WASS
RECEIVED

RECEIVED

OCT 17 2022

OWRD

18:05 22-08-2022

Lat: 43° 15' 30.21" N Lon: 118° 48' 31.11" W

Evid. USE Garland Acres WRS

T-12420

OWRD

OCT 17 2022

RECEIVED

RECEIVED

OCT 17 2022

OWRD



RECEIVED
OCT 17 2022
OWRD

17:48 22-08-2022

Lat: 43° 15' 30.97" N Lon: 118° 48' 35.21" W

2011-1-#2

RECEIVED
OCT 17 2022
OMRD


+/- 1.3'

~~4117~~ 4117'

RECEIVED
OCT 17 2022
OMRD

118048' 35.15"W

4395' 31.01"N

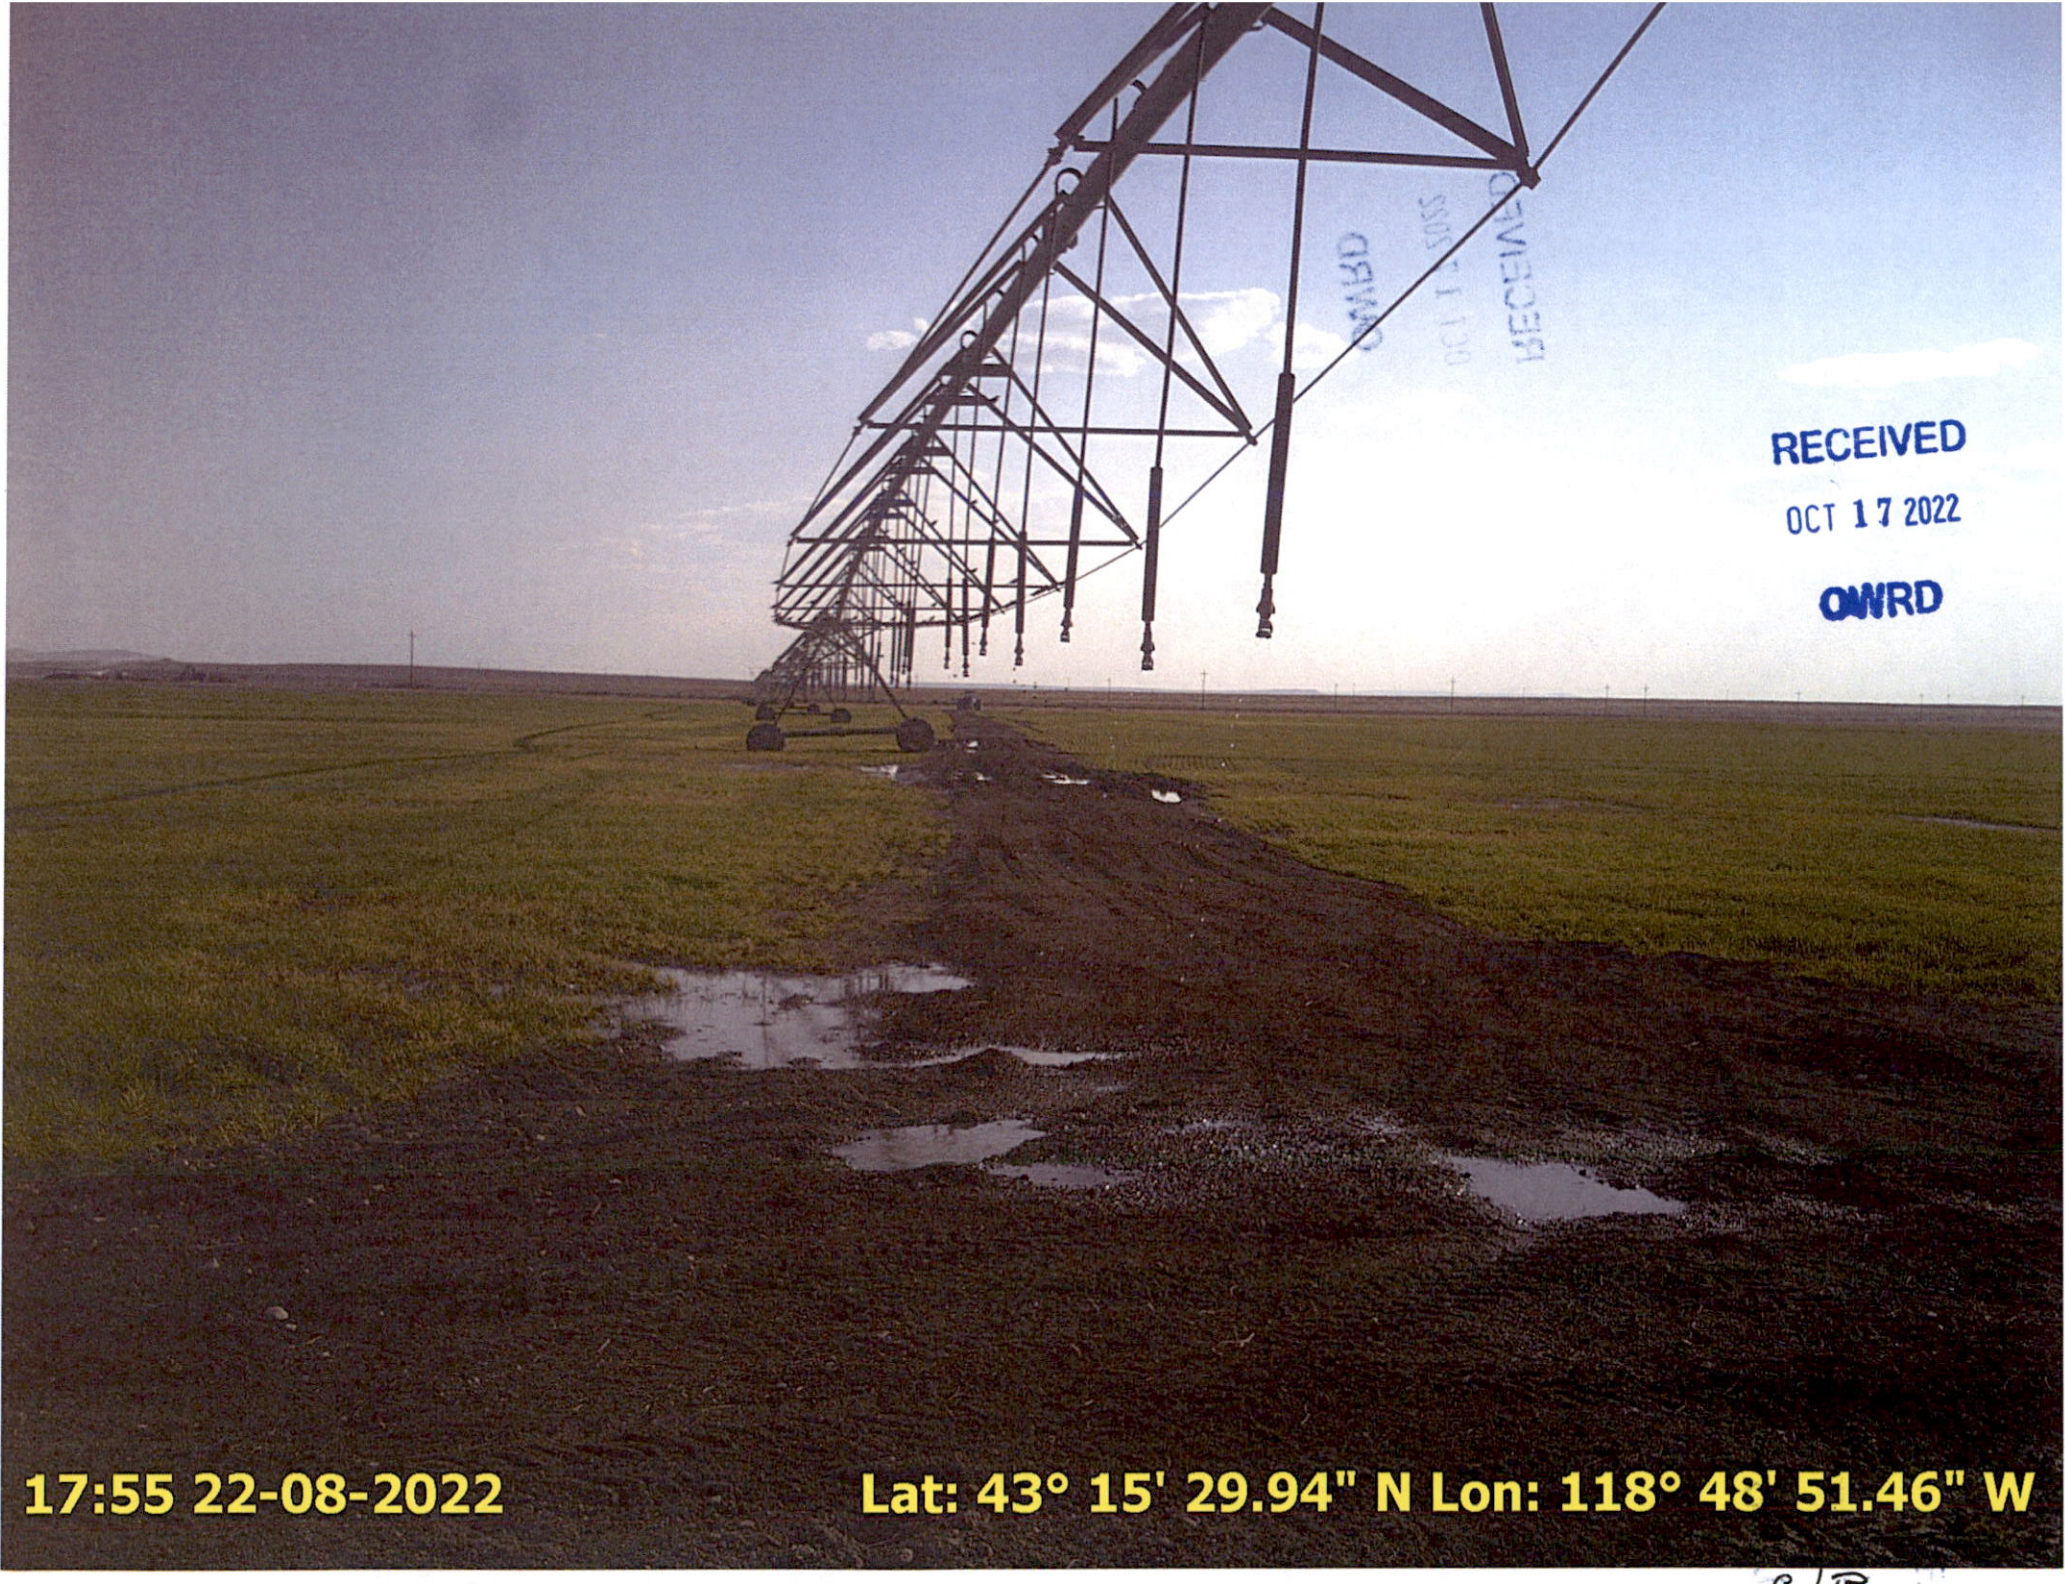

RECEIVED
OCT 17 2022
OWRD

17:55 22-08-2022

Lat: 43° 15' 29.94" N Lon: 118° 48' 51.46" W

012

RECEIVED
OCT 17 2022
OMRD

+/- 1.6'

41.67'

430'15", 29.95" N
118° 48', 51.39" W

RECEIVED
OCT 11 2022
OMRD

RECEIVED
OCT 11 2022
OMRD

Checklist for Claims of Beneficial Use Received at CSG Counter

Application #:	WRD Reviewer:Dante Luongo
Transfer #:T-12336	
Date Received:10-17-2022	
CWRE Name:Scott D Montgomery	
Priority Date (s):9-29-1983	

Fees Required:

- YES NO A fee of \$230 must accompany this form for permits with priority dates of July 9, 1987, or later.
- YES NO A fee of \$230 must accompany this form for any transfers including a water right with a priority date of July 9, 1987, or later.
 Example – A transfer involves 5 rights and one of the rights has a priority date of July 9, 1987, or later, the fee is required.

Fill in App or Transfer Number

Map Review:

- Map on polyester film (OAR 690-014-0170(1) & 310-0050(1)(b))
- Application & permit #; or transfer # (OAR 690-014-0100(1))
- Disclaimer (OAR 690-014-0170(5))
- North arrow (OAR 690-310-0050(2)(c))
- CWRE stamp and signature (OAR 690-014 & 310-0050)
- Appropriate scale (1" = 1320', 1" = 400', or the original full-size scale of the county assessor map) (014 & 310)
- Township, range, section, and tax lot numbers (OAR 690-310-0050(4))

Report Review:

- On form provided by the Department (OAR 690-014-0100(1))
- Application & permit #; or transfer # (OAR 690-014)
- Ownership information (OAR 690-014)
- Date of survey (OAR 690-014)
- Person interviewed (OAR 690-014)
- County (OAR 690-014)
- CWRE stamp and signature (OAR 690-014-0100)
- Signature(s) of all permittee of transfer holder (OAR 690-014-0100)

MONEY SLIP

DATE: _____ RECEIPT #: _____

RECEIVED FROM: _____ APPLICATION: _____
 PERMIT: _____
 TRANSFER: _____

CASH CHECK # _____ OTHER (IDENTIFY) _____ TOTAL RECD \$ _____

1583 TREASURY 4178 MISC CASH ACCT.

0407 COPIES _____ \$ _____
 OTHER (IDENTIFY) _____ \$ _____

0243 Instream Lease _____ 0244 Multi-User Right Perm _____ 0245 Cont. Water _____

1583 TREASURY 4278 MISC OPERATING ACCT.

MISCELLANEOUS 4611

0407 COPY & TAPE FEES _____ \$ _____
 0410 RESEARCH FEES _____ \$ _____
 0408 MISC REVENUE (IDENTIFY) _____ \$ _____
 TC188 DEPOSIT LNS (IDENTIFY) _____ \$ _____
 0240 EXTENSION OF TIME _____ \$ _____

WATER RIGHTS EXAM FEE _____ RECORD FEE _____

0201 SURFACE WATER _____ \$ _____ 0202 _____ \$ _____
 0203 GROUND WATER _____ \$ _____ 0204 _____ \$ _____
 0205 TRANSFER _____ \$ _____

WELL CONSTRUCTION EXAM FEE _____ RECORD FEE _____

0218 WELL DRILL CONSTRUCTION _____ \$ _____ 0219 _____ \$ _____
 LANDOWNER'S PERMIT _____ \$ _____ 0220 _____ \$ _____
 0200 OTHER (IDENTIFY) COBU \$ 2300.00

0207 TREASURY 0487 HYDROELECTRIC _____

0233 POWER LICENSE FEE (P/WRD) _____ \$ _____
 0231 HYDRO LICENSE FEE (P/WRD) _____ \$ _____

HYDRO APPLICATION _____ \$ _____

SPECIAL INSTRUCTIONS:

RETURN TO APPLICANT - LETTER ATTACHED

Groundwater File Review:

- Pump Test not required (Priority Date prior to December 20, 1988) *If no, include pump test flyer w/acknowledgment letter
- Pump Test required (Priority Date on or after December 20, 1988)
- Pump Test submitted
- Pump Test not submitted



Oregon
Kate Brown, Governor

Water Resources Department

725 Summer St NE, Suite A

Salem, OR 97301

(503) 986-0900

Fax (503) 986-0904

10/19/2022

Golden Rule Farms Inc.
PO Box225
Christmas Valley, OR 97641

Dear Applicant,

On 10-17-2022, the Water Resources Department received the Claim of Beneficial Use (COBU) for the following files:

Application T-12336

The COBU included a report and map. In the future the Department will review your submittal. At that time we will review these items and provide a final certificate, proposed certificate, or a request for additional information.

If you are interested in having your COBU reviewed sooner, you may pay to have your file processed immediately, using the Reimbursement Authority program, which is described at: <https://www.oregon.gov/owrd/programs/waterrights/ra/pages/default.aspx>.

Customer Service phone: (503) 986-0900

Enclosed is your receipt for the \$230.00 COBU recording fee.

If you sell the property, please contact the Department, or have the new owners contact the Department about the need to file an assignment.

Sincerely,
Dante Luongo

Cc: file