


T. 29 S. R. 6 W. W.M.

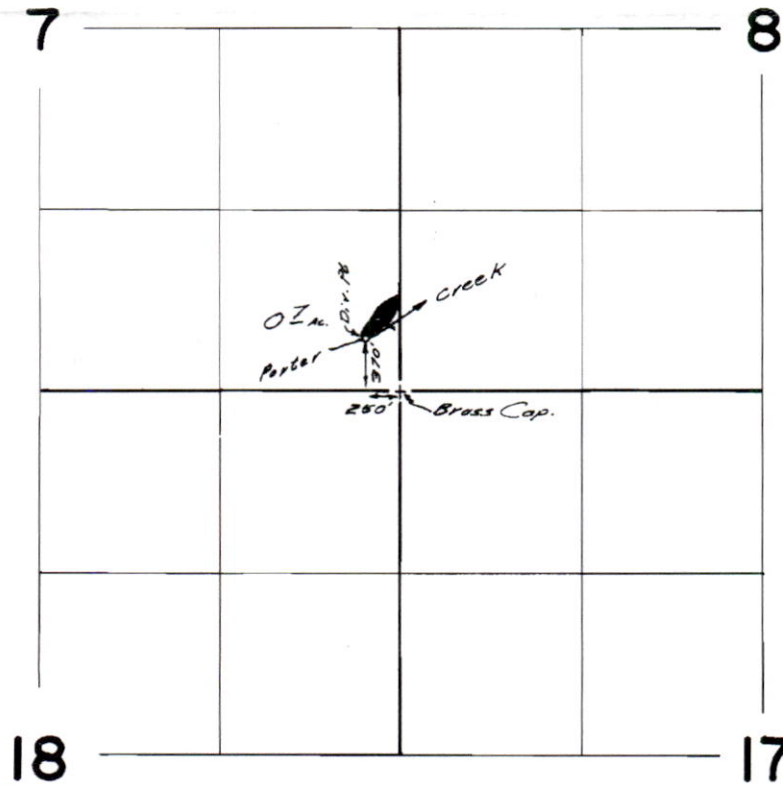

FINAL PROOF SURVEY
UNDER

RECEIVED

OCT 07 2022

OWRD

Application No. 39100 Permit No. 29107
IN NAME OF

Richard C. Smallwood

Surveyed Sept. 29, 1967, by W. d. Ruppert

STATE OF OREGON
COUNTY OF DOUGLAS
CERTIFICATE OF WATER RIGHT

This Is to Certify, That **RICHARD C. SMALLWOOD**

of Star Route, Box 1028, Winston, State of Oregon, has made proof to the satisfaction of the STATE ENGINEER of Oregon, of a right to the use of the waters of Porter Creek

a tributary of Rice Creek (South Umpqua River) for the purpose of irrigation of 0.7 acre

under Permit No. 29107 of the State Engineer, and that said right to the use of said waters has been perfected in accordance with the laws of Oregon; that the priority of the right hereby confirmed dates from September 19, 1963

that the amount of water to which such right is entitled and hereby confirmed, for the purposes aforesaid, is limited to an amount actually beneficially used for said purposes, and shall not exceed 0.01 cubic foot per second

or its equivalent in case of rotation, measured at the point of diversion from the stream. The point of diversion is located in the SE $\frac{1}{4}$ SE $\frac{1}{4}$, Section 7, T. 29 S., R. 6 W., W. M. Diversion point located 370 feet North and 250 feet West from SE Corner, Section 7.

The amount of water used for irrigation, together with the amount secured under any other right existing for the same lands, shall be limited to ~~one-eighth~~ of one cubic foot per second per acre, or its equivalent for each acre irrigated and shall be further limited to a diversion of not to exceed $2\frac{1}{2}$ acre feet per acre for each acre irrigated during the irrigation season of each year; provided further that the right to use of water is limited to the period when the flow of the South Umpqua River is more than 60 c.f.s. at its mouth;

and shall conform to such reasonable rotation system as may be ordered by the proper state officer.

A description of the place of use under the right hereby confirmed, and to which such right is appurtenant, is as follows:

0.7 acre SE $\frac{1}{4}$ SE $\frac{1}{4}$
Section 7
T. 29 S., R. 6 W., W. M.

RECEIVED

OCT 07 2022

OWRD

The right to the use of the water for the purposes aforesaid is restricted to the lands or place of use herein described.

WITNESS the signature of the State Engineer, affixed

this date. September 30, 1968

CHRIS L. WHEELER

State Engineer



Oregon Water Resources Department
725 Summer Street NE, Suite A
Salem, Oregon 97301
(503) 986-0900
www.wrd.state.or.us

Ownership Up For Certificated Only

A-S 39100
R-S 29107
C 35310

NO FEES ARE REQUIRED TO SUBMIT THIS FORM

NOTICE: A certificate of water right typically stays with the land. In order to track water right ownership, the Department requests that this form be submitted to the Department. **To update multiple rights, a separate form is required for each right.**

If you have any questions about this form, please contact your local watermaster, or call the Water Resources Department at (503) 986-0900.

This form is not for Applications, Permits, Transfers, Groundwater Registrations, or Limited Licenses. To notify the Department of changes in ownership to these types of authorizations, an Assignment is required.

Current Landowner Information

Name: MARK TODD - MARLENE SULLIVAN

Mailing Address: 2116 AUSTIN RD

City: ROSEBURG

State: OREGON

Zip: 97471

Phone (Home): 541-580-2536

Work: _____

Other: 541-580-8322

Property Description

County: DOUGLAS Township: 29 South Range: 6 West W.M. Section: 7

Taxlot Number(s): R65919

Street Address of water right property: 671 PORTER CREEK ROAD, WINSTON, OR 97496

Water Right Information: Application: S - 39100 Permit: S - 29107 Certificate #: 35310

Are all the lands associated with this water right owned by the requester? Yes ☒ No ☐ If No, include a map showing the portion of the right involved.

Name of individual completing this form: MARK TODD

Phone: 541-580-2536

Signature of requestor: [Signature]

Date: 10-4-2022

The Department does not change names on certificates. This form will be placed in the file for future reference only. The Department does not provide acknowledgement that this form has been received.