

RECEIVED

DEC 16 2021

OWRD




Sections 15 & 22, T14S, R5W, W.M.,
Benton County, Oregon

GROUNDWATER APPLICATION MAP
Recompense, LLC



DRAFT

EXPLANATION

-  PROPOSED IRRIGATION
91.0 ACRES
-  PROPOSED WELL
-  PIPE

N

SCALE



1 INCH = 1320 FEET

October 11, 2021

This map is not intended to provide legal
dimensions or locations of property
ownership lines

Figure 1

KPFF 1700014.81

SKOOKUM
WATER ASSOCIATES INC

1626 VICTORIAN WAY
EUGENE, OR 97401
(503) 319-8926

THIS MAP WAS PREPARED FOR
ASSESSMENT PURPOSE ONLY


SECTION 15 T.14S. R.5W. W.M.
BENTON COUNTY
1" = 400'

Work
Copy



14515

REV: 07/31/2013
CANCELLED:
400U1 THRU 4C

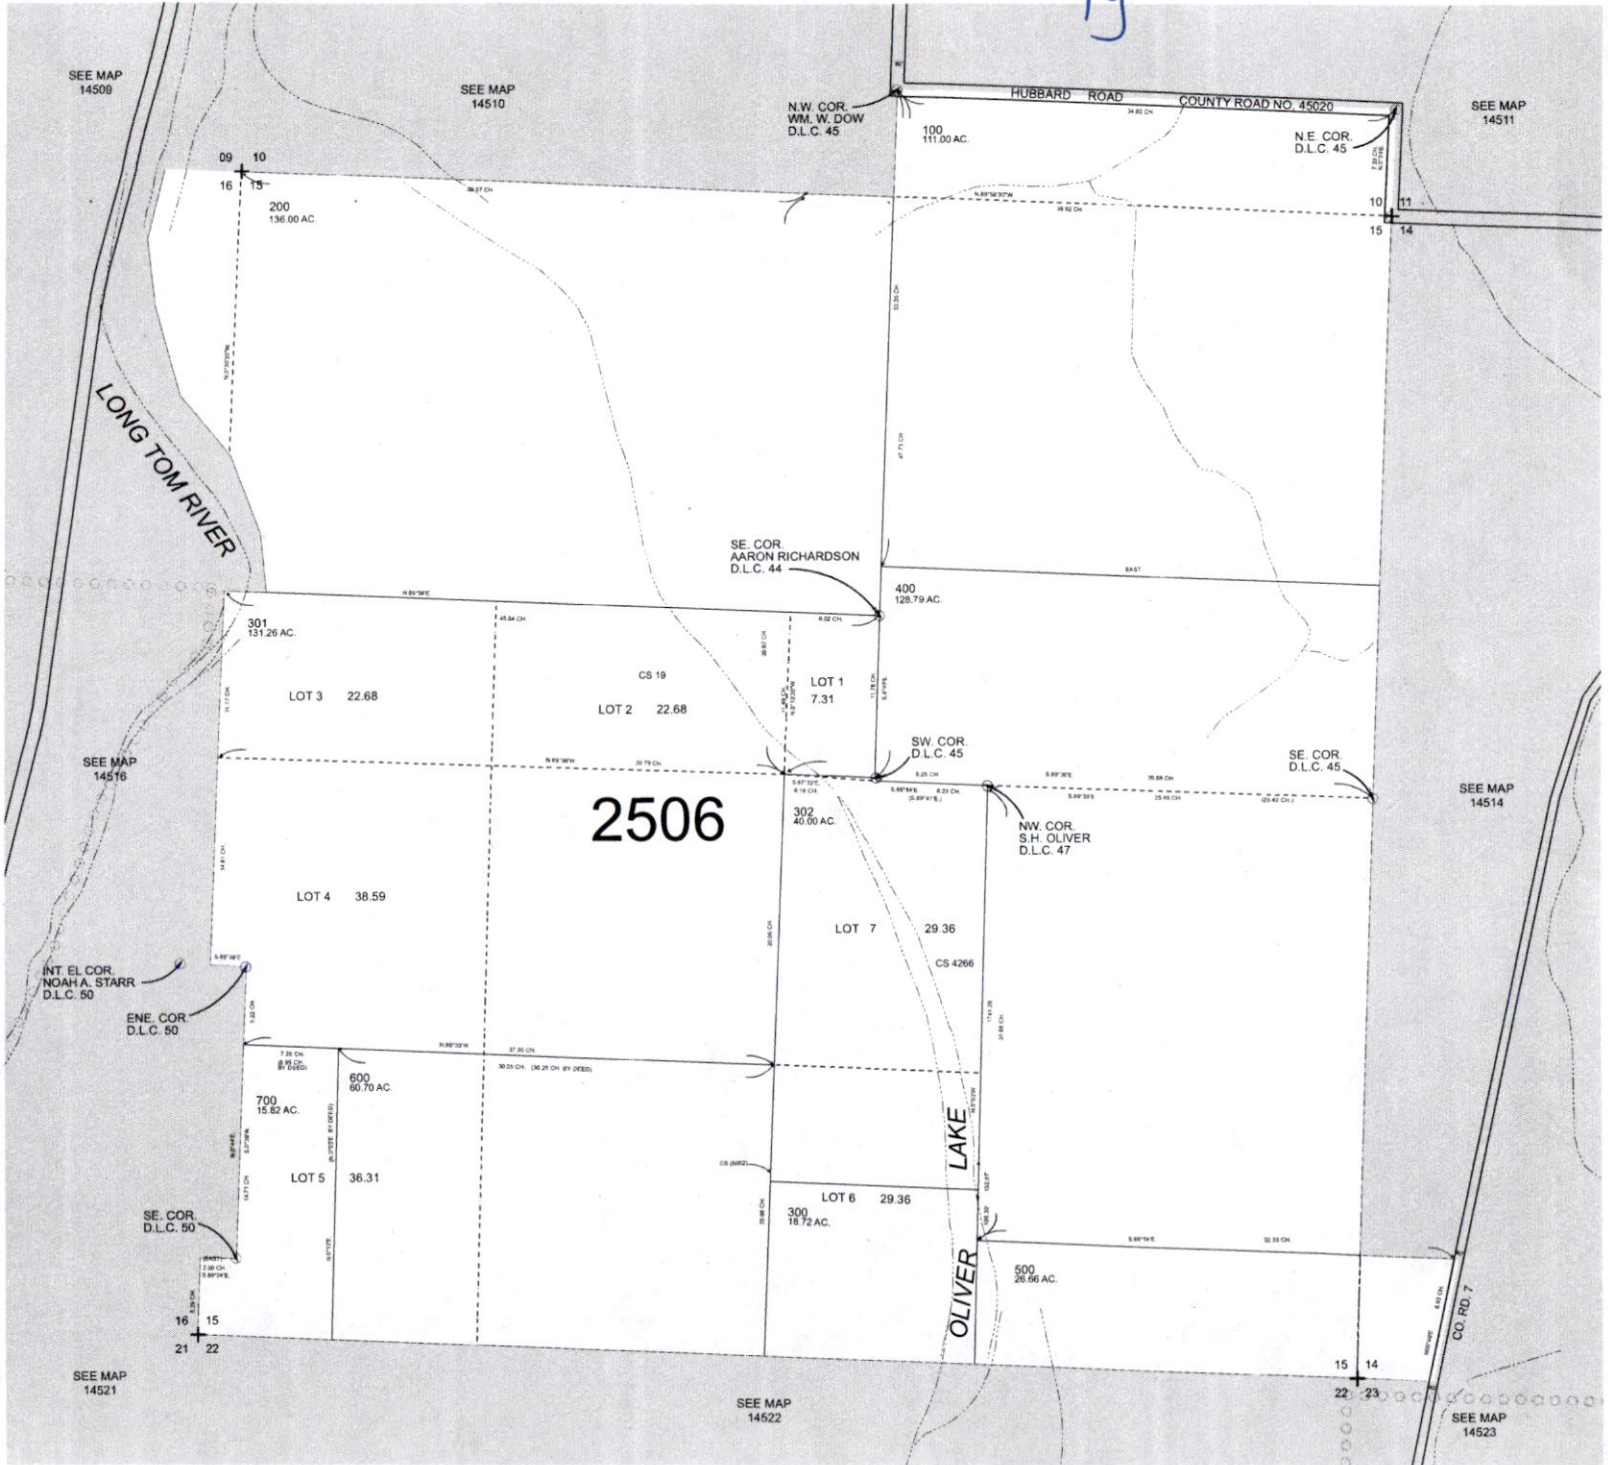

14515

THIS MAP WAS PREPARED FOR ASSESSMENT PURPOSE ONLY


SECTION 15 T.14S. R.5W. W.M.
BENTON COUNTY
1" = 400'

0 200 400 Feet

work copy

14515

REV: 07/31/2013
CANCELLED:
400U1 THRU 400U4

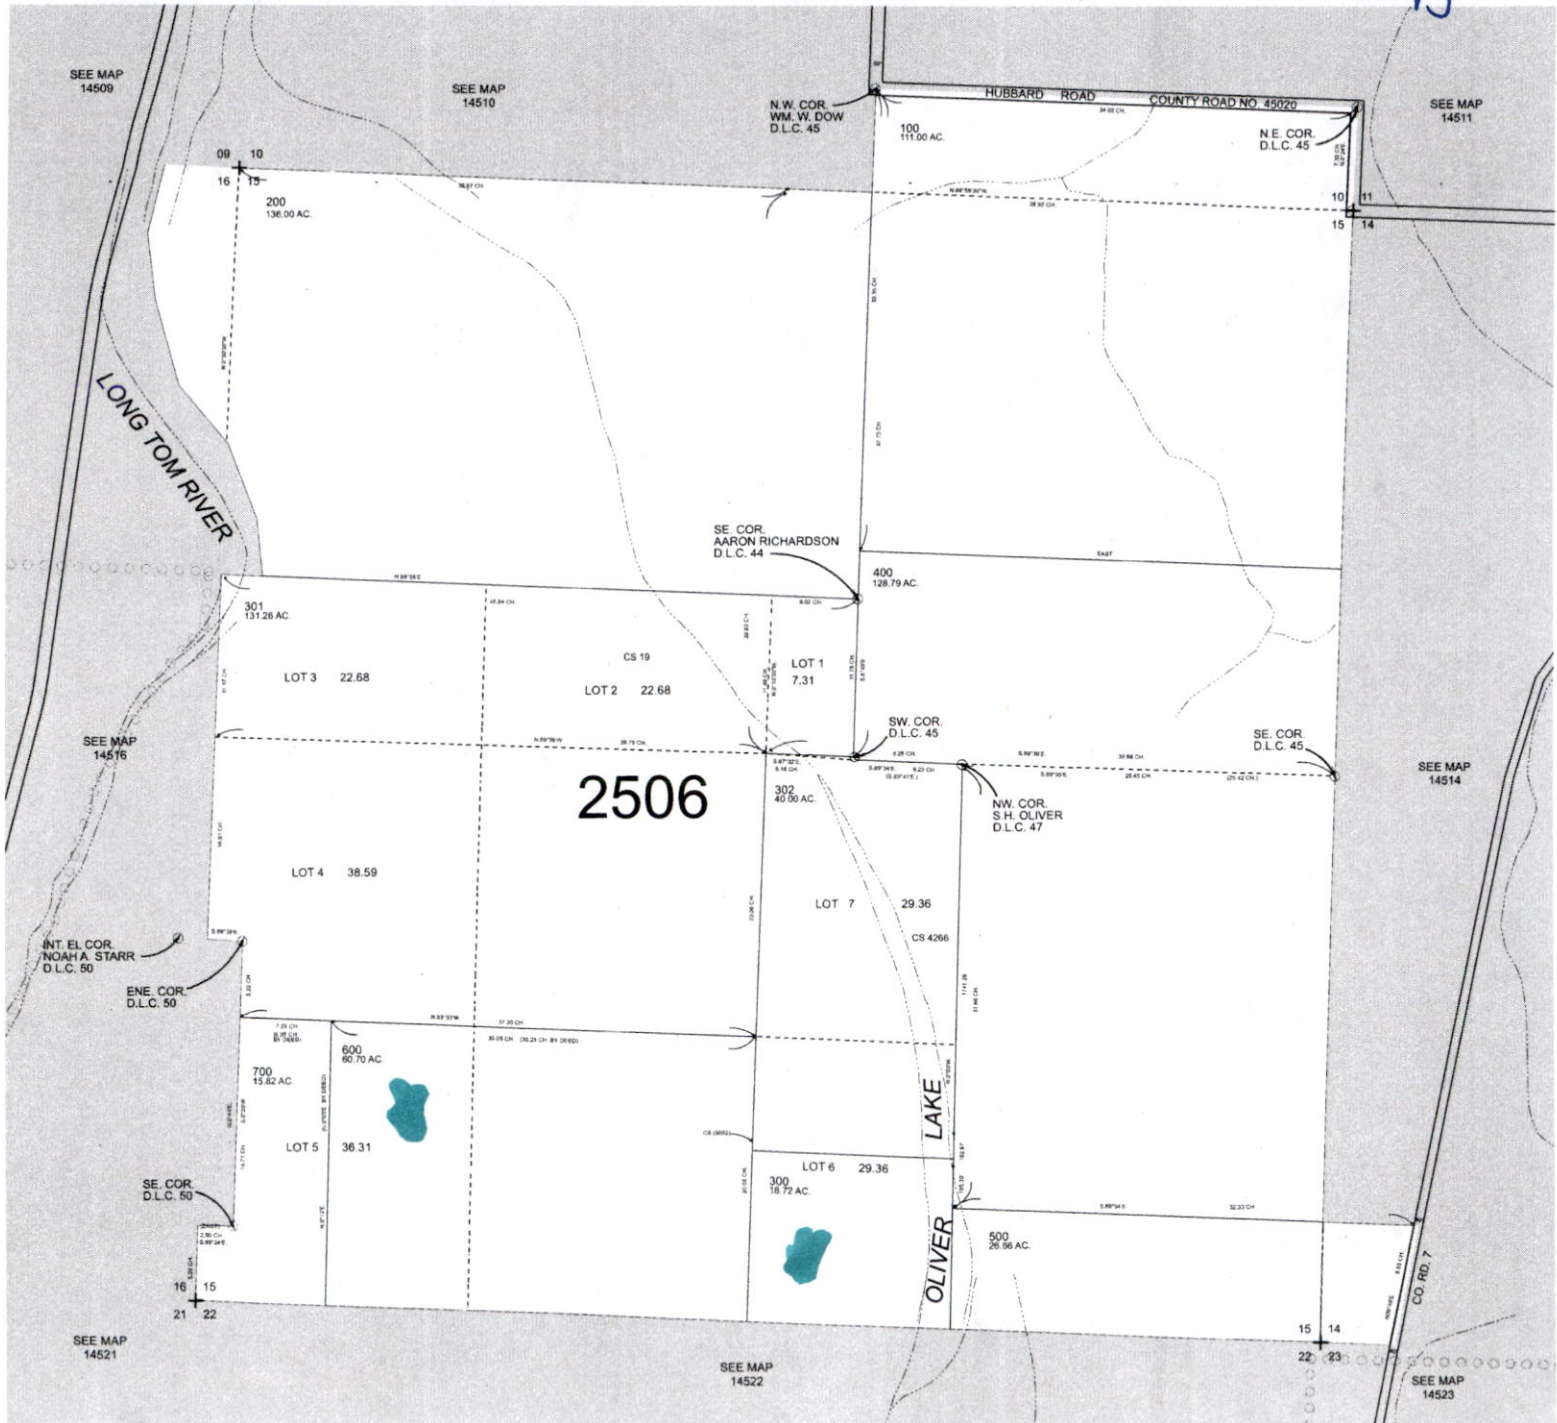

14515