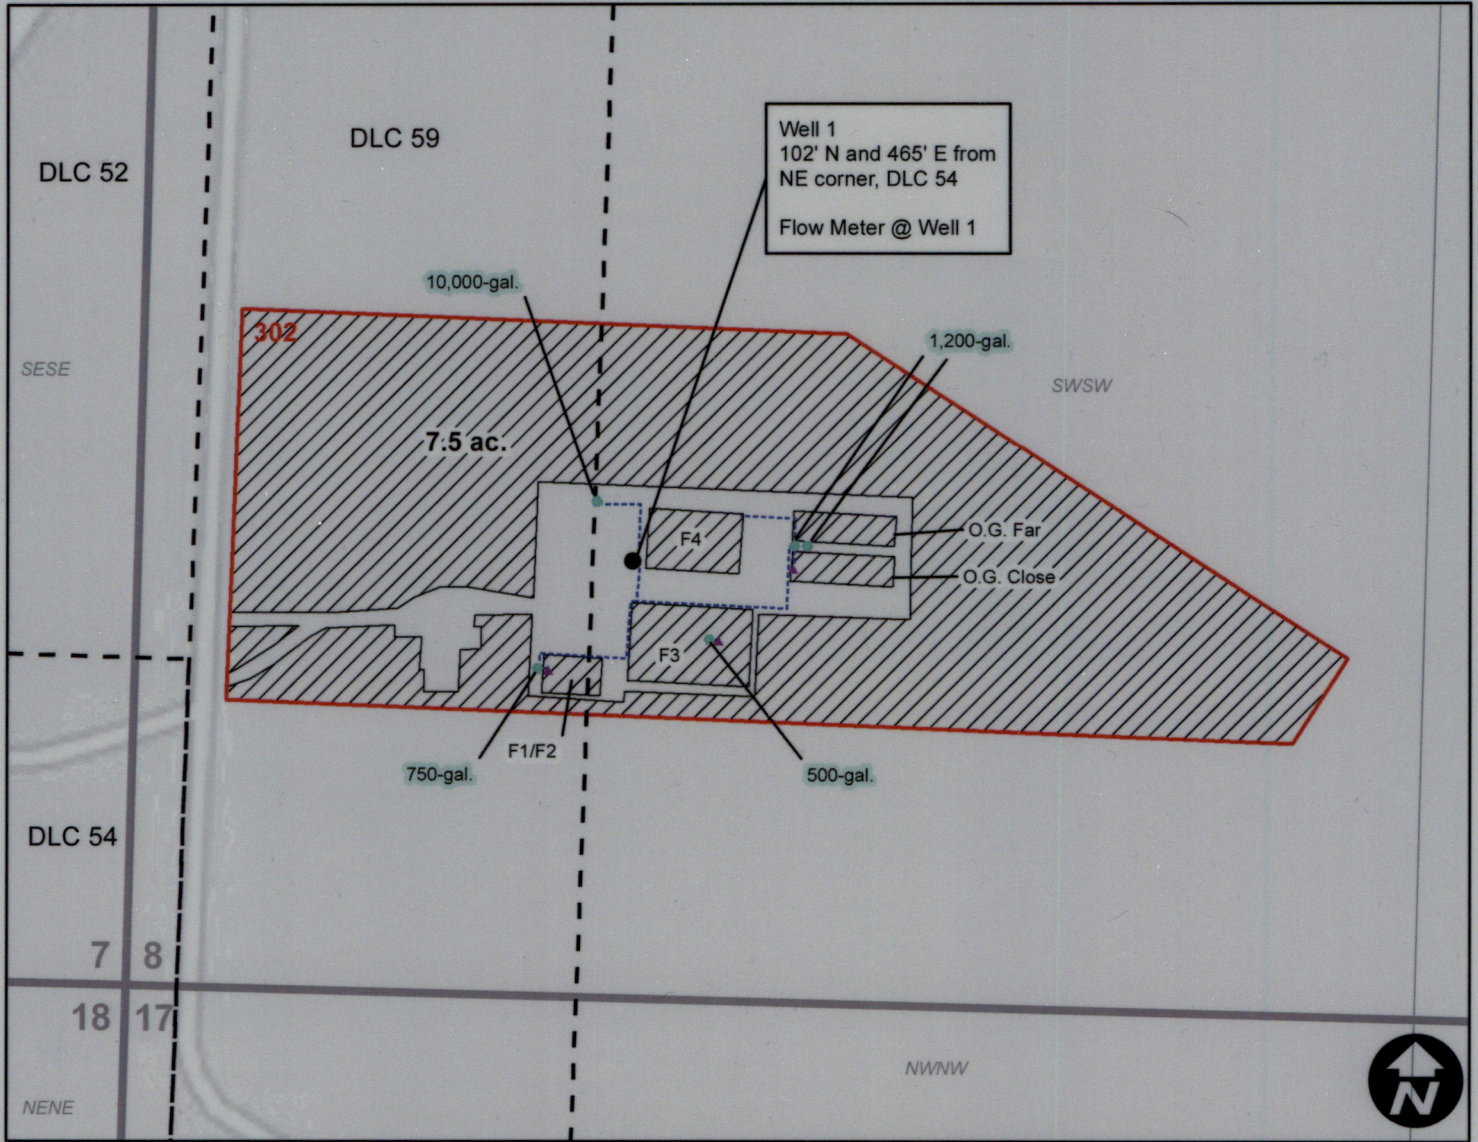


Claim of Beneficial Use - Java Properties OR 4 LLC

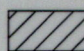
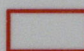
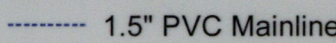
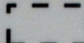


Application G-18398, Permit G-18029

Township 19S, Range 2W, W.M.

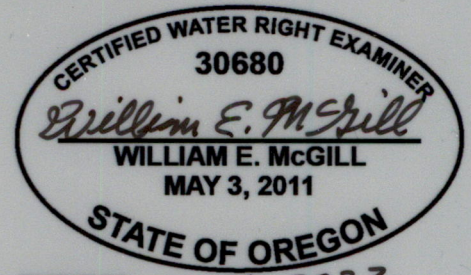


This map is not intended to provide legal dimensions or locations of property ownership lines.

Legend

-  Developed POU
-  Taxlot
-  1.5" PVC Mainline
-  DLC
-  Storage Tanks
-  Centrifugal Pumps

RECEIVED
OCT 27 2022
OWRD



EXPIRES: 12-31-2022