

CLAIM OF BENEFICIAL USE MAP


LOCATED IN SECTION 29, TAX LOT 1300, DLC 50
AND SECTION 28, TAX LOT 1100, DLC 52.
TOWNSHIP 1 SOUTH, RANGE 2 WEST, W.M.,
WASHINGTON COUNTY, OREGON.

ESHRAGHI NURSERY, PRIMARY, PERMIT G-15553					
IS	2W	29	SW/SE	52	3.61
SUPPLEMENTAL, PERMIT G-15553					
T	R	Sec	Q-Q	DLC	Area ac
1S	2W	29	SE/SW	52	0.32
1S	2W	29	SW/SE	52	24.53
1S	2W	29	SE/SE	52	0.25
1S	2W	32	NE/NW	52	8.62
1S	2W	32	NW/NE	52	26.74
Supplemental Total =					60.46
Permit Total =					64.07

LEGEND			
--- 1/4-1/4 LINE	----- BURIED MAIN LINE		PRIMARY PERMIT G-15553
----- PROPERTY LINE	⊙ WELL, POA		SUPPLEMENTAL PERMIT G-15553
----- CREEK	⊙ POD		PRIMARY CERT. 19954
----- ROAD	⊙ GOV. CORNER		
----- DLC LINE	⊗ BUILDING		

POA 1: WELL #1, LOCATED 1215' NORTH AND 1110' EAST FROM THE SW CORNER OF RICHEY DLC 50.


POA 2: WELL #2, LOCATED 200' SOUTH AND 720' EAST FROM THE SW CORNER OF RICHEY DLC 50.

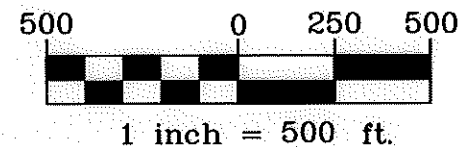

The preparation of this map was for the purpose of identifying the location of the Water Right only and has no intent to provide dimensions or location of property ownership lines.

APPLICATION PERMIT
G-16021 G-15553

IN THE NAME OF:
ESHRAGHI NURSERY.

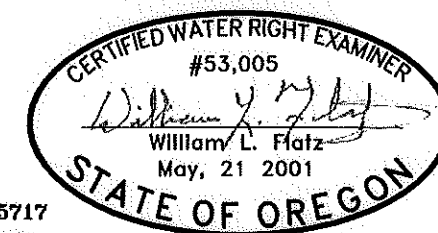

Stuntzner
Engineering & Forestry, LLC
FOREST GROVE*COOS BAY*JUNCTION CITY

ENGINEERING * LAND SURVEYING
FORESTRY * PLANNING * WATER RIGHTS
JOB# 322-055, REVISED 8-24-22
DRAWING : ESHRAGHI COBU MAP.DWG

2318-B PACIFIC AVENUE TEL: (503) 357-5717
FOREST GROVE, OR 97116 FAX: (503) 357-5698

