
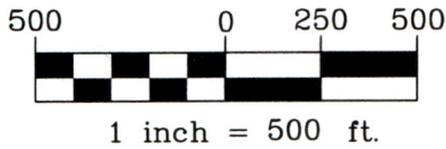


CLAIM OF BENEFICIAL USE MAP

LOCATED IN SECTION 29, TAX LOT 1300 AND 1401, TOWNSHIP 1 SOUTH,
RANGE 2 WEST, DLC 50, W.M., WASHINGTON COUNTY, OREGON.

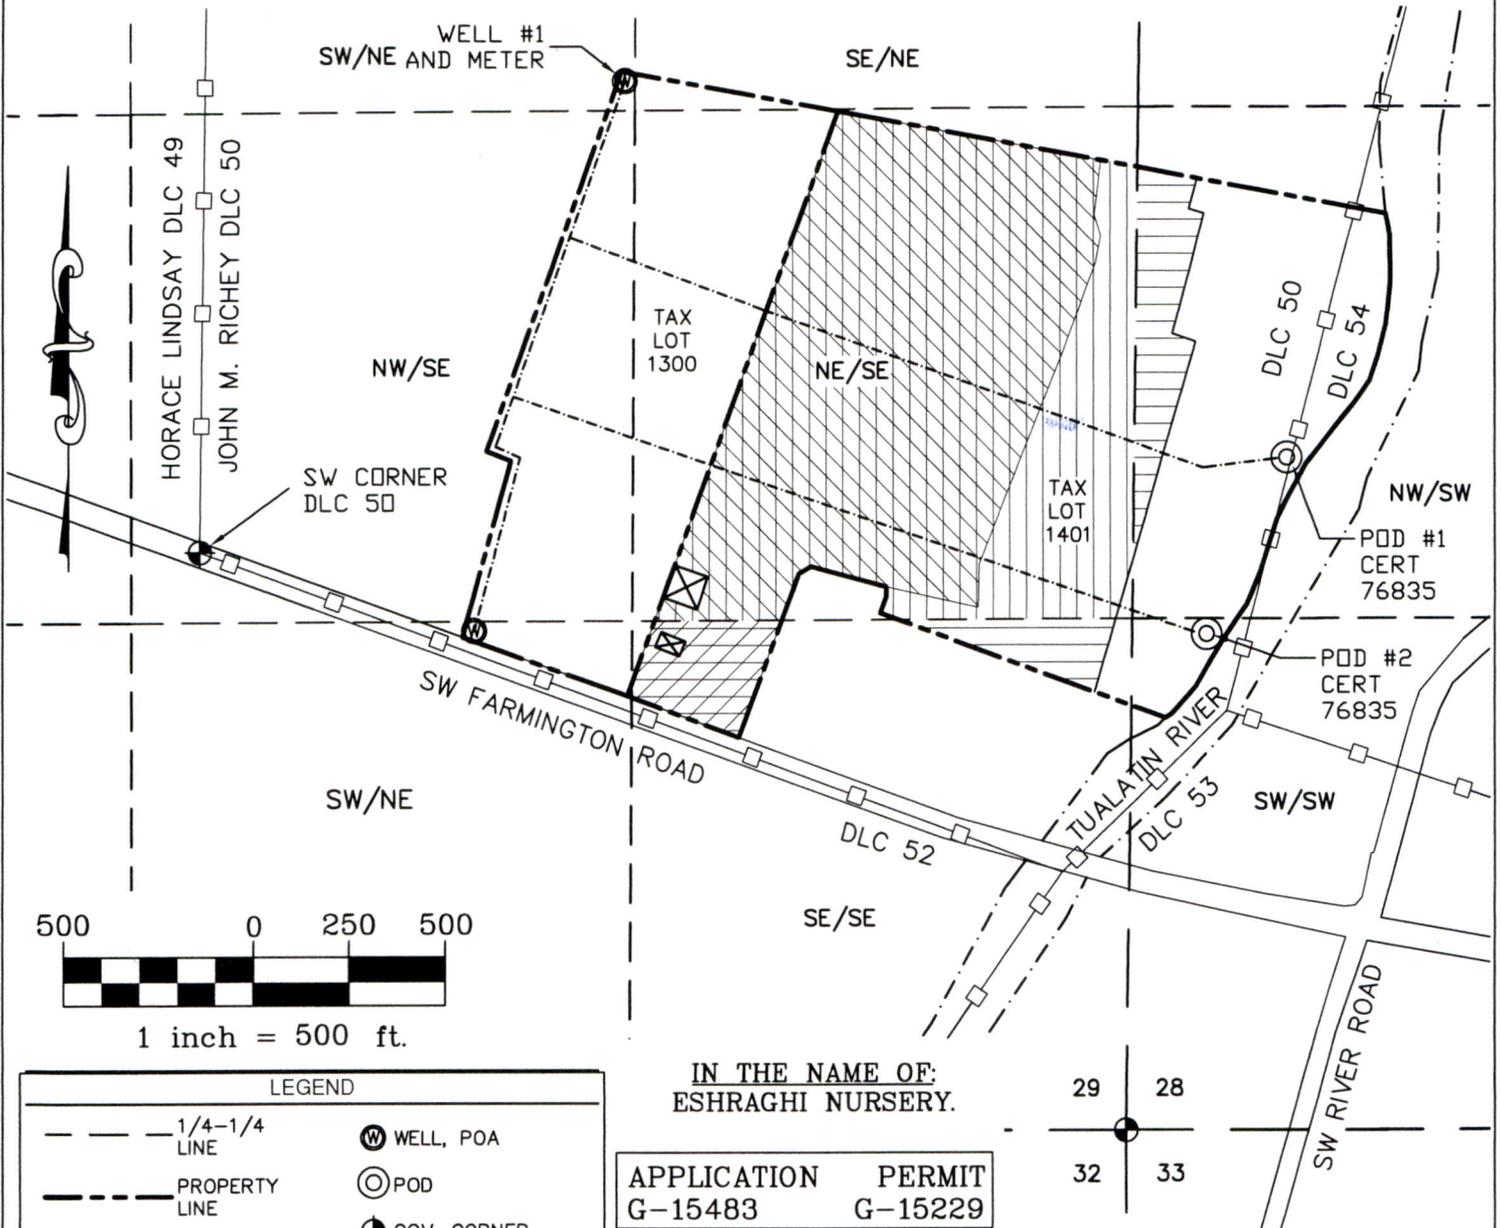

IN THE NAME OF:
ESHRAGHI NURSERY.

APPLICATION PERMIT
G-15483 G-15229

POA 1: WELL #1, LOCATED
1215' NORTH AND 1110' EAST
FROM THE SW CORNER OF
RICHEY DLC 50.

SUPPLEMENTAL NURSERY PERMIT G-15229		
Q-Q	DLC	Area ac
NE/SE	50	21.7
SE/SE	50	1.8
Total =		23.5

LEGEND

- 1/4-1/4 LINE
- PROPERTY LINE
- - - CREEK
- ROAD
- DLC LINE
- - - BURIED MAIN LINE
- ⊙ WELL, POA
- ⊙ POD
- ⊕ GOV. CORNER
- ⊠ BUILDING
- ▨ SUPPLEMENTAL PERMIT G-15229
- ▩ PRIMARY CERT. 76835

The preparation of this map was for the purpose of identifying the location of the Water Right only and has no intent to provide dimensions or location of property ownership lines.

Stuntzner
Engineering & Forestry, LLC
FOREST GROVE*COOS BAY*JUNCTION CITY

ENGINEERING * LAND SURVEYING
FORESTRY * PLANNING * WATER RIGHTS
JOB# 322-055, REVISED 8-24-22
DRAWING : ESHRAGHI COBU MAP.DWG
2318-B PACIFIC AVENUE TEL: (503) 357-5717
FOREST GROVE, OR 97116 FAX: (503) 357-5698

CERTIFIED WATER RIGHT EXAMINER
#53,005
William L. Flatz
William L. Flatz
May, 21 2001
STATE OF OREGON
EXPIRES 12/31/2023