


# T.1N. R.2E. Section 24, W.M.

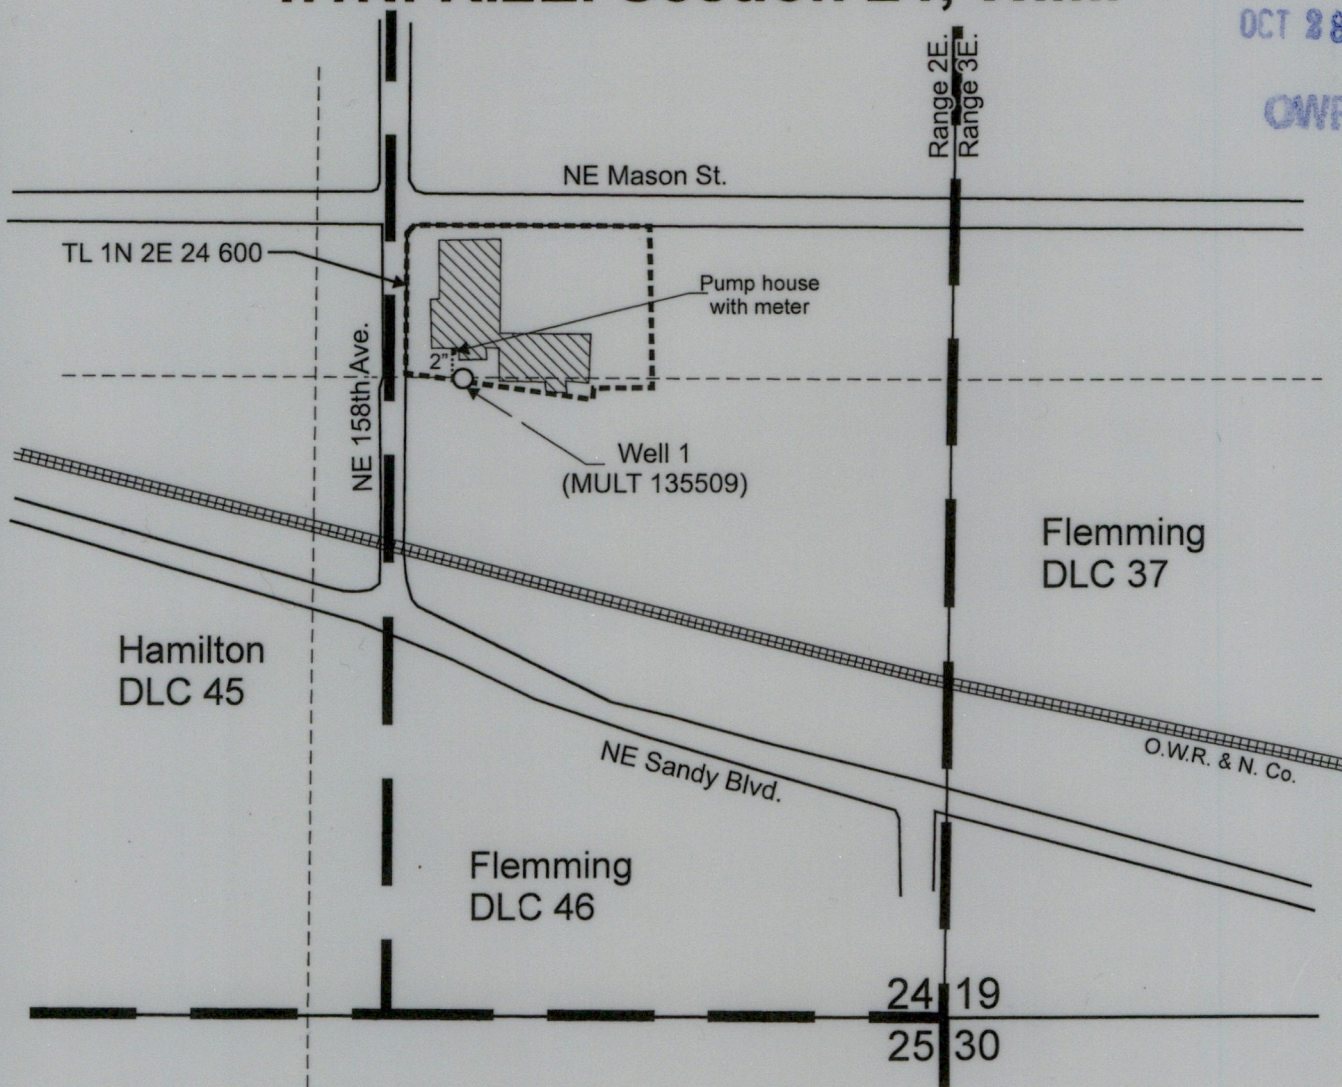



RECEIVED

OCT 28 2012

OWRD

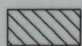


Well 1 (MULT 135509) is located 1,320 feet north and 1,000 feet west from the SW corner of Section 24.

 
-  Area for commercial use under Application G-18328, Permit G-17862.
-  Tax lot boundary
-  Donation Land Claim boundary
-  Water main line



EXPIRES: *June 30 2013*

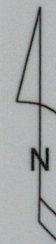

Scale: 1" = 400'

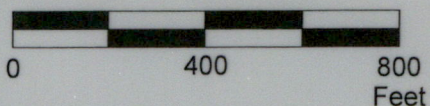

This map was prepared for the purpose of identifying the location of a water right only and is not intended to provide legal dimensions or location of property ownership lines.

Claim of Beneficial Use Map  
Application G-18328, Permit G-17862

Pacific Hydro-Geology Inc.

10/2022

Morasch Meats  
T.1N. R.2E. Section 24, W.M.