


Sections 17, 18 & 20, T12S, R5W, W.M., Benton County, Oregon
 Transfer T-13183
 CLAIM OF BENEFICIAL USE MAP
 Brooks Farm LLC

RECEIVED

NOV 03 2022

OWRD

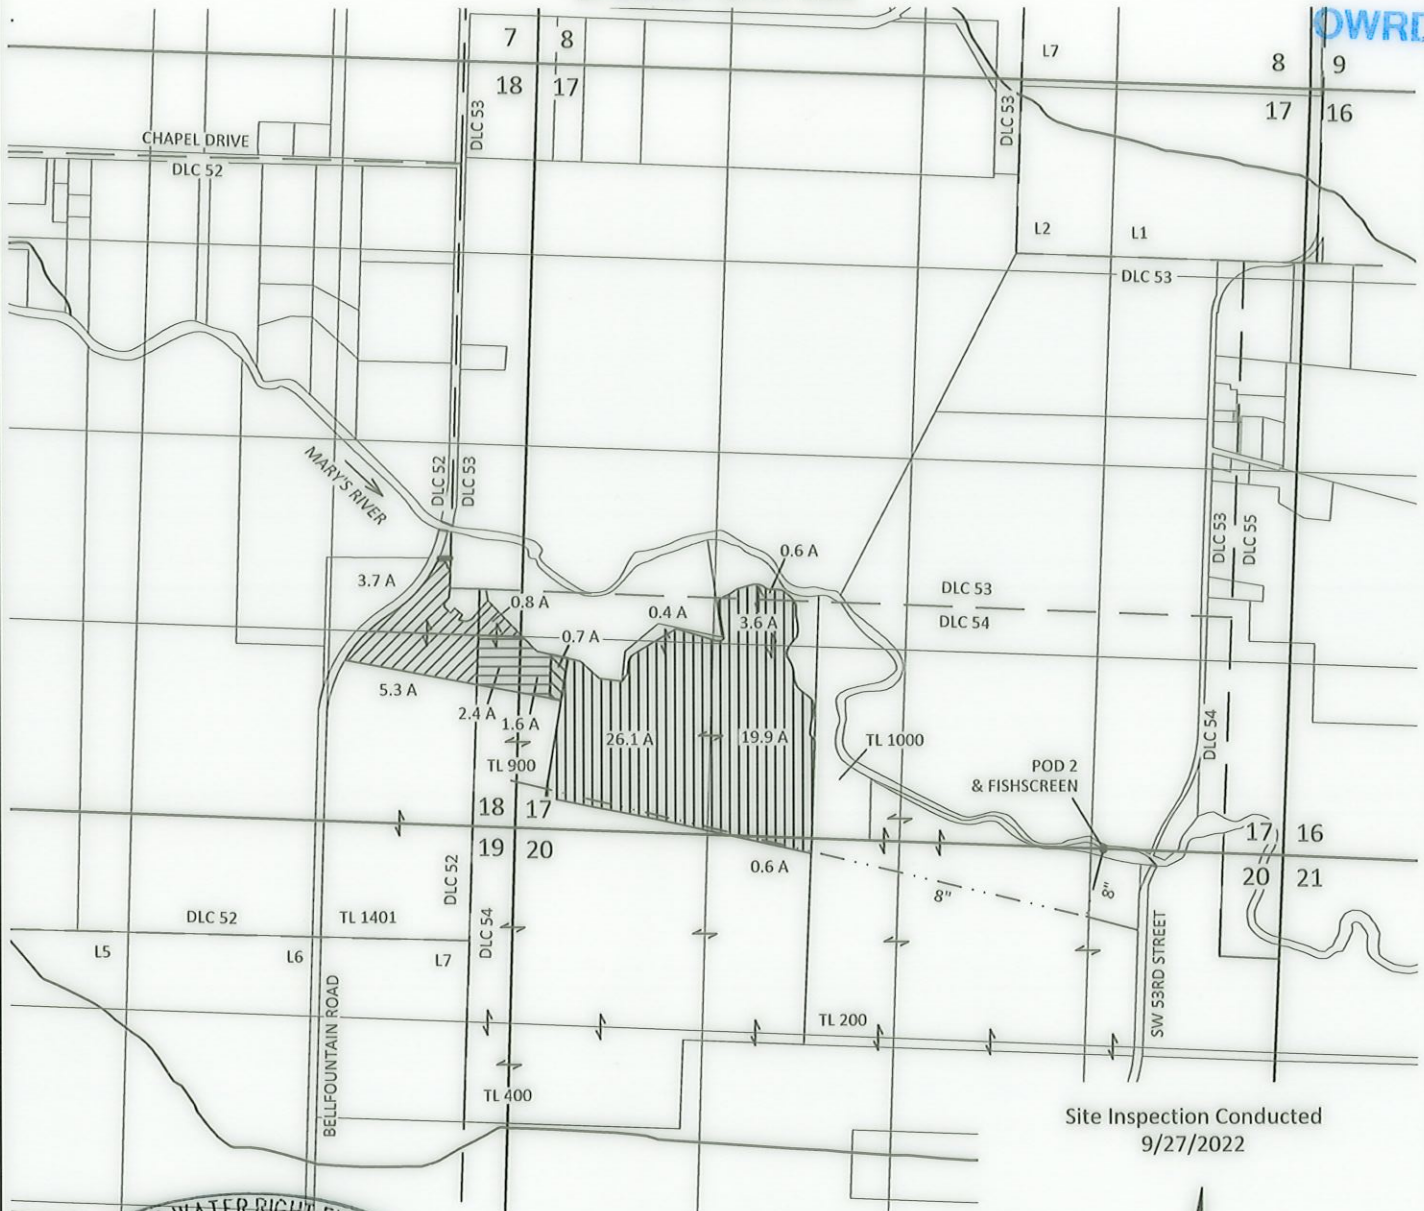


Site Inspection Conducted
 9/27/2022

CERTIFIED WATER RIGHT EXAMINER
 439
Steven R. Bruce
 STEVEN R. BRUCE
 JUNE 13, 1997
 STATE OF OREGON
 Expires 12/31/2023

POD 2 LOCATION: 40 FT N AND 1230 FT W FROM SE CORNER OF SECTION 17, T6S, R4W, W.M.

EXPLANATION

-  CANCELED CERTIFICATE 41818
PLACE OF USE - IRRIGATION - 0.7 ACRES
PRIORITY: 2/14/1968
-  CANCELED CERTIFICATE 52333
PLACE OF USE - IRRIGATION - 9.8 ACRES
PRIORITY: 7/8/1974
-  CANCELED CERTIFICATE 61427
PLACE OF USE - IRRIGATION - 51.2 ACRES
PRIORITY: 9/4/1975
-  CANCELED CERTIFICATE 61593
PLACE OF USE - IRRIGATION - 4.0 ACRES
PRIORITY: 4/16/1979
-  POINT OF DIVERSION (POD)
-  8" PIPELINE

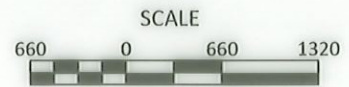

October 26, 2022

This map is not intended to provide legal dimensions or locations of property ownership lines

Figure 1

SKOOKUM
 WATER ASSOCIATES INC

1626 VICTORIAN WAY
 EUGENE, OR 97401
 (503) 319-8926