
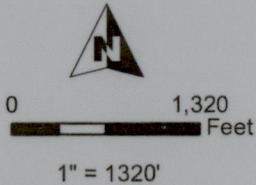


T27S R33E, WM,
HARNEY COUNTY, OR

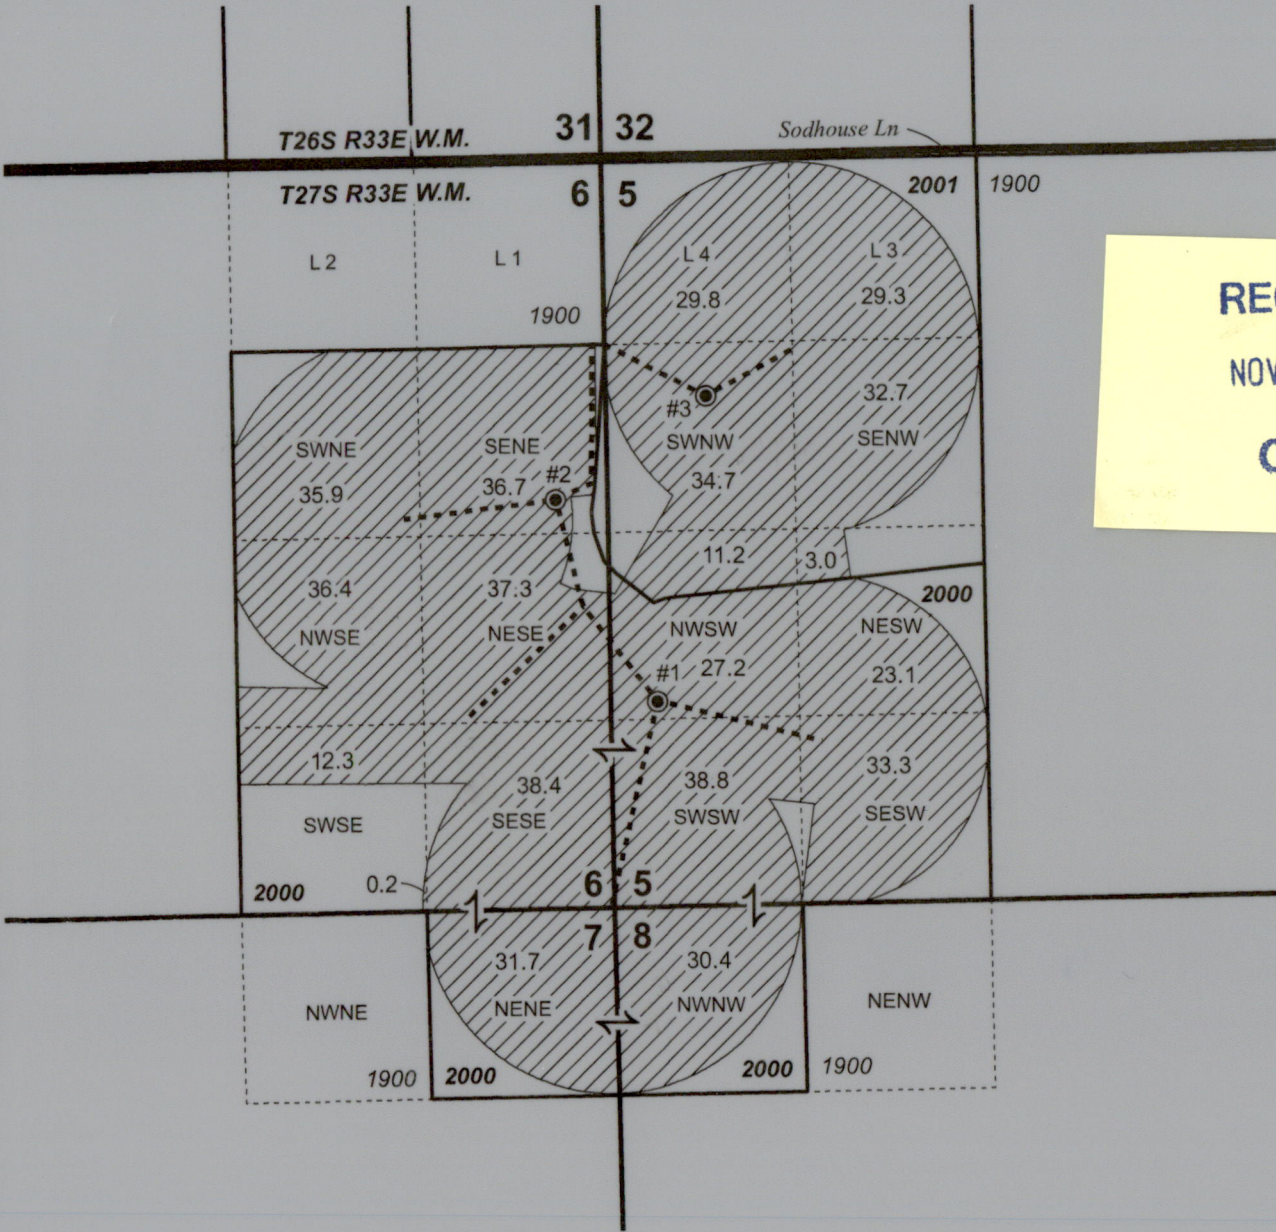


- Well & Meter
- Pipeline
- POU IR
- Township
- Section
- Quarter Quarter
- Tax Lot

Well Locations:

Well #1 (HARN 50355/L-21299):
1470' N, 300' E of SW Cor Sec 5

Well #2 (HARN 52817/L-133007):
2410' S, 320' W of NE Cor Sec 6

Well #3 (HARN 51498/L-96557):
1670' S, 730' E of NW Cor Sec 5

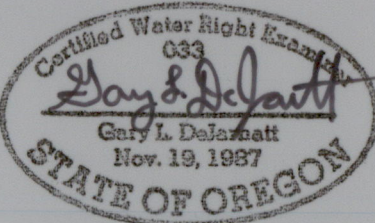

RENEWAL DATE 12/31/2023

CLAIM OF BENEFICIAL USE MAP
Keerins Ranch

Ap G-15181 Permit G-15008 Project #22048 Date: 10/7/2022

This map is not intended
to provide legal dimensions
or locations of property
ownership lines.

WATER RIGHT SERVICES, LLC
PO BOX 1830, BEND, OR 97709
WWW.OREGONWATER.US CCB # 197121
johnshort@usa.com 541-389-2837