



# T.12S. R.4W. Sec. 6 & 7, W.M.

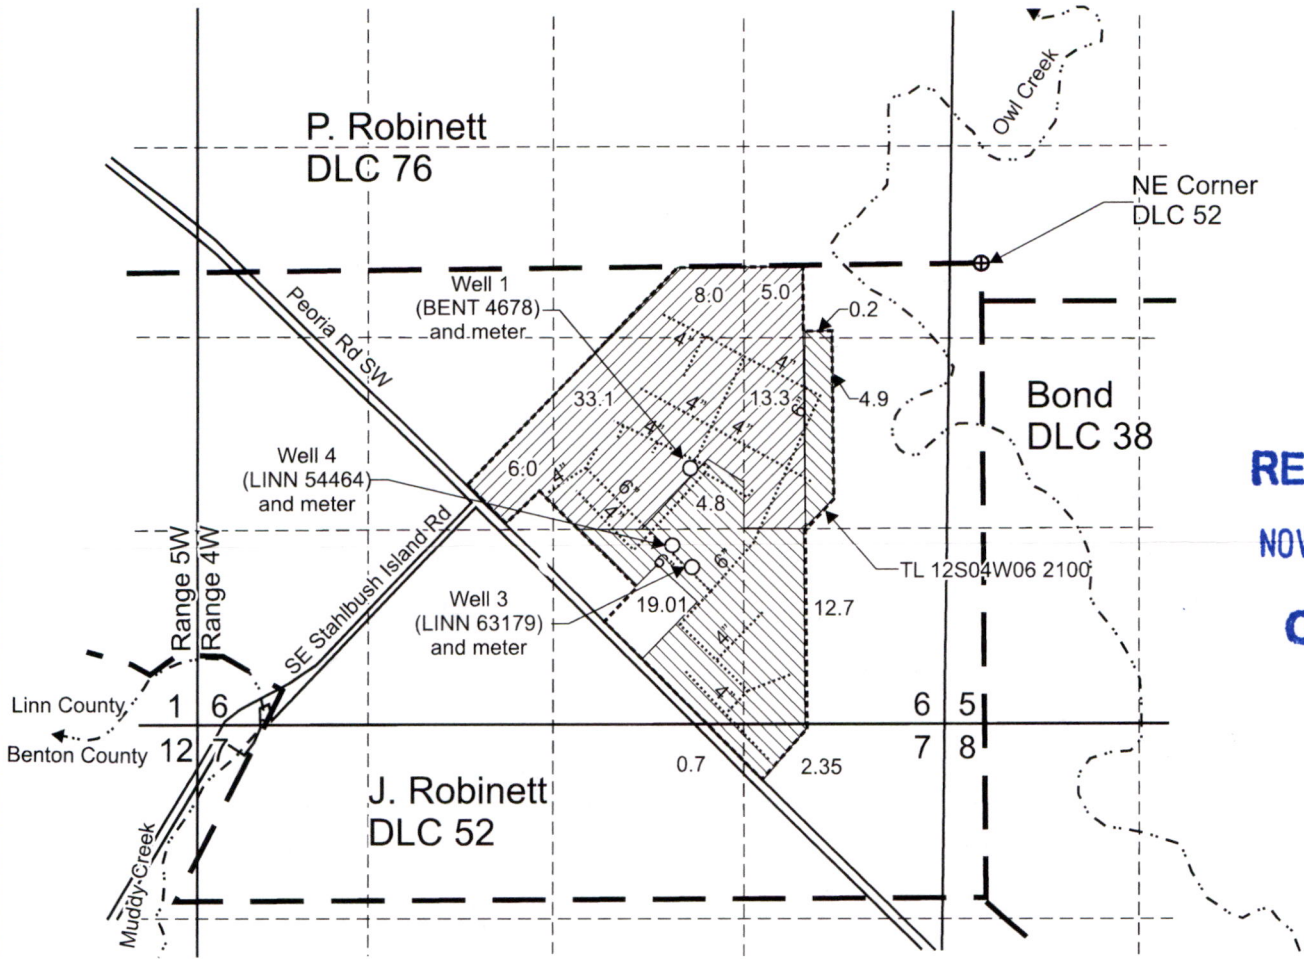


Well 1 (BENT 4678) is located 1,395 feet south and 1,990 feet west from the NE corner, DLC 52.

Well 3 (LINN 63179) is located 1,065 feet north and 1,730 feet west from the SE corner, Section 6.

Well 4 (LINN 54464) is located 1,215 feet north and 1,870 feet west from the SE corner, Section 6.

 Area (44.66 Acres) of primary irrigation under T-13320 formerly Certificate 60433, priority date May 16, 1979.

 Area (65.40 Acres) of supplemental irrigation under T-13320 formerly Certificate 60433, priority date May 16, 1979.

----- Tax lot boundary

— ■ — Donation Land Claim boundary

..... Water main line

Scale: 1" = 1,320'



EXPIRES: *June 30 2022*

This map was prepared for the purpose of identifying the location of a water right only and is not intended to provide legal dimensions or location of property ownership lines.



Pacific Hydro-Geology Inc.

10/2022

Claim of Beneficial Use Map  
T-13320 Formerly Certificate 60433  
Oregon State University  
College of Agricultural Sciences  
T.12S. R.4W. Sec. 6 & 7, W.M.

OSU T-13320COBUMMapap.cdr