


Section 12, T6S, R4W, W.M.,
Polk County, Oregon

Application R-88503, Permit R-15324
CLAIM OF BENEFICIAL USE MAP
Lone Star Road, LLC

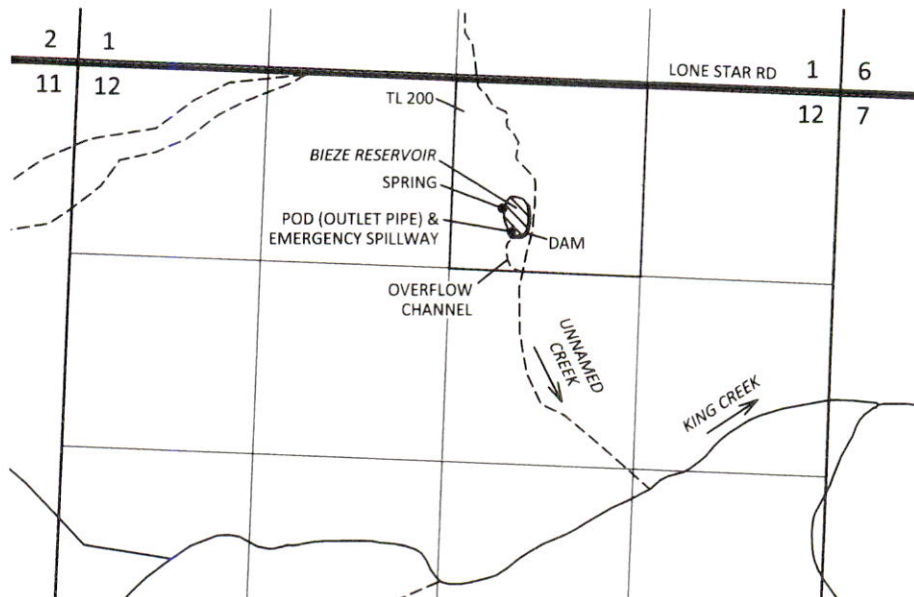

RECEIVED
NOV 03 2022
OWRD

POD LOCATION: 960 FT S AND 2270 FT W FROM NE CORNER OF
SECTION 12, T6S, R4W, W.M.

Site Inspection Conducted
September 13, 2022



EXPLANATION



PLACE OF USE - STORAGE
0.9 ACRES, 3.5 ACRE FEET



POINT OF DIVERSION (POD)

NOTE:

THE UNNAMED CREEK DOES NOT CONNECT TO THE
RESERVOIR AND IS LOCATED APPROXIMATELY 50 FEET EAST
OF THE RESERVOIR BANK.



SCALE



1 INCH = 1320 FEET

October 12, 2022

This map is not intended to provide legal
dimensions or locations of property
ownership lines

SKOOKUM
WATER ASSOCIATES INC

1626 VICTORIAN WAY
EUGENE, OR 97401
(503) 319-8926

Figure 1