


AL-1895

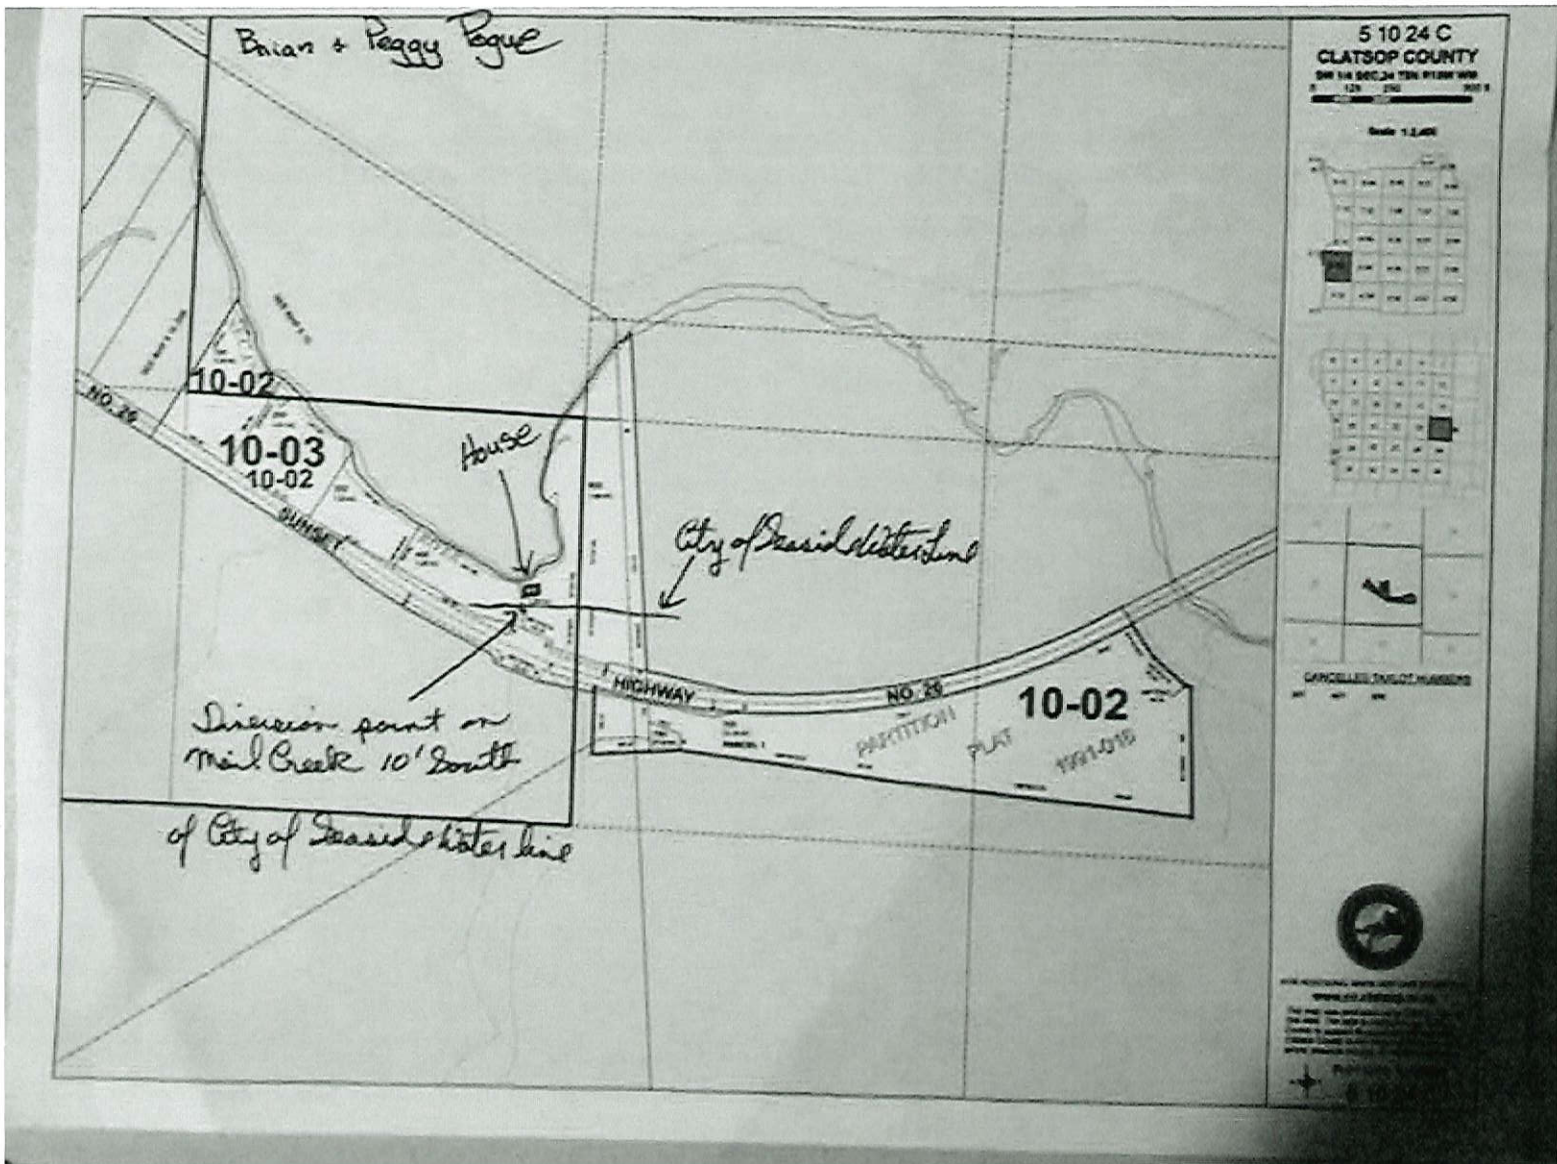

RECEIVED

AUG 3 0 2021


OWRD

FWD 1983/21 HARRIS State Plane Oregon North FIPS 3601 100 Feet

Superseded

1.08 acres
plus
adjacent
land
1.96


	31	32	33	34	35	36	37
1	6	5	4	3	2	1	
2	7	8	9	10	11	12	
3	13	14	15	16	17	18	
4	19	20	21	22	23	24	
5	25	26	27	28	29	30	
6	31	32	33	34	35	36	

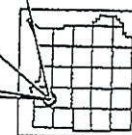


5.10.24C

68-77

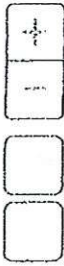

N

Search Tools

Tasks

Results

Find Taxlot _Query result

Displayed features: 1/1

RECEIVED

AUG 17 2021

OWRD

Taxlot: 51024C000500


Account 5489

Taxmap 51024C000500

Owners Pogue Brian D/Peggy M

Mailing 35103 Highway 26
Seaside, OR 97138-6356

Location 35103 Hwy 26 Seaside

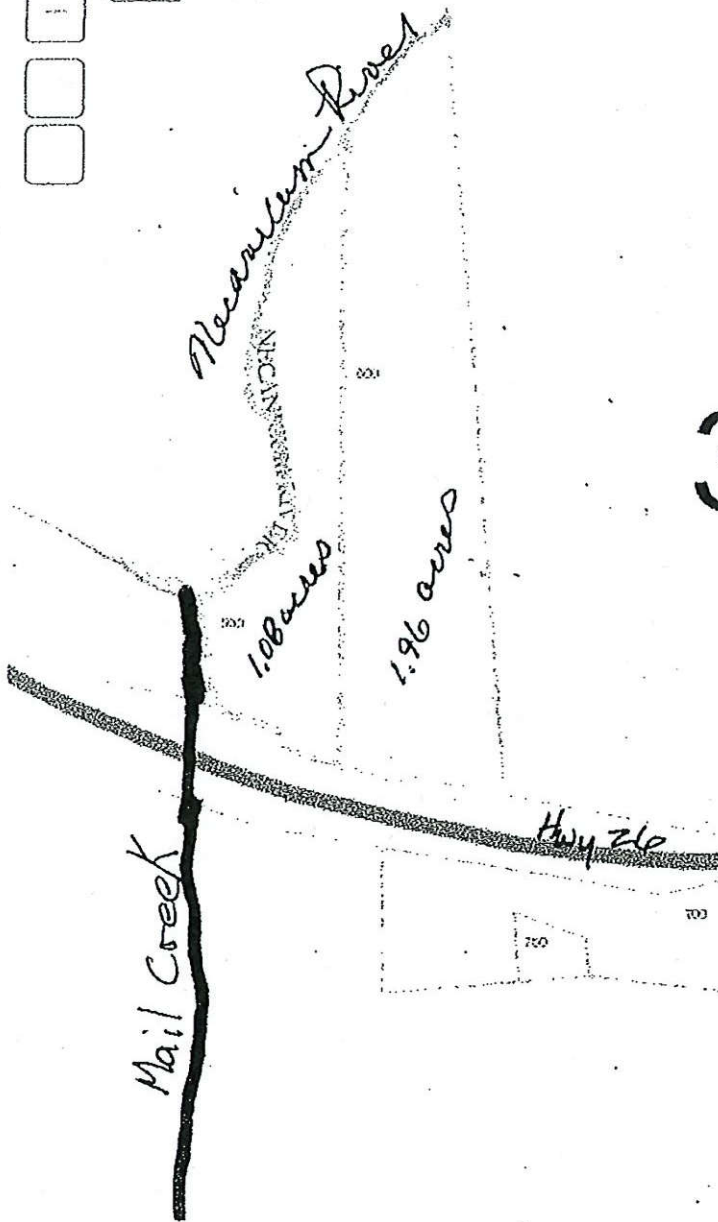

AL-1895