

RECEIVED

OCT 11 2022


OWRD

Lynn A Willis

RECEIVED

NOV 07 2022


OWRD

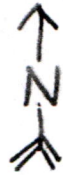

Alternate Reservoir Application Map

Township 5 South, Range 41 East, Section 34 WM, Tax Lot 4803

Scale: 1 inch = 1,320 feet

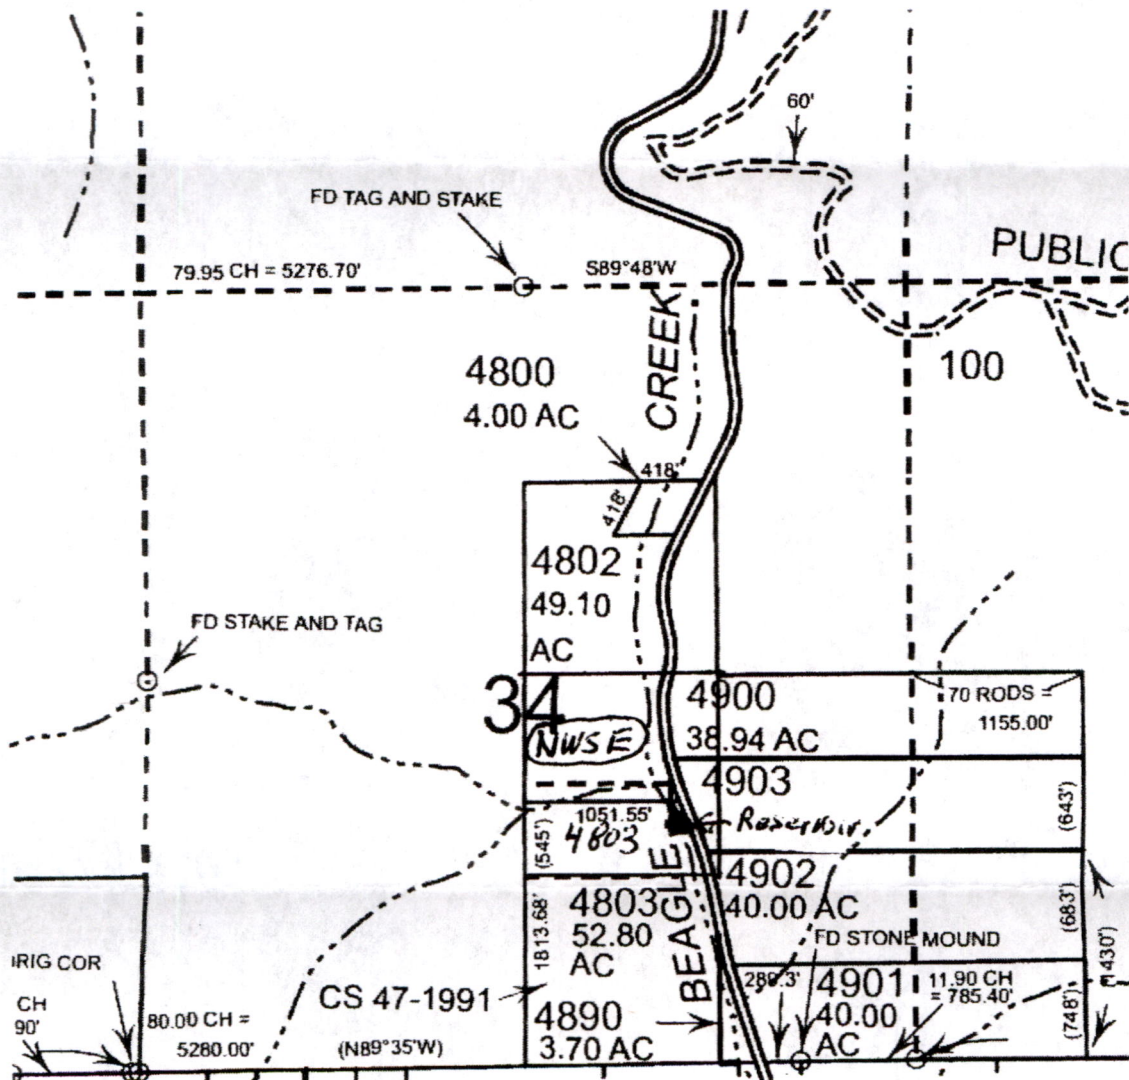

Dam Location: 1575' North and 1560' West from the Southeast Corner of Section 34. Being within the NW ¼ SE ¼ of Section 34.

RECEIVED BY OWRD

MAY 16 2015

SALEM, OR

R 88059