

28 13 11

SECTION 11 T.28S. R.13W. W.M.
COOS COUNTY


1" = 400'

SEE MAP 28 13 2

CANCELLED

- 200
- 400
- 1000
- 1100
- 1201
- 102
- 304
- 308
- 1301
- 501
- 801



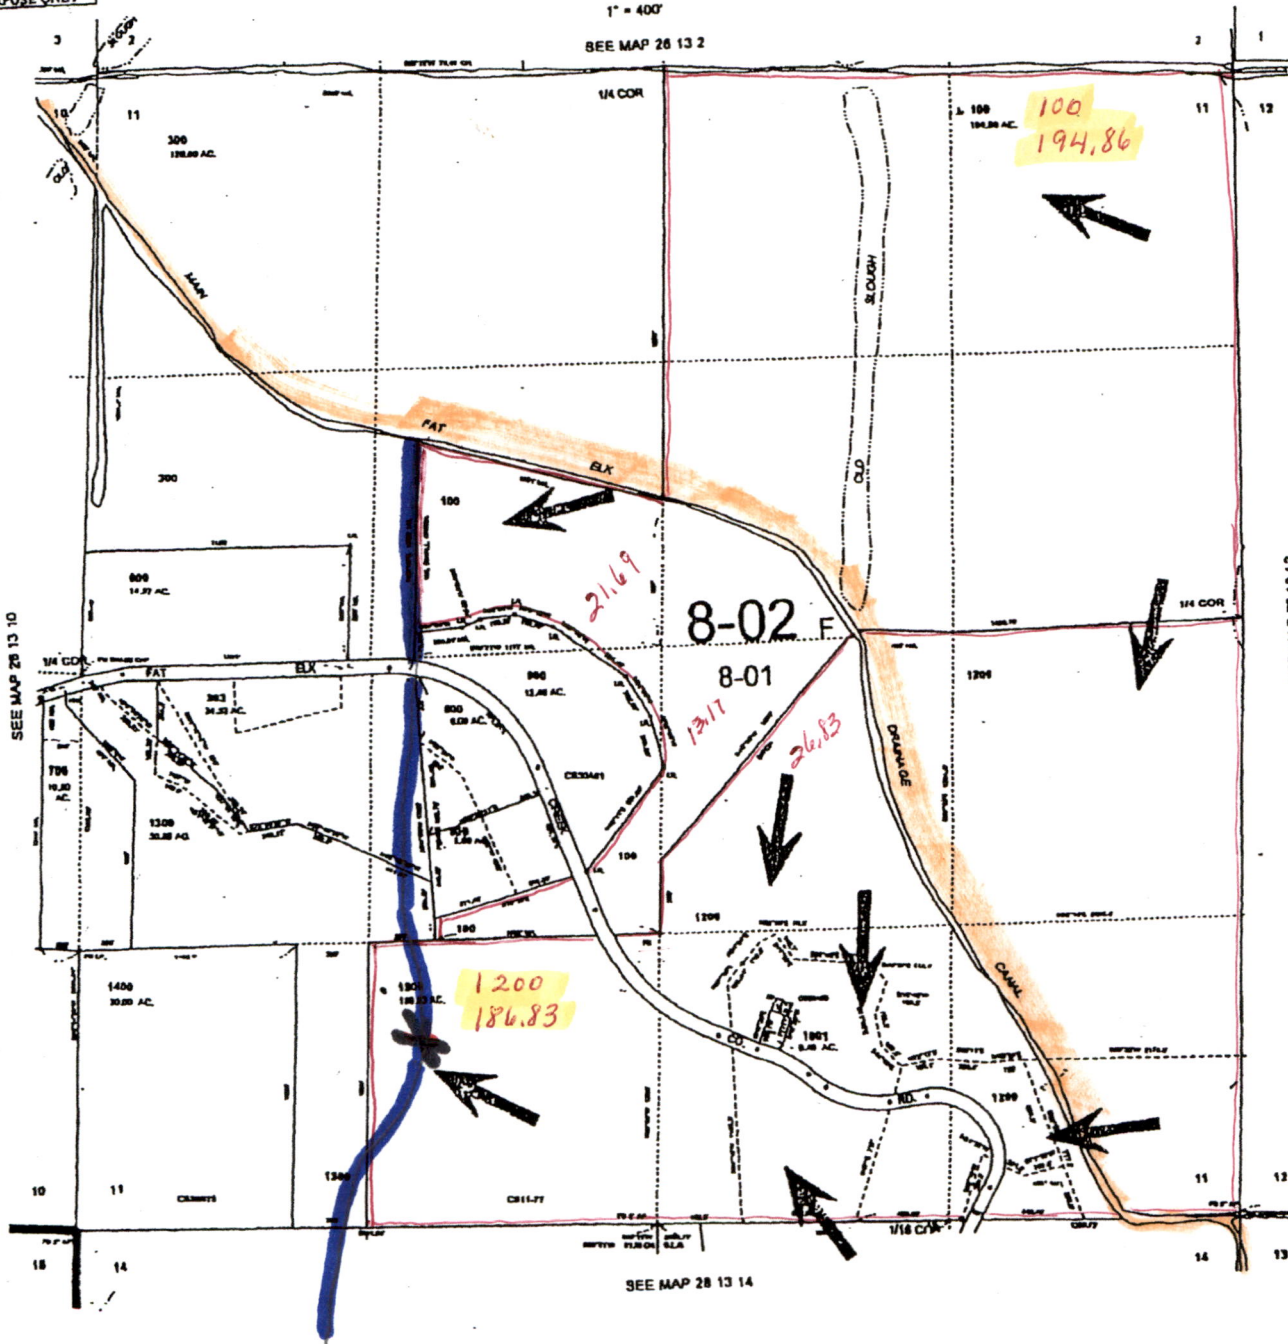

PREPARED FOR PURPOSE ONLY



N Township _____ Range _____ Section _____

This map/plat is being furnished as an aid in locating the herein described Land in relation to adjoining streets, natural boundaries and other land, and is not a survey of the land depicted. Except to the extent a policy of title insurance is expressly modified by endorsement, if any, the Company does not insure dimensions, distances, location of easements, acreage or other matters shown thereon.

TICOR TITLE COMPANY

-  CREEK
-  POINT OF DIVERSION
-  TAX LOT BORDERS
-  FAT ELK DRAINAGE CANAL

11-20-2008
28 13 11