BENSON MEMORIAL POND
CLAIM OF BENEFICIAL USE MAP
PERMIT R-15259 APPLICATION R-88405

827 TRILLER LANE
GRANTS PASS, OR 97527

SITUATED IN SECTION 18
TOWNSHIP 37 SOUTH, RANGE 5 WEST, W.M.

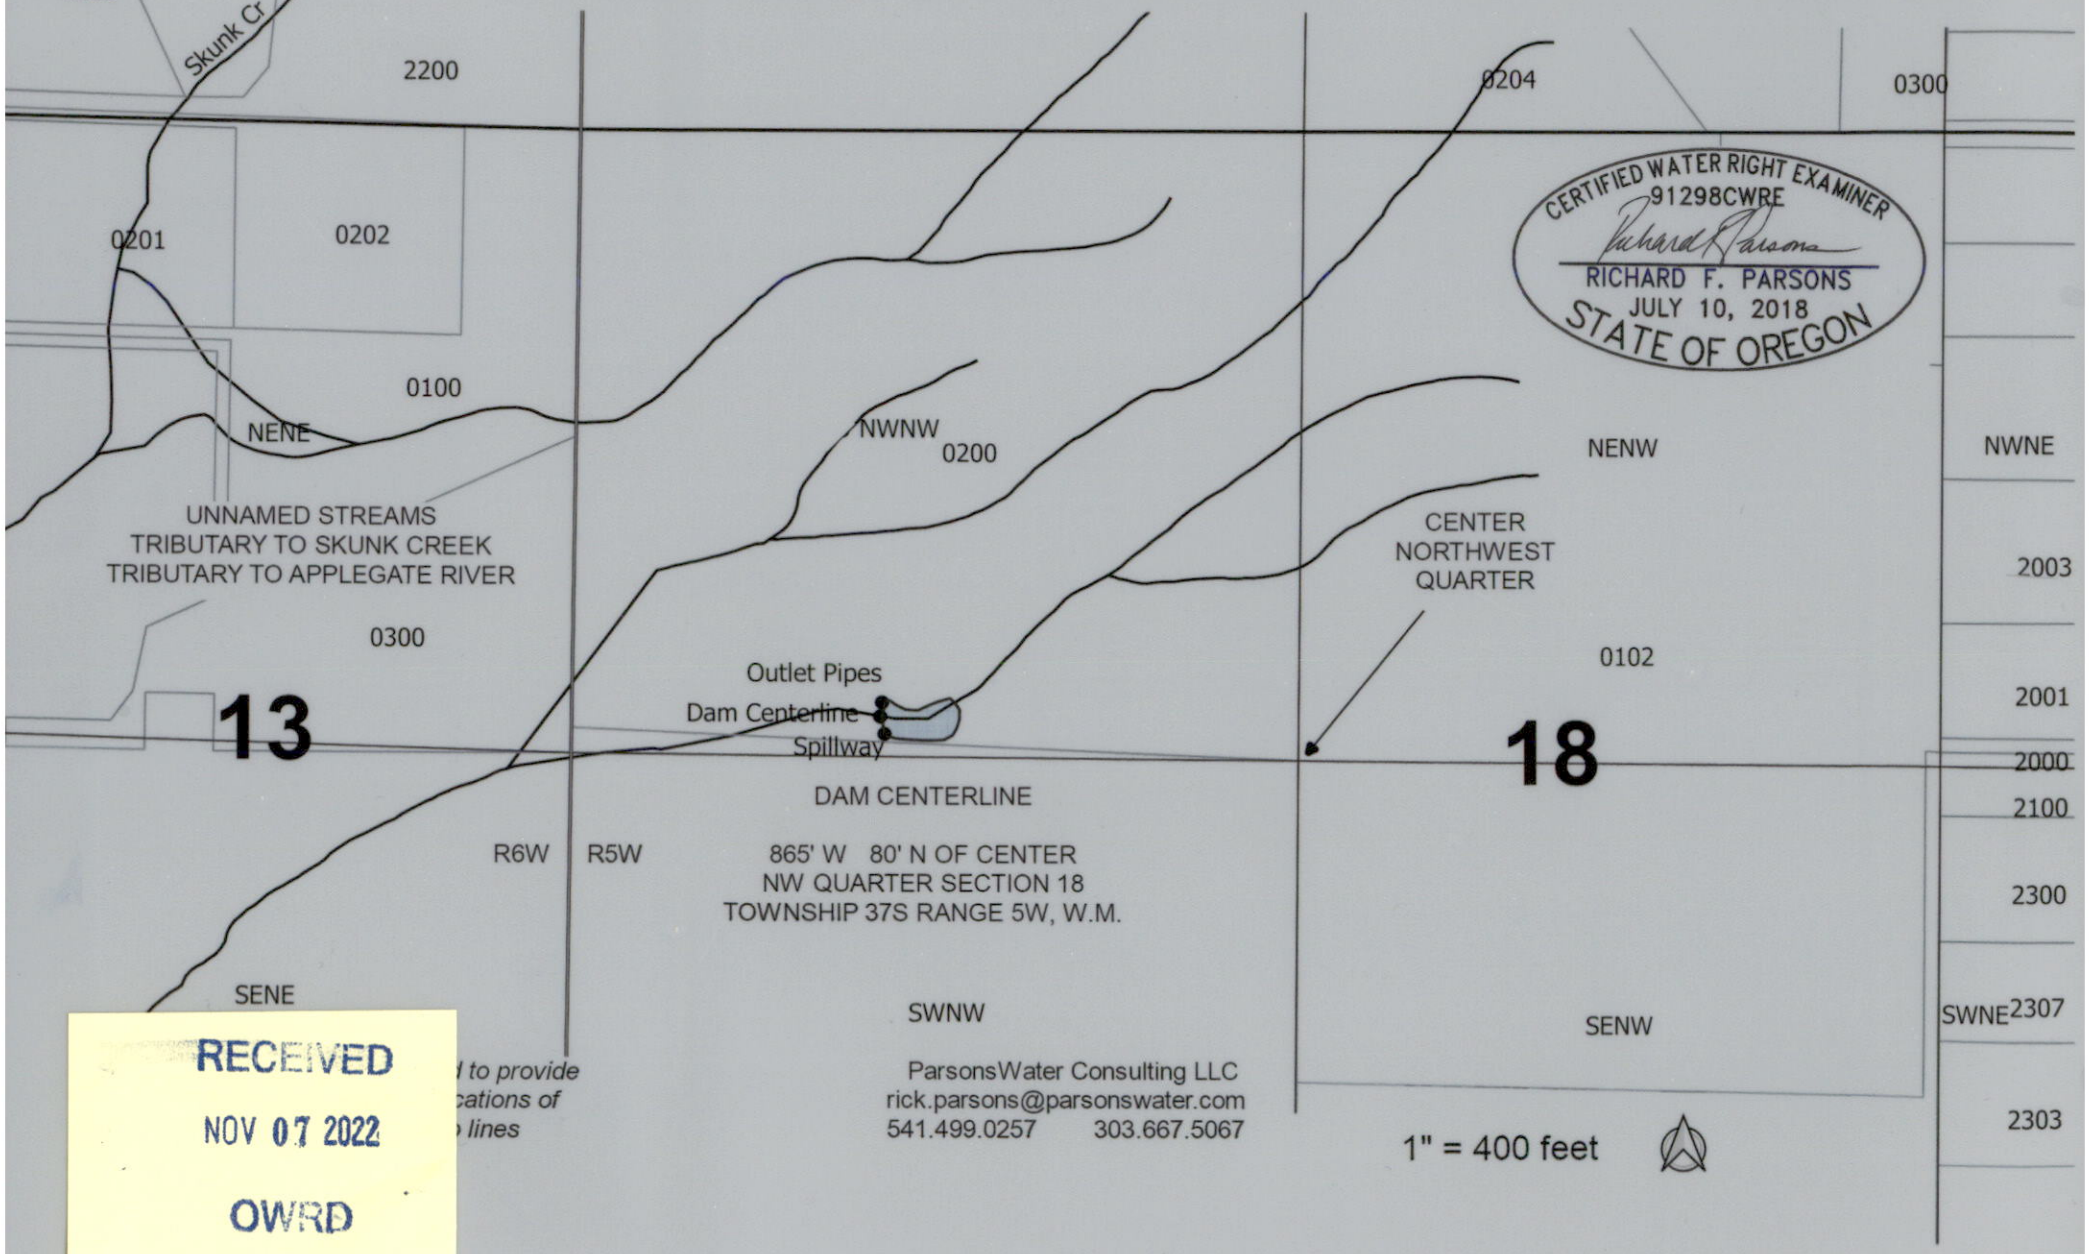

CERTIFIED WATER RIGHT EXAMINER
91298CWRE
RICHARD F. PARSONS
JULY 10, 2018
STATE OF OREGON

l to provide
cations of
lines

ParsonsWater Consulting LLC
rick.parsons@parsonswater.com
541.499.0257 303.667.5067

RECEIVED
NOV 07 2022
OWRD