


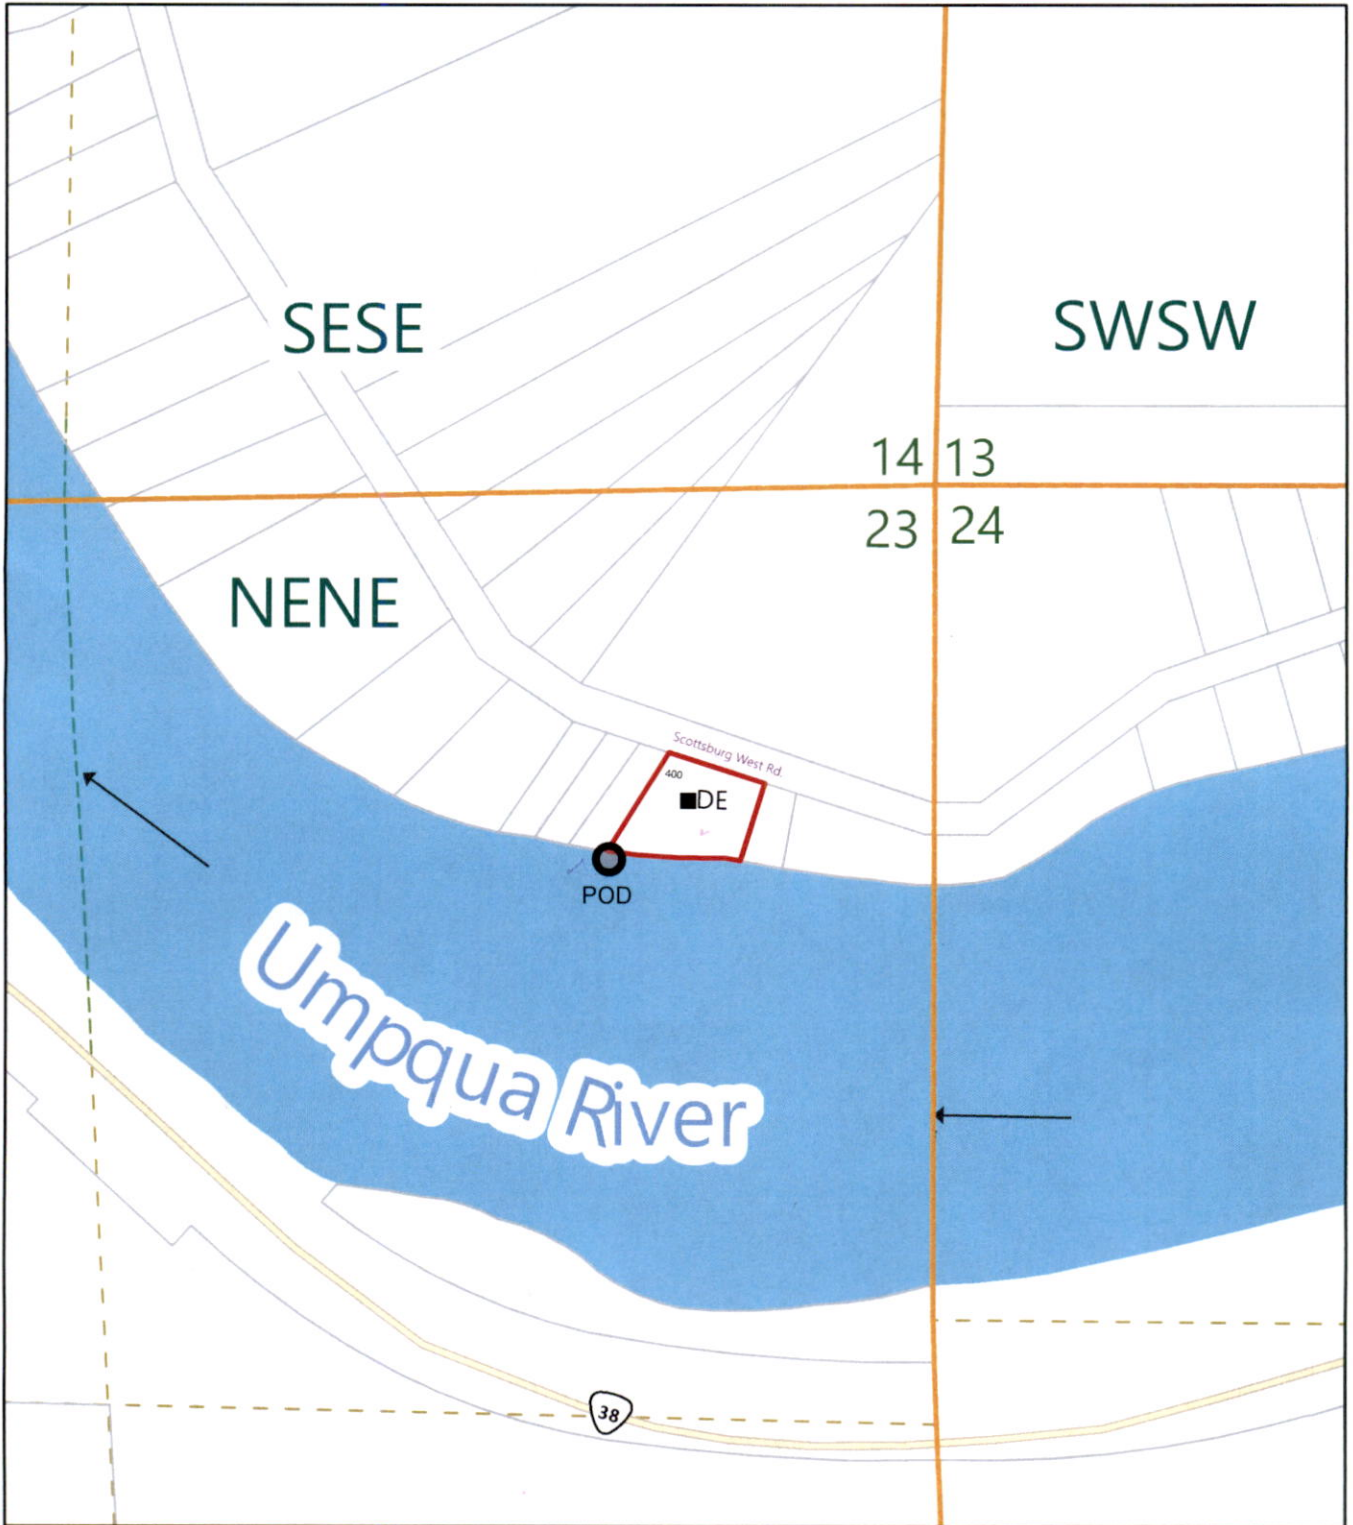

Water Right Application Map  
Colangelo  
T.22S. R.10W. Sections 23  
Douglas County  
Scale: 1" = 400'



Point of Diversion is 551' South and 497' West from the  
North East Corner of Section 23

RECEIVED  
NOV 09 2022  
OWSD

The purpose of this map is to identify  
the location of a Water Right.  
Not intended to show property ownership.