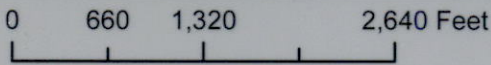
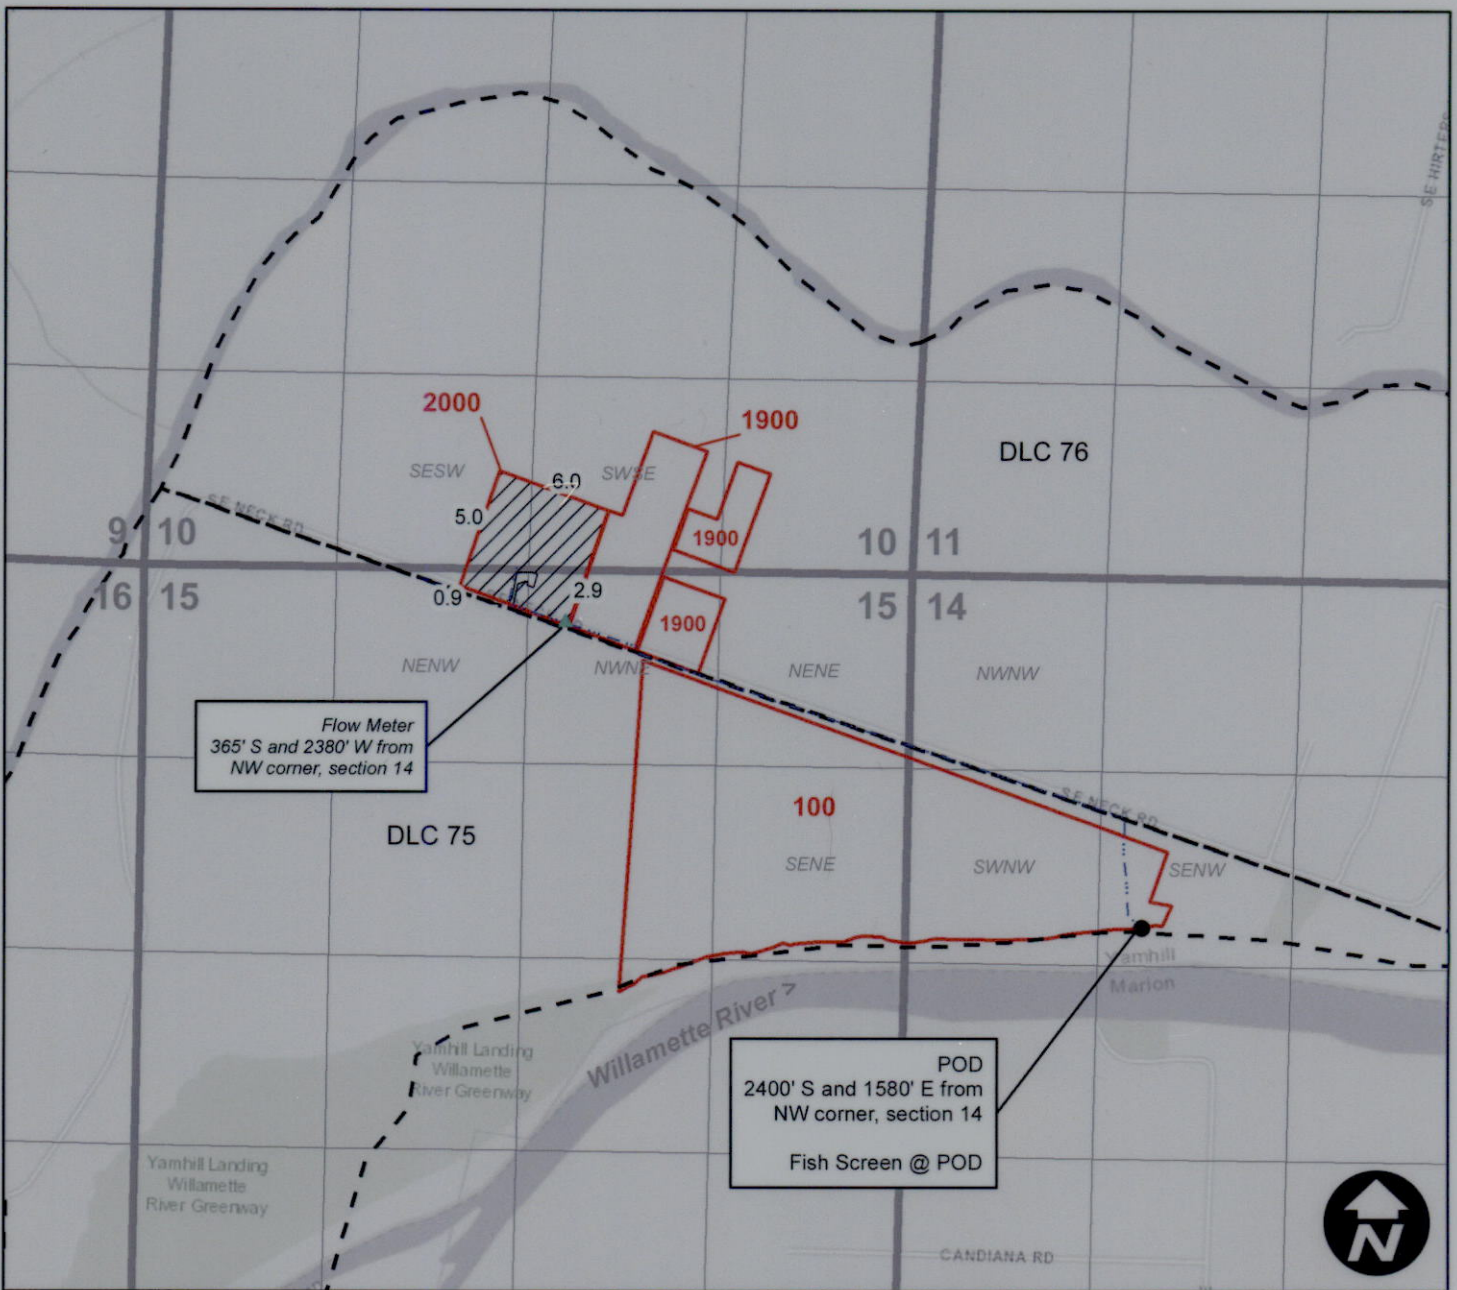


Claim of Beneficial Use - Lorenzen



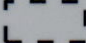
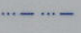
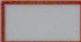
Application S-88522, Permit S-55177

Township 4S, Range 3W, W.M.



This map is not intended to provide legal dimensions or locations of property ownership lines.

Legend

-  POU
-  Flow Meter
-  DL
-  Mainline
-  Taxlot

