
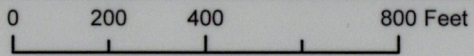



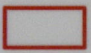
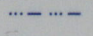
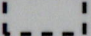
Claim of Beneficial Use - Kirk  
 Application G-16745, Permit G-16287

Township 4S, Range 2W, W.M.

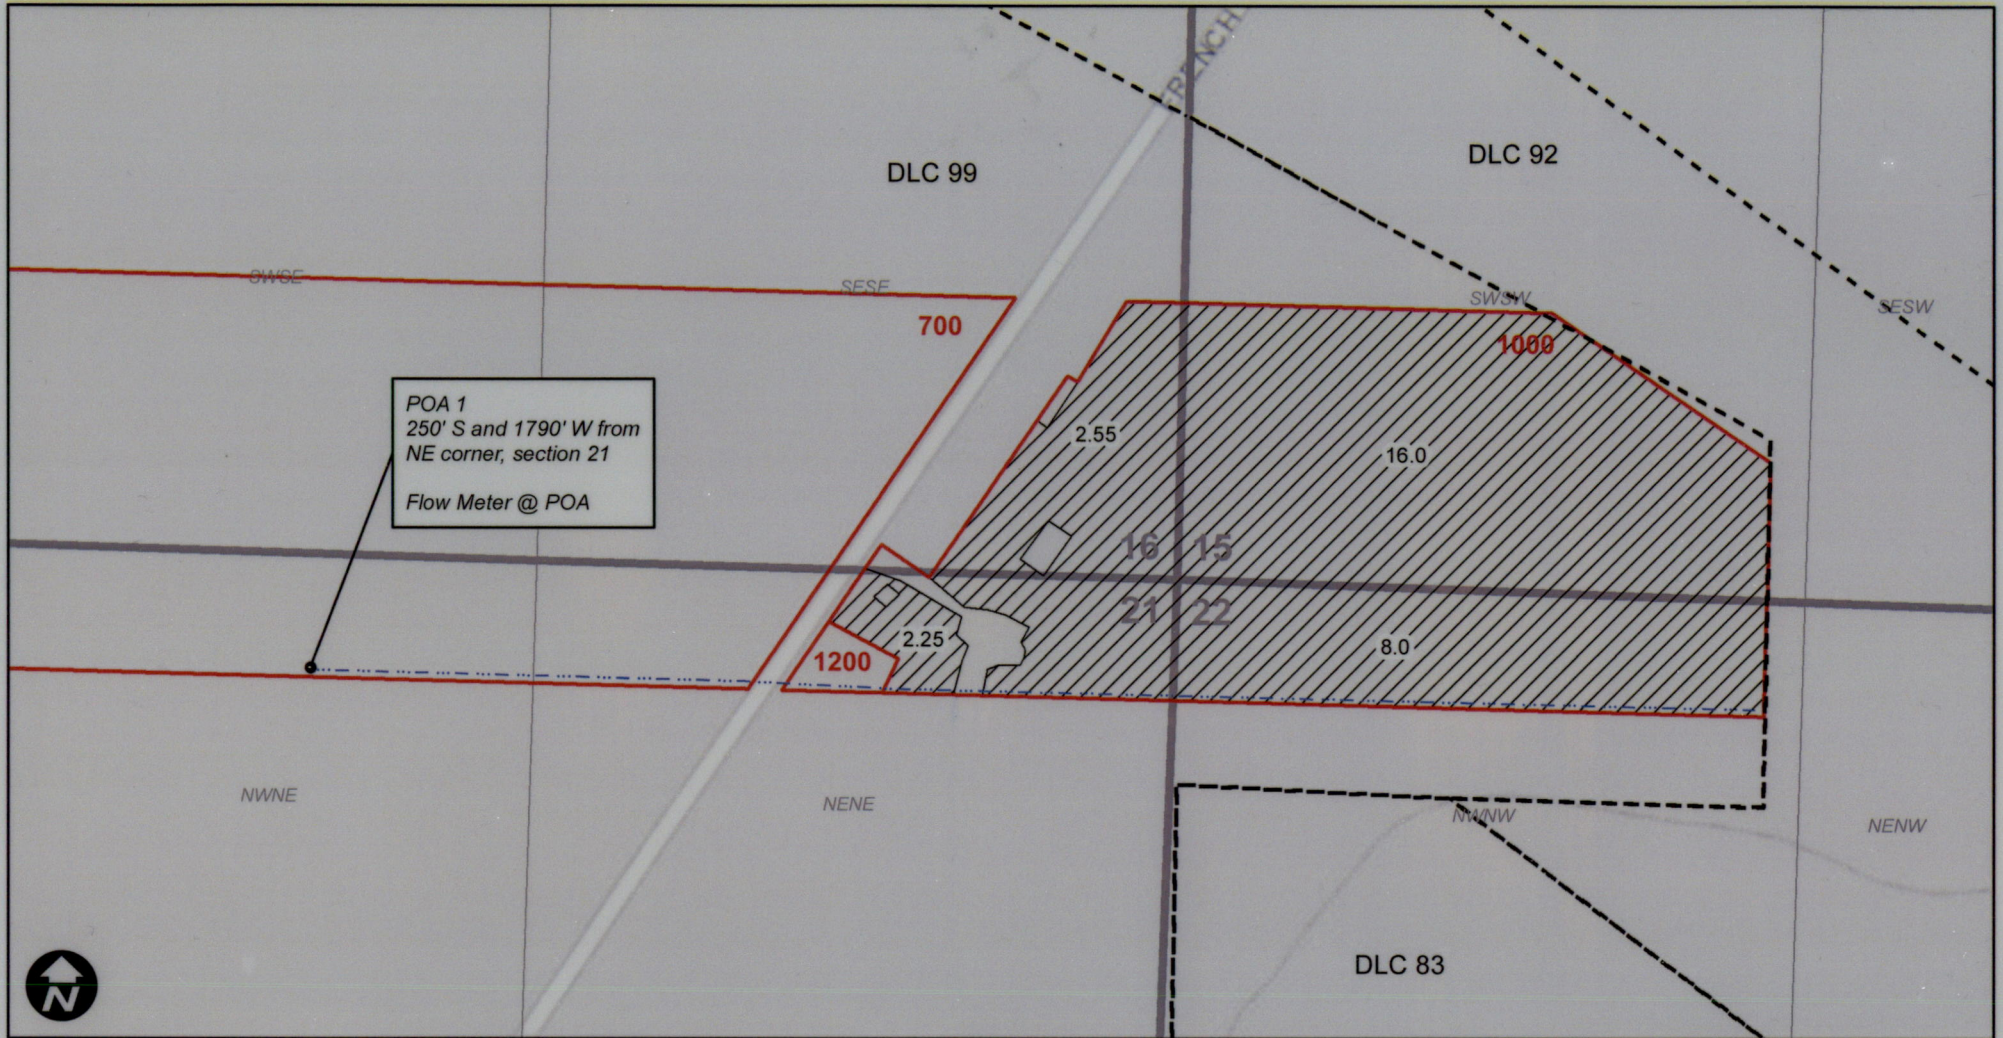

This map is not intended to provide legal dimensions or locations of property ownership lines.

**Legend**

-  Developed POU
-  Taxlot
-  Mainline
-  DLC

