


RENEWAL DATE 12/31/2023


T23S R12W, WM COOS COUNTY, OR

- POD - Spring
- Storage Tank
- Pipeline
- House
- Section
- Quarter Quarter
- Tax Lot

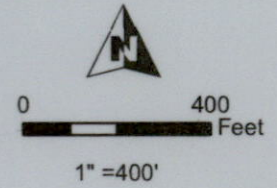

RECEIVED
AUG 24 2022

OWRD

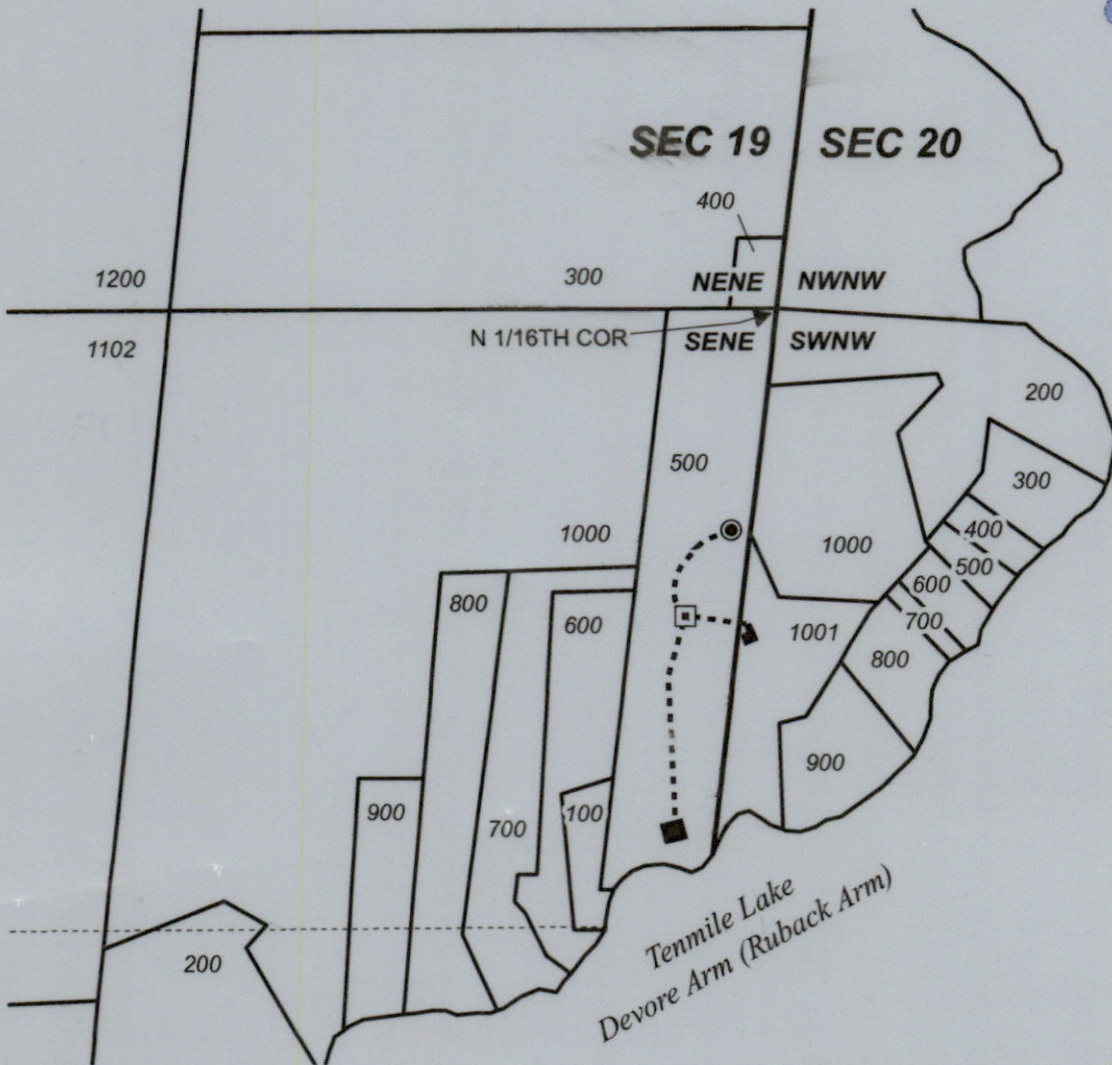

POD Location:
470' S, 100' W of N 1/16th Cor
Common to Section 19 & 20



Date: 7/16/2022

Claim of Beneficial Use Map Peleti

Ap S-85266 Permit S-53937

Project #22018

This map is not intended to provide legal dimensions or locations of property ownership lines.

WATER RIGHT SERVICES, LLC
PO BOX 1830, BEND, OR 97709
WWW.OREGONWATER.US CCB # 197121
johnshort@usa.com 541-389-2837