


T.4S. R.2W. Sec. 31, 32 & 33 T.5S. R.2W. Sec. 4, 5 & 6, W.M.

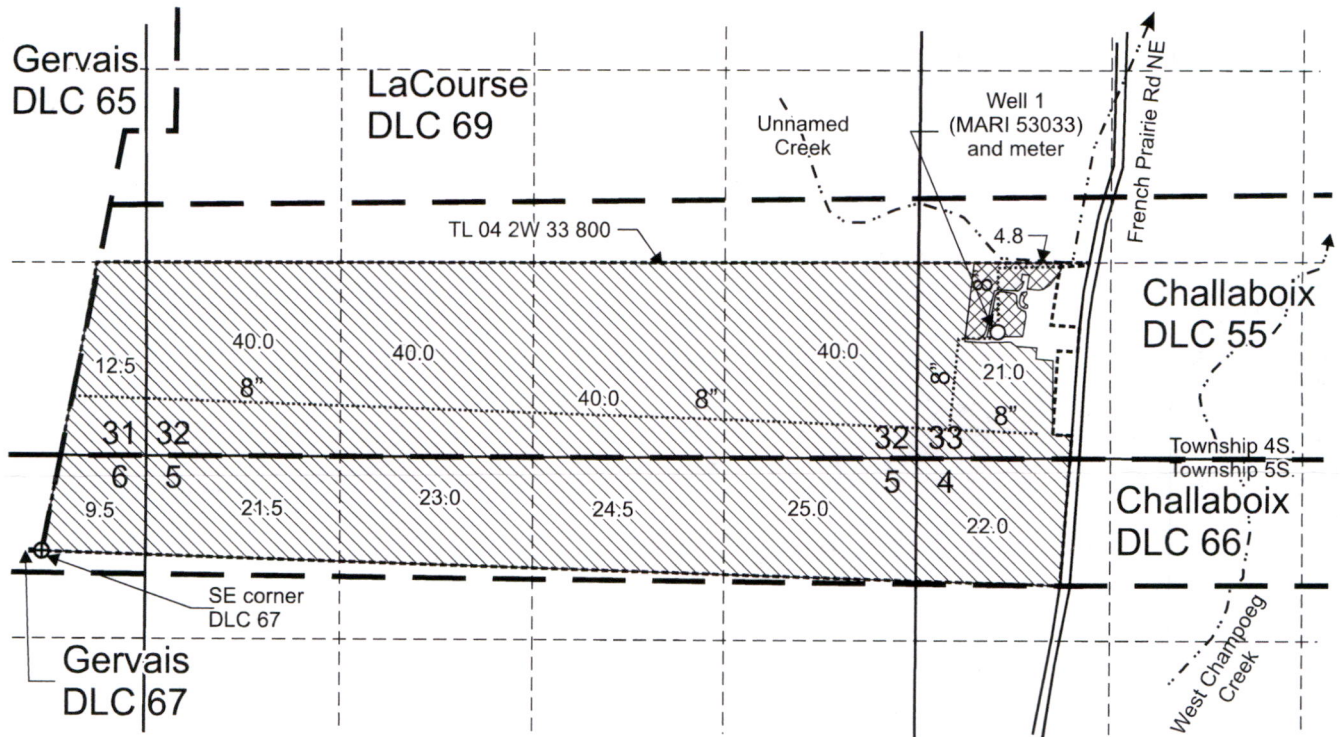

Well 1 (MARI 53033) is located 1,500 feet north and 6,550 feet east from the SE corner DLC 67.

 Area (319 Acres) of irrigation under Application G-14504, Permit G-13358.

 Area (4.8 Acres) of irrigation and agricultural use for nursery operations under Application G-14504, Permit G-13358.


----- Tax lot boundary

— ■ — Donation Land Claim boundary

..... Water main line



Scale: 1" = 1,320'

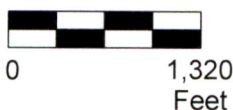

This map was prepared for the purpose of identifying the location of a water right only and is not intended to provide legal dimensions or location of property ownership lines.

Claim of Beneficial Use Map
Application G-14504, Permit G-13358
John and Karren Pohlschneider
T.4S. R.2W. Sec. 31, 32 & 33,
T.5S. R.2W. Sec. 4, 5 & 6, W.M.

Pacific Hydro-Geology Inc.

11/2022

RECEIVED
NOV 28 2022
OWRD

