


**T15S R12E, WM
DESCHUTES COUNTY, OR**

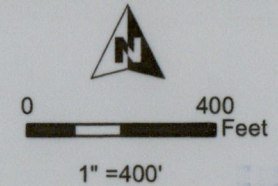


- Well
- POU IR
- Section
- Quarter Quarter
- Tax Lot


Well Locations:

Well #1 (DESC 3501):
2500' N, 1290' E of SW Cor Sec 11

Well #2 (DESC 3512):
2610' N, 1530' E of SW Cor Sec 11

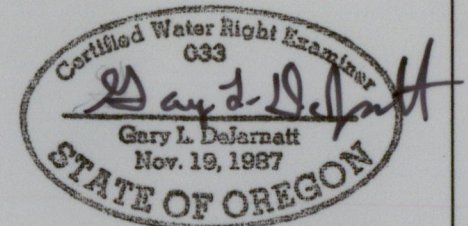

RENEWAL DATE 12/31/2023

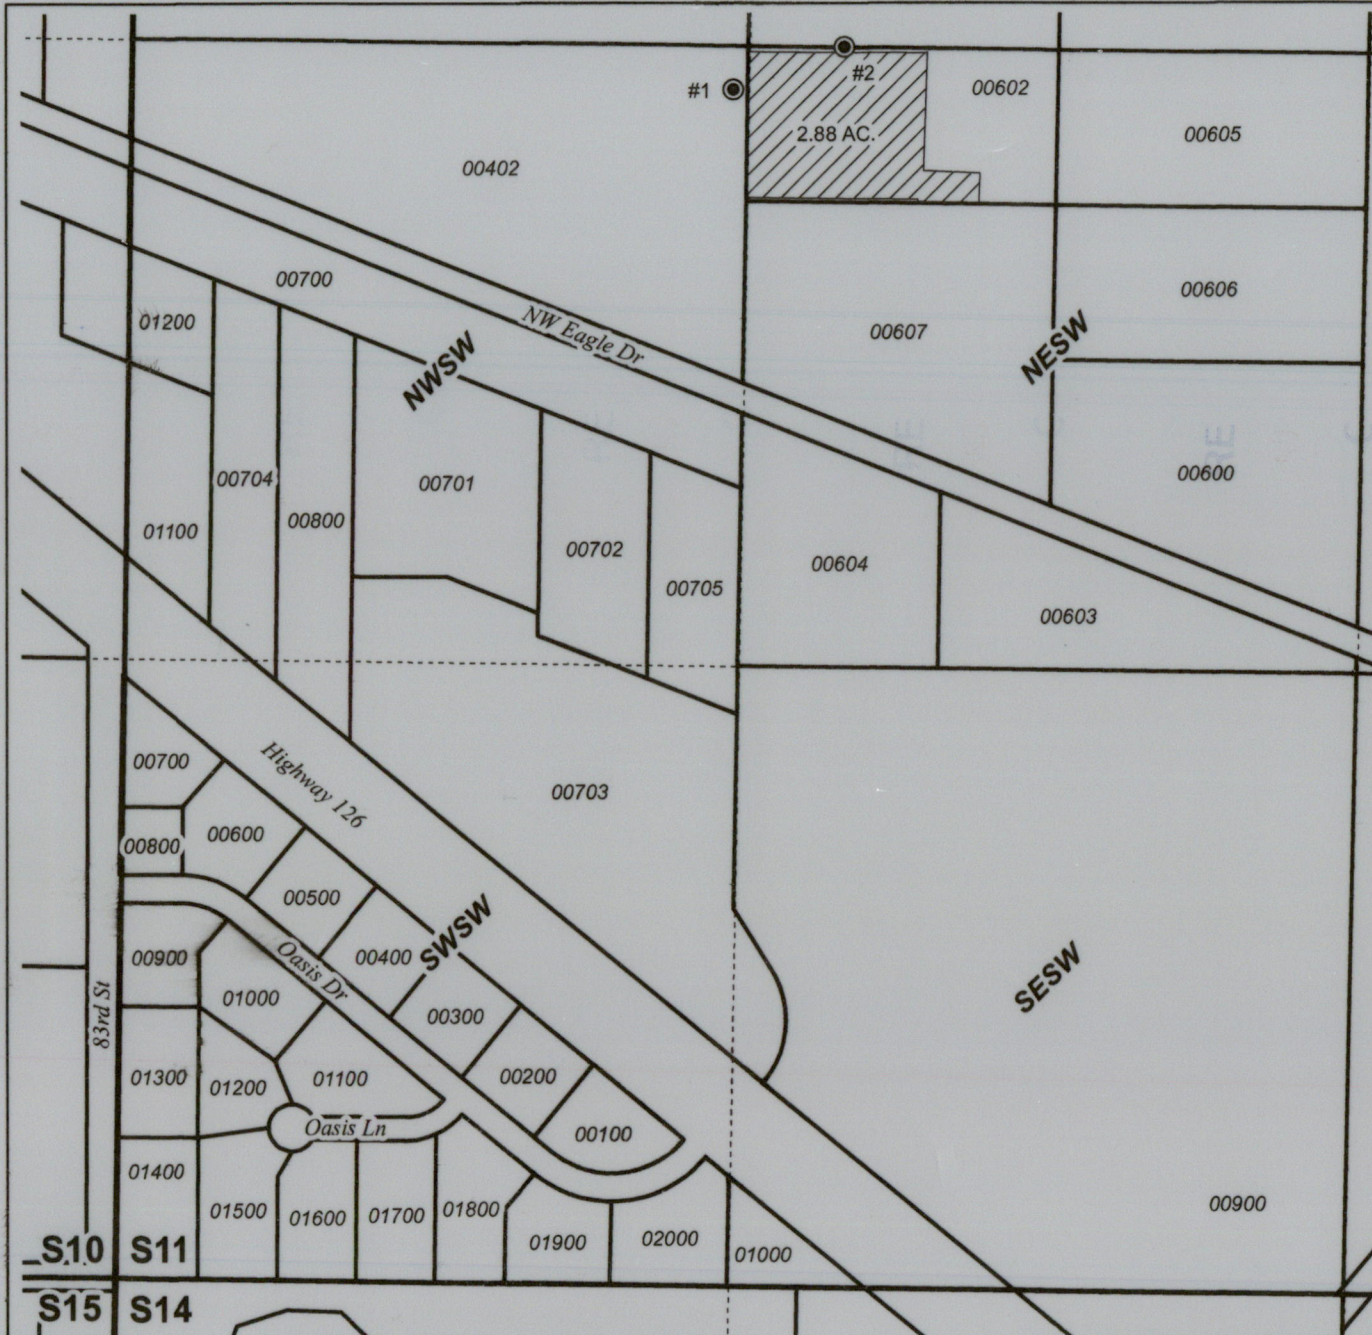

**CLAIM OF BENEFICIAL USE MAP
Richard Sachse**

Date: 8/24/2022

T-12410

Project #22046

This map is not intended
to provide legal dimensions
or locations of property
ownership lines.

WATER RIGHT SERVICES, LLC
PO BOX 1830, BEND, OR 97709
WWW.OREGONWATER.US CCB # 197121
johnshort@usa.com 541-389-2837

RECEIVED

NOV 01 2022

OWRD