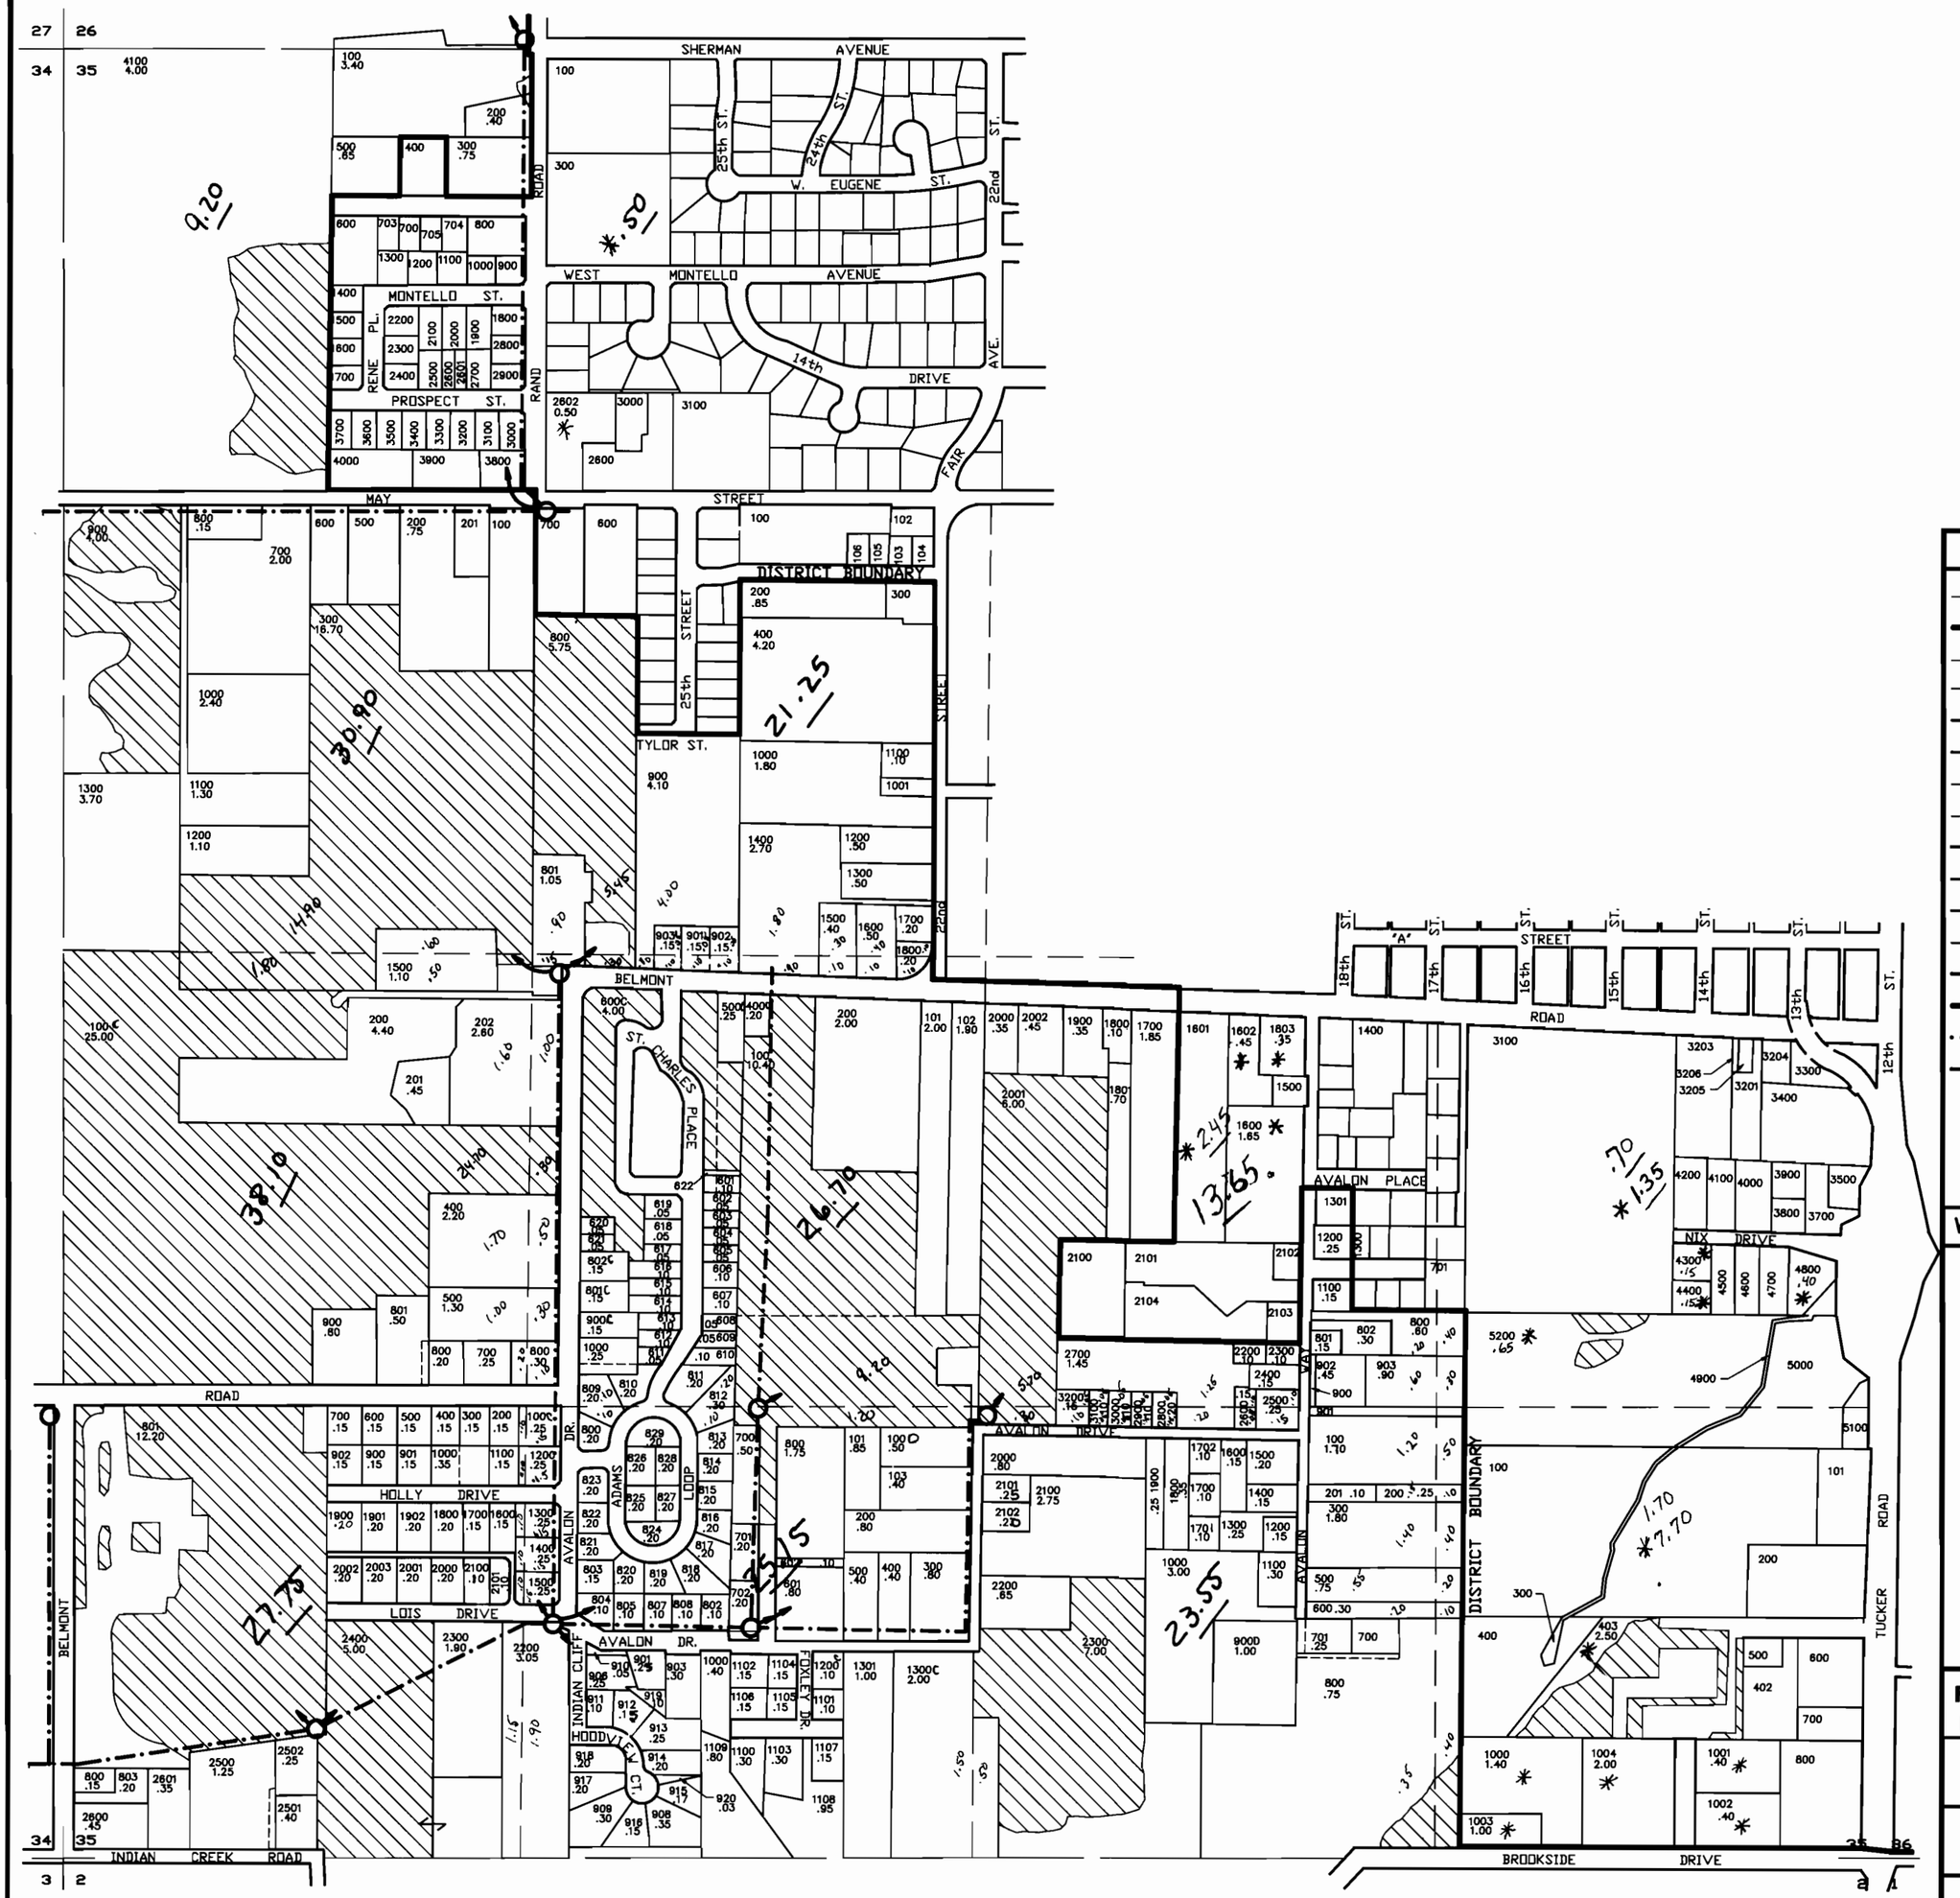

MAP SYMBOL LEGEND

- SECTION LINE
- DISTRICT BOUNDARY
- QTR–SECTION LINE
- PROPERTY LINE
- RIGHT OF WAY
- PRIVATE ROAD
- DLC LINE
- EASEMENT
- RIVER
- CANAL
- CREEK
- B.P.A. EASEMENT
- PIPE
- PENSTOCK
- OPEN DITCH
- TURNOUT BOX
- PUMP FROM FARMERS DITCH
- P — RAINY CREEK PERMIT

WATER RIGHTS CERTIFICATES LEGEND

- C–46954
- C–46955
- C–46956
- C–47710
- C–63288

FARMERS IRRIGATION DISTRICT

HOOD RIVER OREGON

SECTION 35 T3N R10E

REVISION DATE: MAY 4, 1994

0 200 400 600 800

SCALE: 1" = 400'

Gray & Osborne, Inc.