


FINAL PROOF SURVEY MAP IN THE NAME OF JOHN A. MCMAHON

APPLICATION G-13268


PERMIT G-13082

SECTION 8, TOWNSHIP 29 SOUTH, RANGE 14 WEST, W.M.

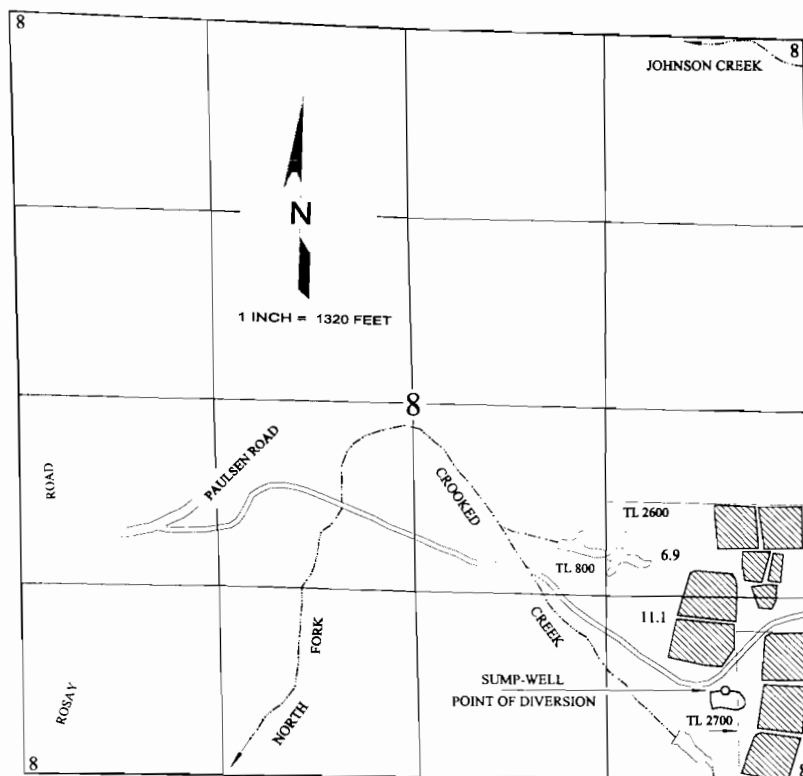

THE SUMP-WELL POINT OF DIVERSION IS LOCATED 630 FEET NORTH AND 600 FEET WEST FROM THE SOUTHEAST CORNER OF SECTION 8, BEING WITHIN THE SE $\frac{1}{4}$ SE $\frac{1}{4}$ OF SECTION 8, TOWNSHIP 29 SOUTH, RANGE 14 WEST, W.M.; COOS COUNTY.

THE PURPOSE OF THIS MAP IS TO IDENTIFY THE LOCATION OF THE WATER RIGHT.
IT IS NOT INTENDED TO PROVIDE INFORMATION RELATIVE TO THE LOCATION OF
PROPERTY OWNERSHIP BOUNDRY LINES.

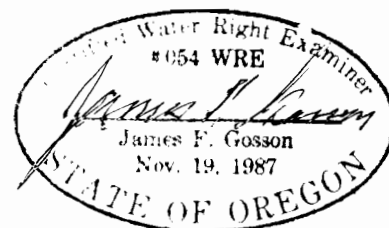

Same map SW 1/4 SW

6 17.55 AMENDED
BY THIS MAP
(MORE LAND IRR.)


APPLICATION MAP

IN THE NAME OF JOHN A. MC MAHON

SECTION 8, T29S, R14W, W.M.



SCALE: 1 INCH = 1320 FEET

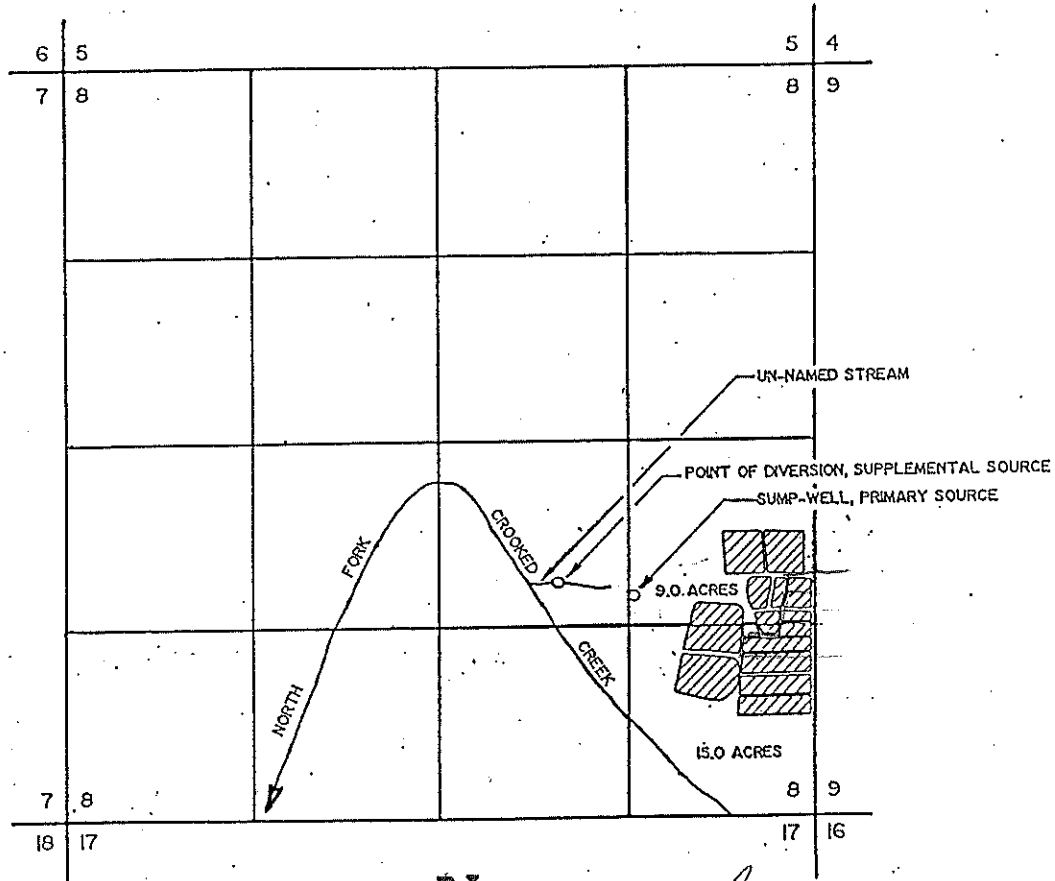


Application No. C 13268
Permit No.

(See R-64734/5)

THE POINT OF DIVERSION FROM THE SUMP WELL IS TO BE LOCATED 1550 FEET NORTH AND 1300 FEET WEST FROM THE SOUTHEAST CORNER OF SECTION 8, BEING WITHIN THE NE 1/4 OF THE SE 1/4 OF SECTION 8.

THE POINT OF DIVERSION FROM THE UN-NAMED STREAM IS TO BE LOCATED 1650 FEET NORTH AND 1800 FEET WEST FROM THE SOUTHEAST CORNER OF SECTION 8, BOTH POINTS OF DIVERSION BEING WITHIN TOWNSHIP 29 SOUTH, RANGE 14 WEST, W.M., COOS COUNTY.

THE PURPOSE OF THIS MAP IS TO IDENTIFY THE LOCATION OF THE WATER RIGHT. IT IS NOT INTENDED TO PROVIDE INFORMATION RELATIVE TO THE LOCATION OF PROPERTY OWNERSHIP BOUNDARY LINES.

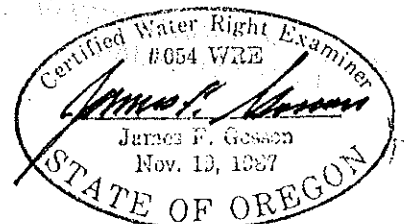

T. 29 S., R. 14 W., W.M.
Section 8

Scale 1" = 400'

2.5 A

5.2 A

IRRIGATION
HARVESTING
& TEMPERATURE CONTROL

RECEIVED

JUN - 9 1976

WATER RESOURCES DEPT
SALEM, OREGON

317 N.

P.O.D.

Res.

980' W.

8

9

17

16

N. Fork Crooked Creek


Application No. R-54362, 54363
Permit No. R-6495, 40691

THIS MAP PREPARED BY: Francis P. Cogswell
FROM INFORMATION FURNISHED BY THE
APPLICANT.

Map 4 of 4

AMENDED APPLICATION MAP IN THE NAME OF JOHN A. MC MAHON
APPLICATIONS R-69934 AND 69935
SECTION 8, T29S, R14W, W.M.

1 INCH=400 FEET

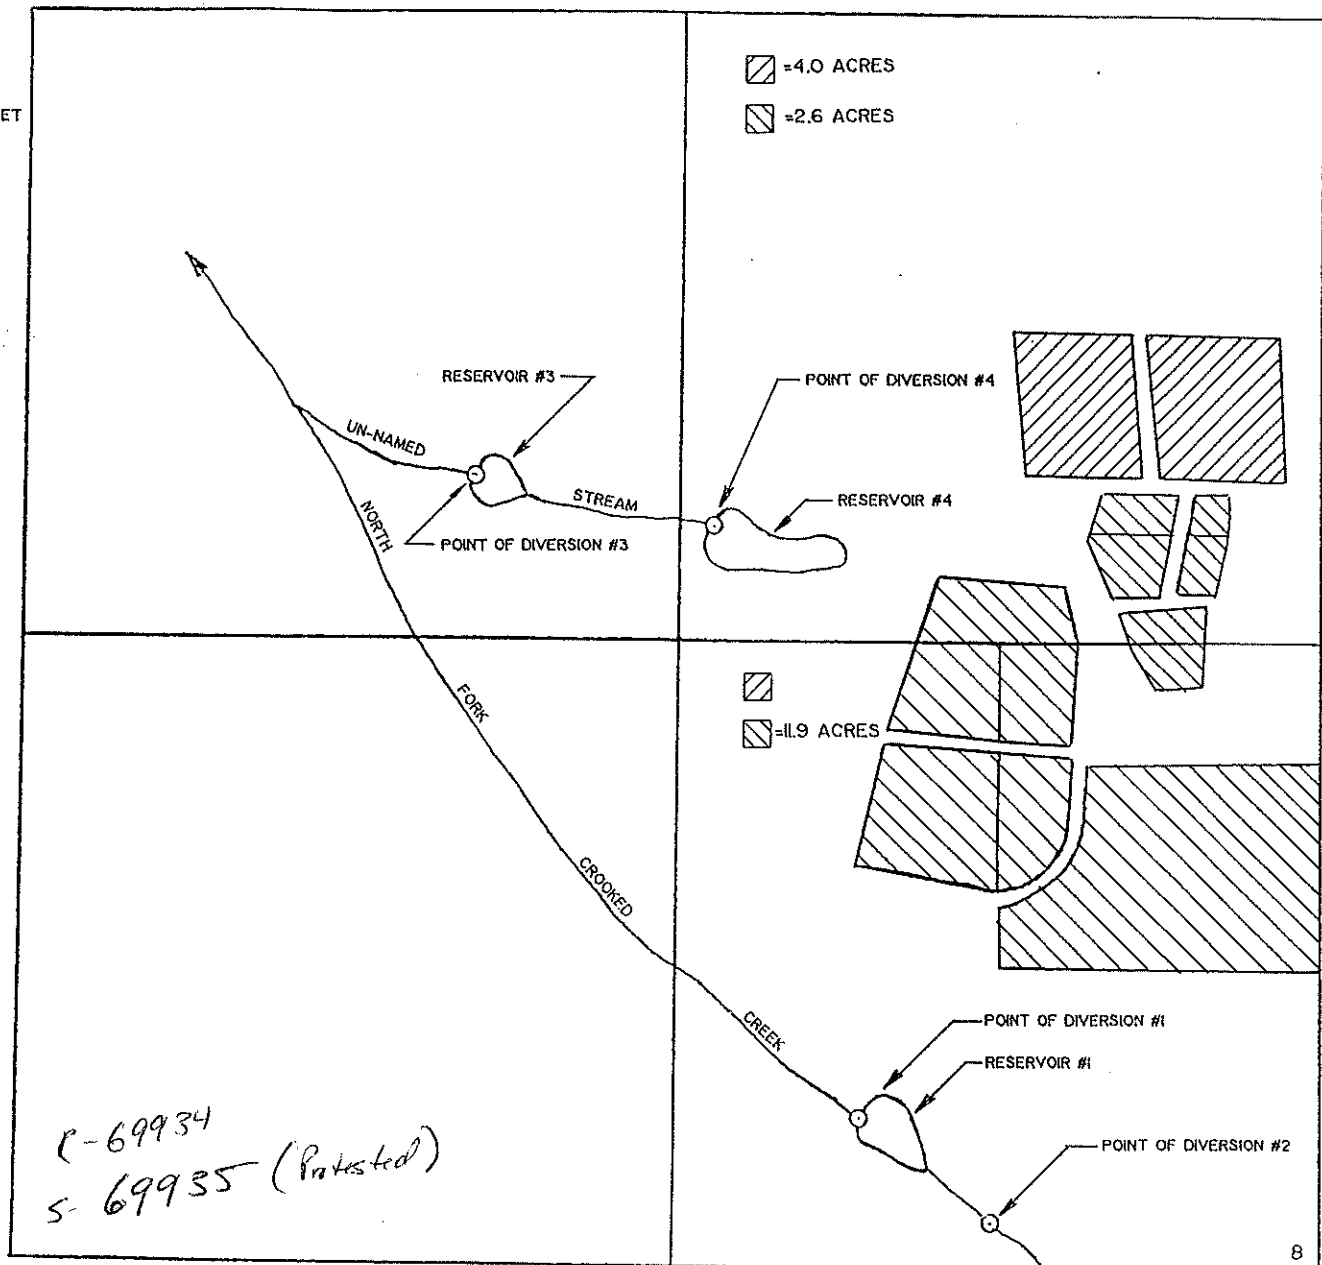

- ☒ CRANBERRY USE
- ☒ SUPPLEMENTAL CRANBERRY USE

FROM POINT OF DIVERSION #4, AND RESERVOIR #4.

POINT OF DIVERSION #4 IS TO BE LOCATED 1550 FEET NORTH AND 1300 FEET WEST FROM THE SOUTHEAST CORNER OF SECTION 8, BEING WITHIN THE NORTHEAST 1/4 OF THE SOUTHEAST 1/4 OF SECTION 8, TOWNSHIP 29 SOUTH, RANGE 14 WEST, W.M., COOS COUNTY.

THE PURPOSE OF THIS MAP IS TO IDENTIFY THE LOCATION OF THE WATER RIGHT. IT IS NOT INTENDED TO PROVIDE INFORMATION RELATIVE TO THE LOCATION OF PROPERTY OWNERSHIP BOUNDARY LINES.

