



Oregon Water Resources Department
 725 Summer Street NE, Suite A
 Salem, Oregon 97301
 (503) 986-0900
 www.oregon.gov/OWRD

Ownership Update for Certificated Rights Only

NO FEES ARE REQUIRED TO SUBMIT THIS FORM

NOTICE: A certificate of water right typically stays with the land. To track water right ownership, the Department requests that this form be submitted to the Department. **To update multiple rights, a separate form is required for each right.** If you have any questions about this form, please contact your local watermaster, or call the Water Resources Department at (503) 986-0900.

Note: Use the [assignment](#) form to change ownership on pending applications, permits, transfers, groundwater registrations, or limited licenses.

| Current Landowner Information | | | | |
|-------------------------------|-------------------------------------|--------|---------------------|------------|
| Name: | Rattlesnake Creek Land + Cattle Co. | | | |
| Mailing Address: | 524 N. Hwy 20 | | | |
| City: | Hines | State: | OR | Zip: 97738 |
| Phone: | 541-589-0107 | Email: | andyjroot@gmail.com | |

| Property Information | | | | |
|--------------------------------|---|-----------|-------|-----------------------------|
| County: | Harney | Township: | 23/22 | Range: 33/33 Section: 04/33 |
| Tax Lot #: | 22533e Sec. 33 TL 2002, 23533e Sec. 04 TL 500 | | | |
| Street Address of Water Right: | | | | |

| Water Right Information | | RECEIVED | |
|--|--------|---|-----------------------------|
| Application: | | JUN 06 2022 | |
| Permit: | G-8847 | | |
| Certificate: | 65932 | OWRD | |
| Are all the lands associated with this water right owned by the requestor? | | <input checked="" type="checkbox"/> Yes | <input type="checkbox"/> No |
| (If no, include a map showing the portion of the water right involved) | | | |

| Signature and Date | | |
|-------------------------------------|----------------|---------------|
| Name of individual completing form: | Paul Blackburn | |
| Phone or email: | 541-589-0025 | Date: 5/21/22 |
| Signature of requestor: | | |

The Department does not change names on water right certificates. This form will be placed in the file for future reference only. If mailed, the Department will not provide acknowledgment of receipt.

This form can be mailed to the address above or sent by email to wrd_dl_customerservice@water.oregon.gov

STATE OF OREGON
COUNTY OF HARNEY
CERTIFICATE OF WATER RIGHT

THIS CERTIFICATE ISSUED TO

DONALD B. TRUNNELL
P.O. BOX 278
AGUANGA, CALIFORNIA 92302

confirms the right to use the waters of A WELL in the COW CREEK BASIN for the purpose of SUPPLEMENTAL IRRIGATION OF 55.8 ACRES.

The right has been perfected under Permit G-8429. The date of priority is JUNE 12, 1978. The right is limited to not more than 0.70 CUBIC FOOT PER SECOND or its equivalent in case of rotation, measured at the well.

The well is located as follows:

NE 1/4 NW 1/4, SECTION 4, T 23 S, R 33 E, W.M.; 100 FEET SOUTH AND 720 FEET WEST FROM THE SOUTH 1/4 CORNER OF SECTION 33.

The amount of water used for irrigation, together with the amount secured under any other right existing for the same lands, shall be limited to ONE-EIGHTIETH of one cubic foot per second per acre, or its equivalent for each acre irrigated and shall be further limited to a diversion of not to exceed 3.0 acre-feet per acre for each acre irrigated during the irrigation season of each year.

This right is limited to any deficiency in the available supply of any prior right existing for the same land.

The right shall conform to such reasonable rotation system as may be ordered by the proper state officer.

A description of the place of use under the right, and to which such right is appurtenant, is as follows:

NE 1/4 SW 1/4 8.5 ACRES
SE 1/4 SW 1/4 36.0 ACRES
NW 1/4 SE 1/4 2.4 ACRES
SW 1/4 SE 1/4 8.9 ACRES

SECTION 33
TOWNSHIP 22 SOUTH, RANGE 33 EAST, W.M.

RECEIVED

JUN 06 2022

OWRD

The right to the use of the water for the above purpose is restricted to beneficial use on the lands or place of use described.

WITNESS the signature of the Water Resources Director, affixed JUNE 10, 1991.


/s/ WILLIAM H. YOUNG

William H. Young

Recorded in State Record of Water Right Certificates numbered 65932.

G-8847.JW

T. 22 & 23 S., R. 33 E., WM

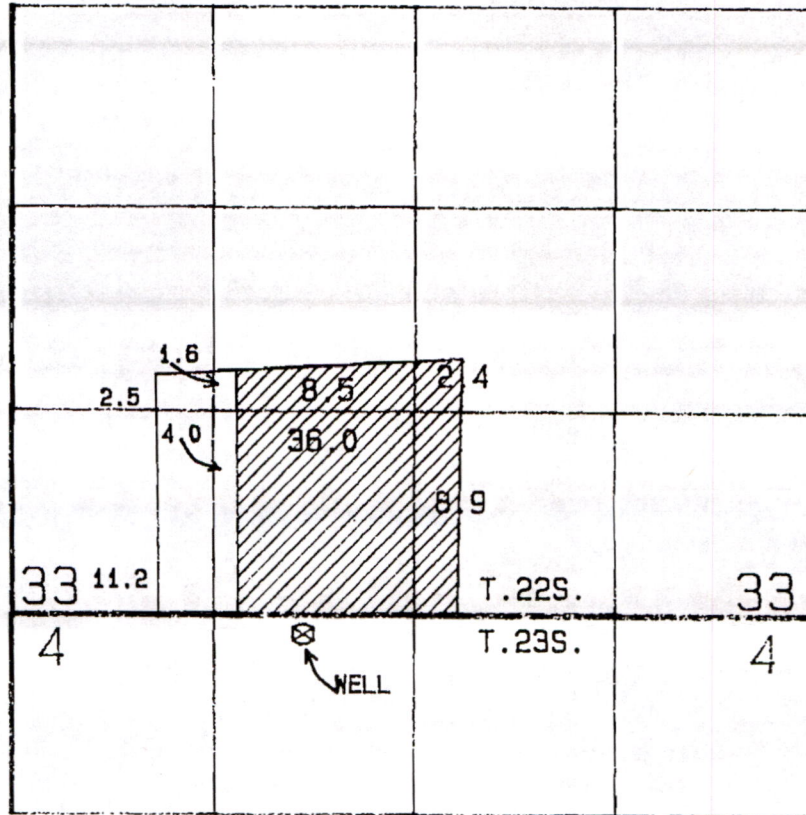

WELL LOCATED: 100 FT SOUTH AND 720 FT WEST FROM
THE SOUTH 1/4 CORNER SECTION 33.
SCALE 1 IN = 1320 FT

FINAL PROOF SURVEY
UNDER

APPLICATION NO.: G-8847 PERMIT NO.: G-8429
IN THE NAME OF
DONALD B. TRUNELL

SURVEYED MAY 20, 1986 BY: LARRY TOLL

RECEIVED

JUN 06 2022

OWRD

COMPUTER DRAFTED: TMW
PTS-1986-V-A.