


Claim of Beneficial Use - Orient Holdings, LLC

Transfer T-12697

Township 1S, Range 4E, W.M.

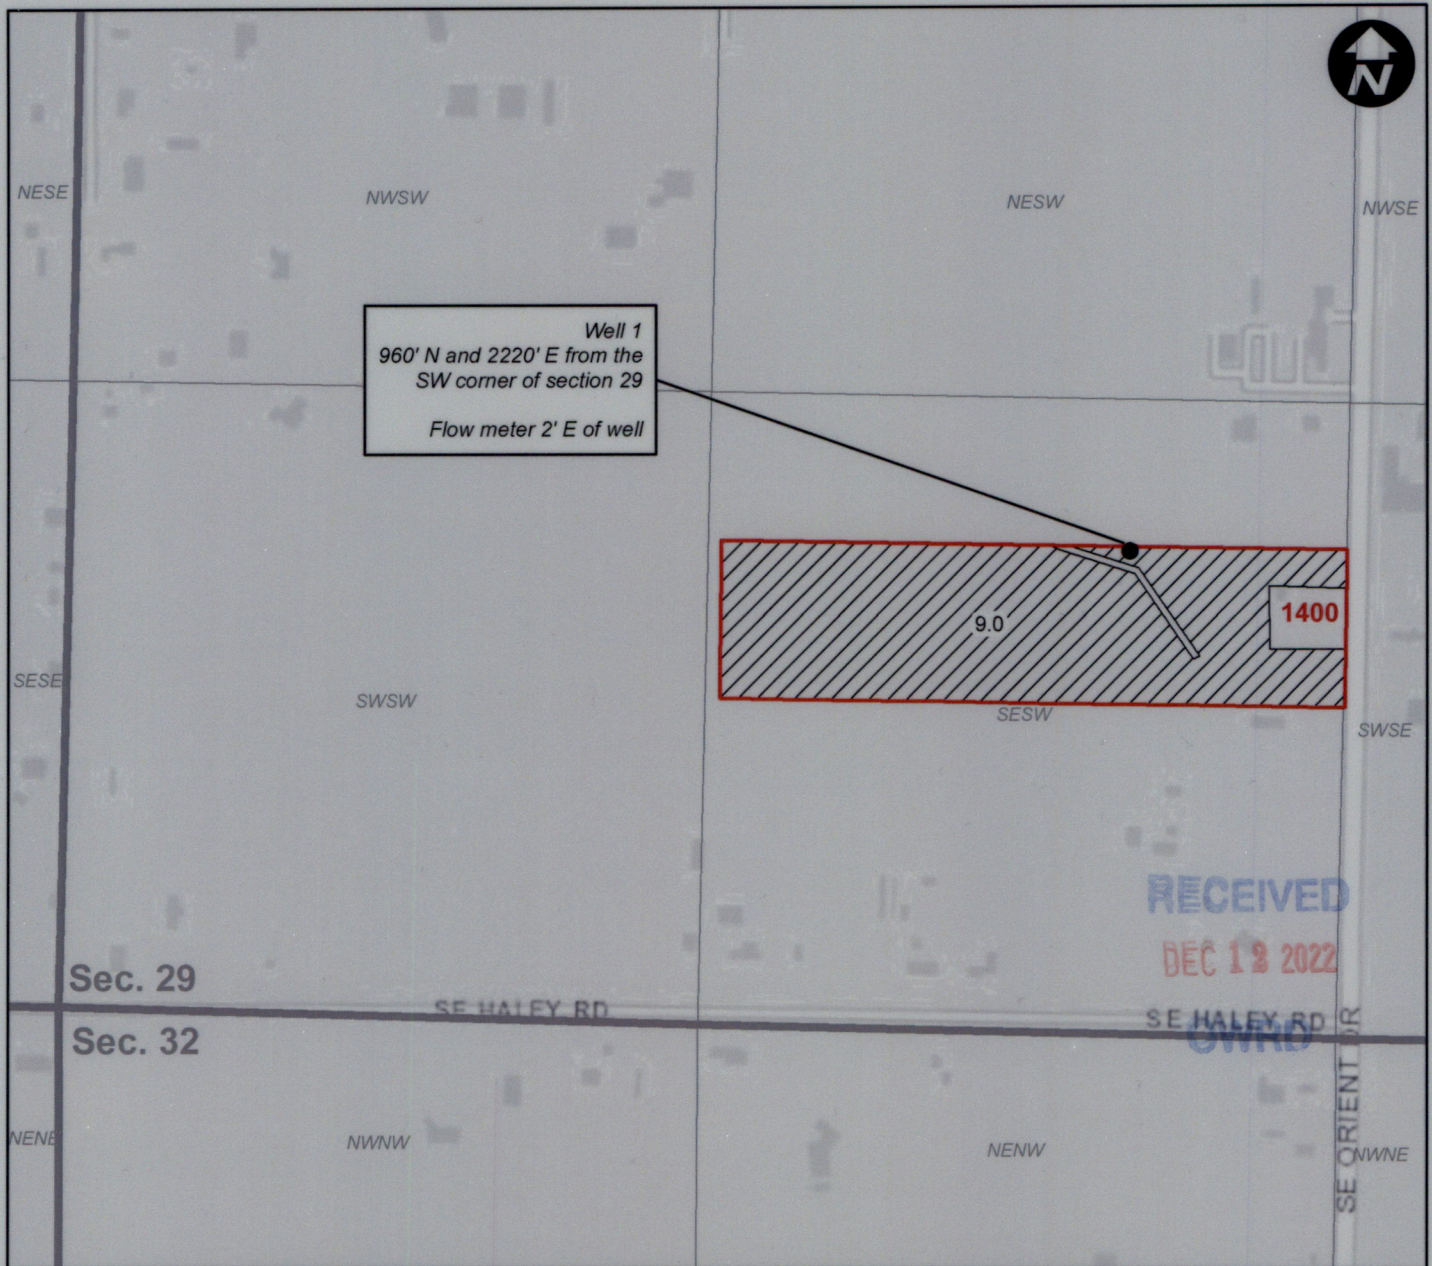

This map is not intended to provide legal dimensions or locations of property ownership lines.

0 200 400 800 Feet

Legend

-  T-12697 POU
-  Taxlot



EXPIRES: 12-31-2022