


FOR ADJUSTMENT
AND TAXATION
ONLY

SECTION 31 T.16S. R.2E. W.M.
LANE COUNTY

SCALE 1" = 200' 1000'
SEE MAP 16 25

16 25 31


C.A.D. SYS.

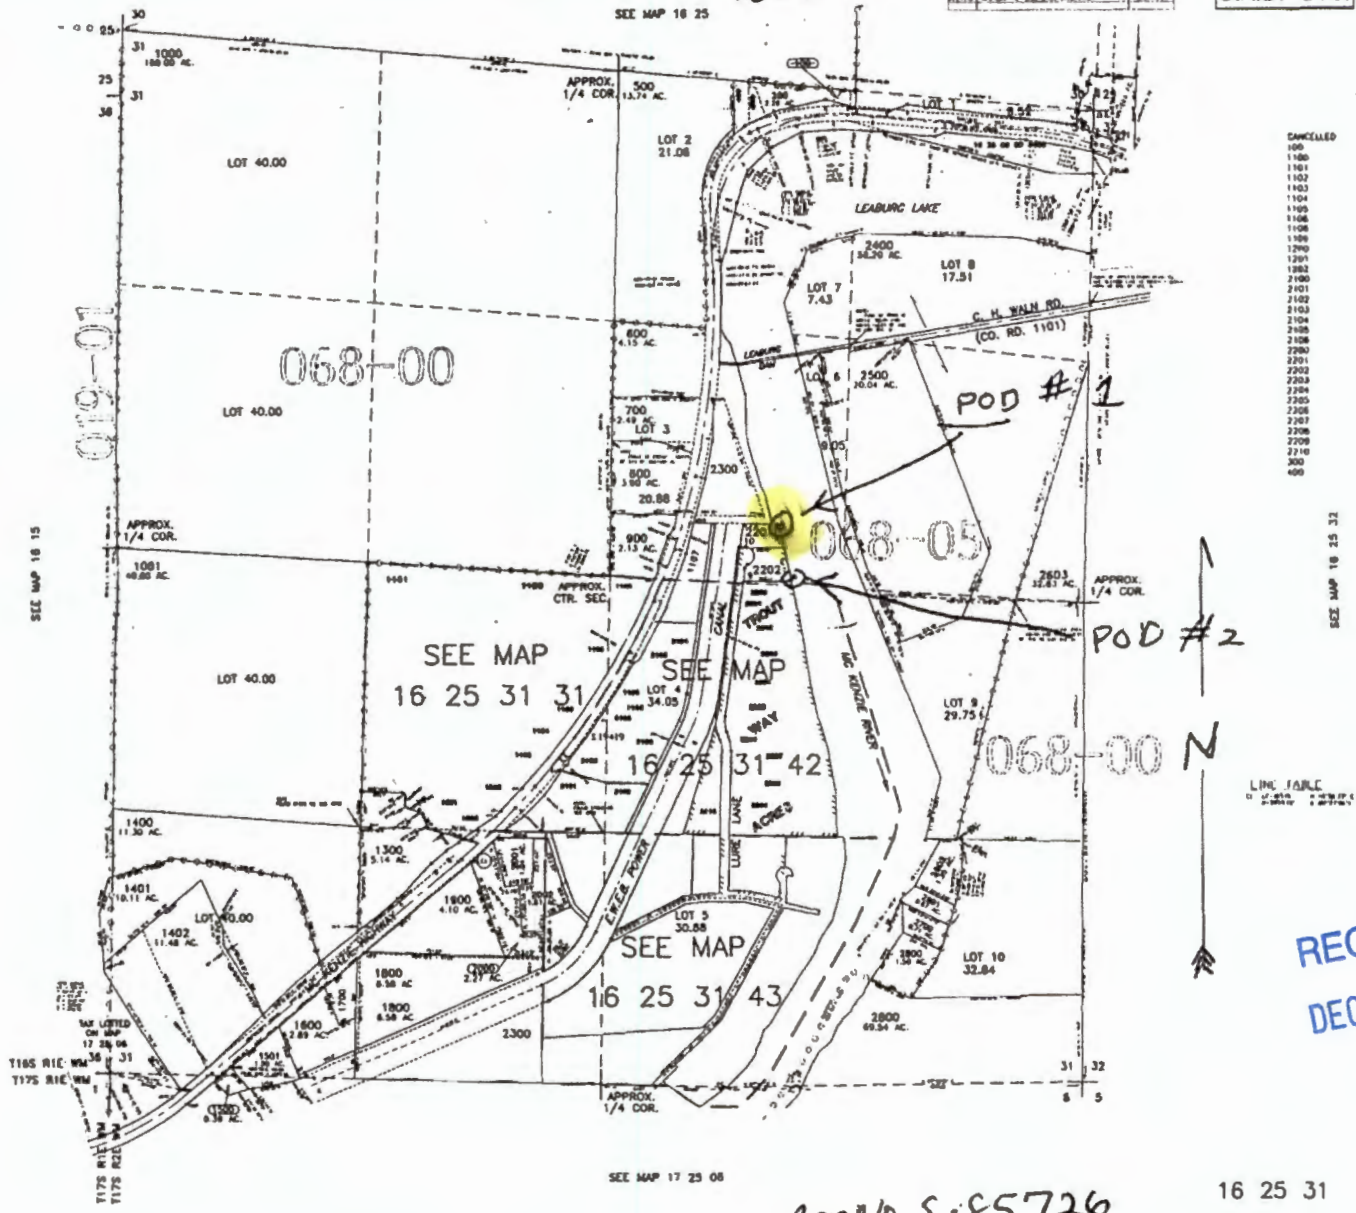

RECEIVED
DEC 12 2022
OWRD

App No S-85726

16 25 31

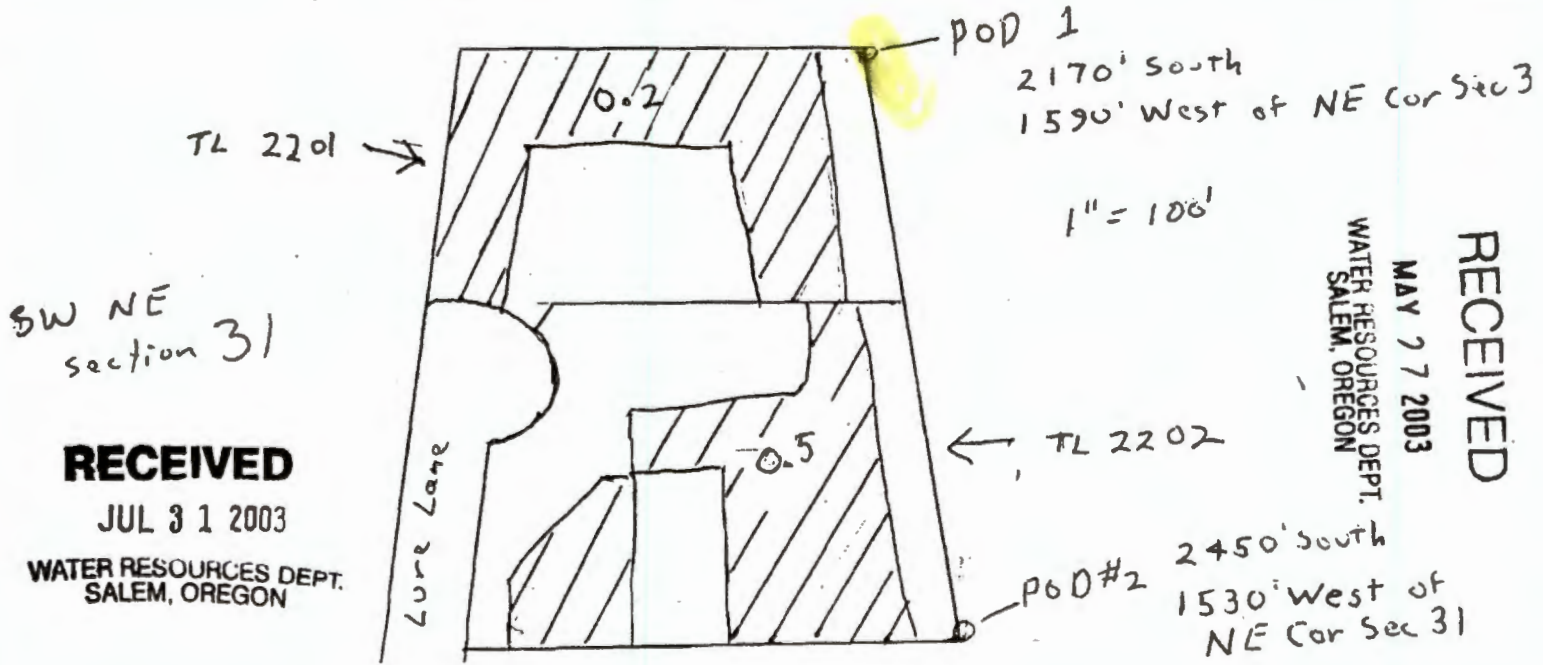

RECEIVED
MAY 7 7 2003
WATER RESOURCES DEPT.
SALEM, OREGON

RECEIVED
JUL 31 2003
WATER RESOURCES DEPT.
SALEM, OREGON