FOR ASSESSMENT AND TAXATION ONLY

SECTION 31 T.16S. R.2E. W.M.
LANE COUNTY
SCALE 1" = 1000'

16 25 31

C.A.D. SYS.

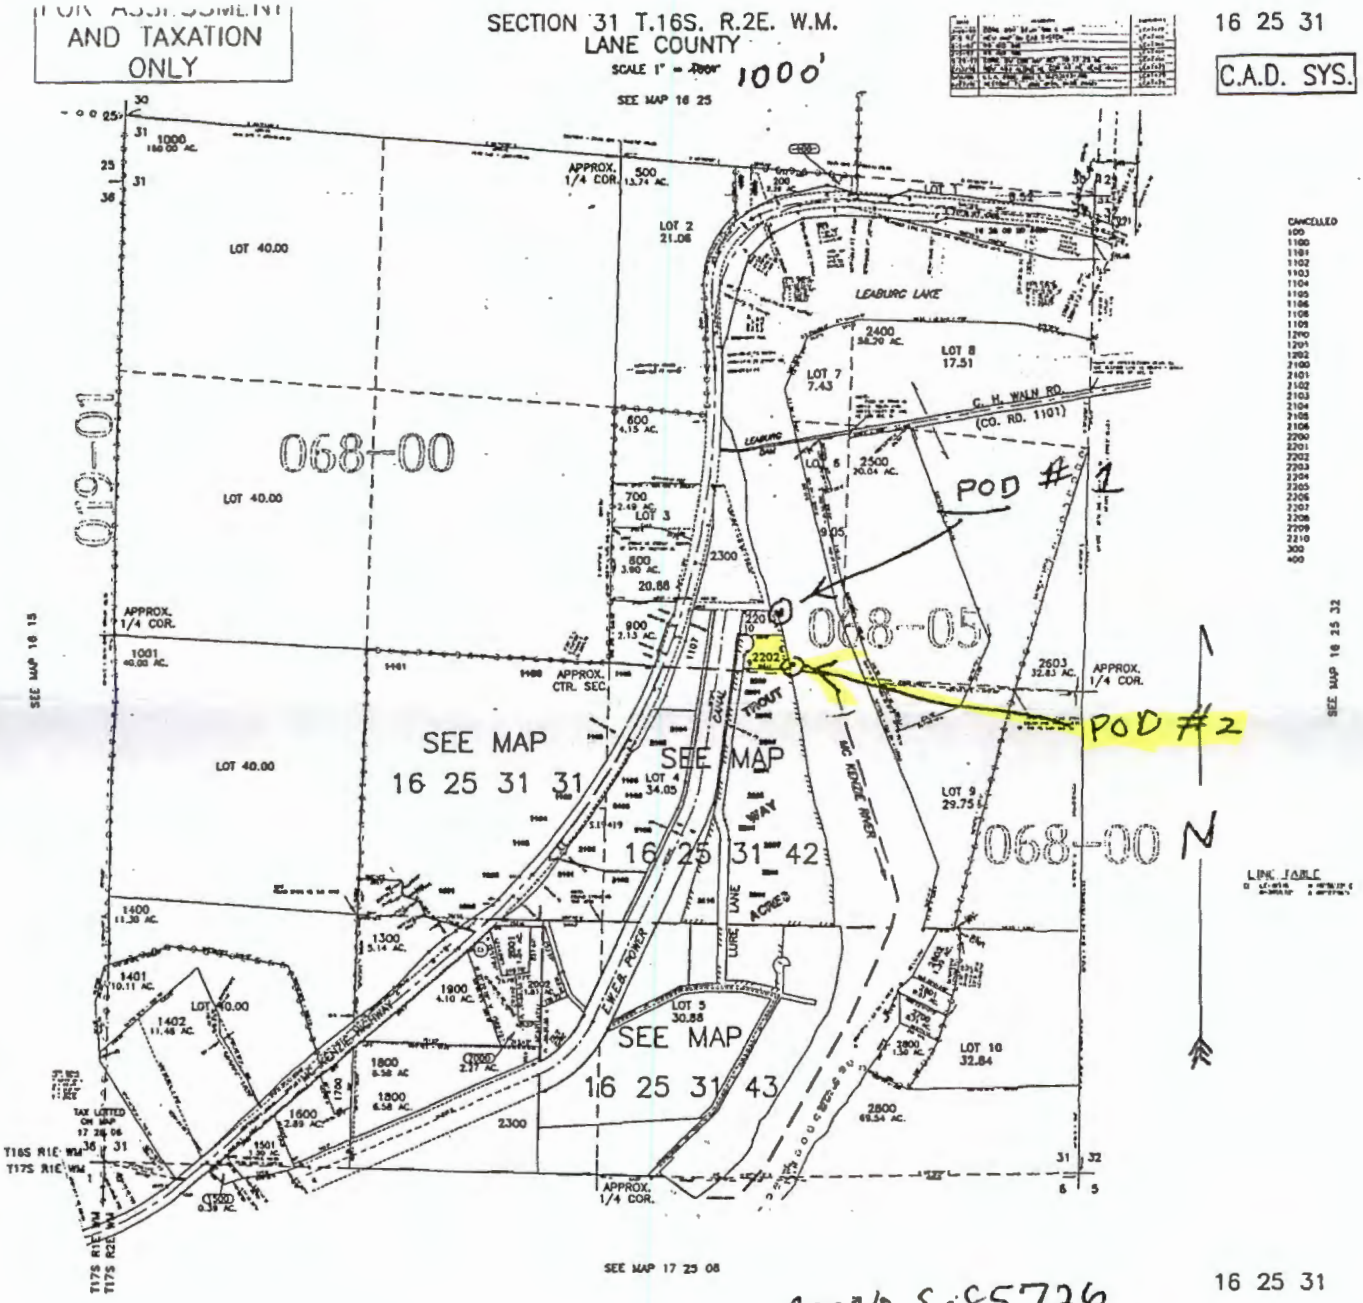

RECEIVED
DEC 06 2022
OWRD

App No S-85726

16 25 31

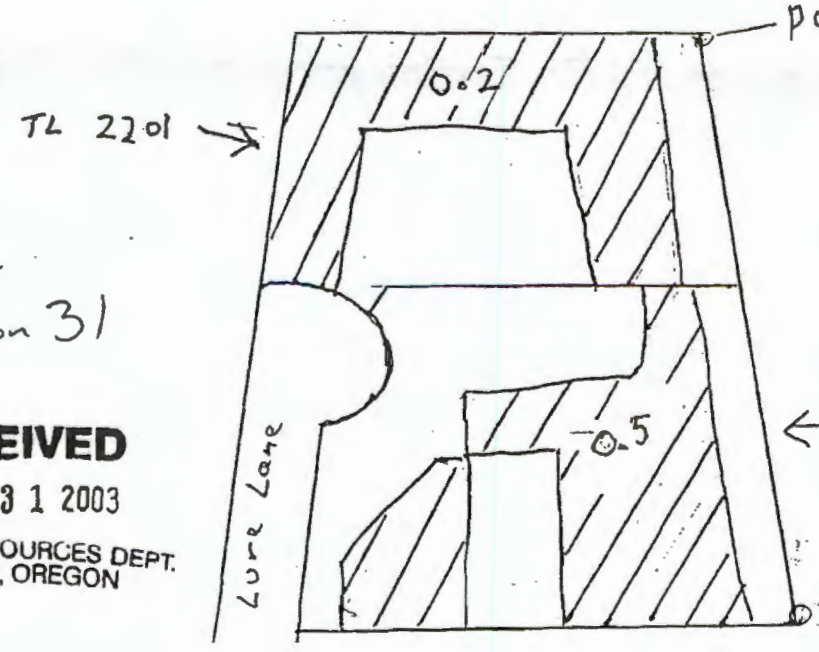

RECEIVED
JUL 31 2003
WATER RESOURCES DEPT.
SALEM, OREGON

RECEIVED
MAY 27 2003
WATER RESOURCES DEPT.
SALEM, OREGON