


County Plat Map

RECEIVED

DEC 02 2022

UWRD
CLATSOP COUNTY, OREGON

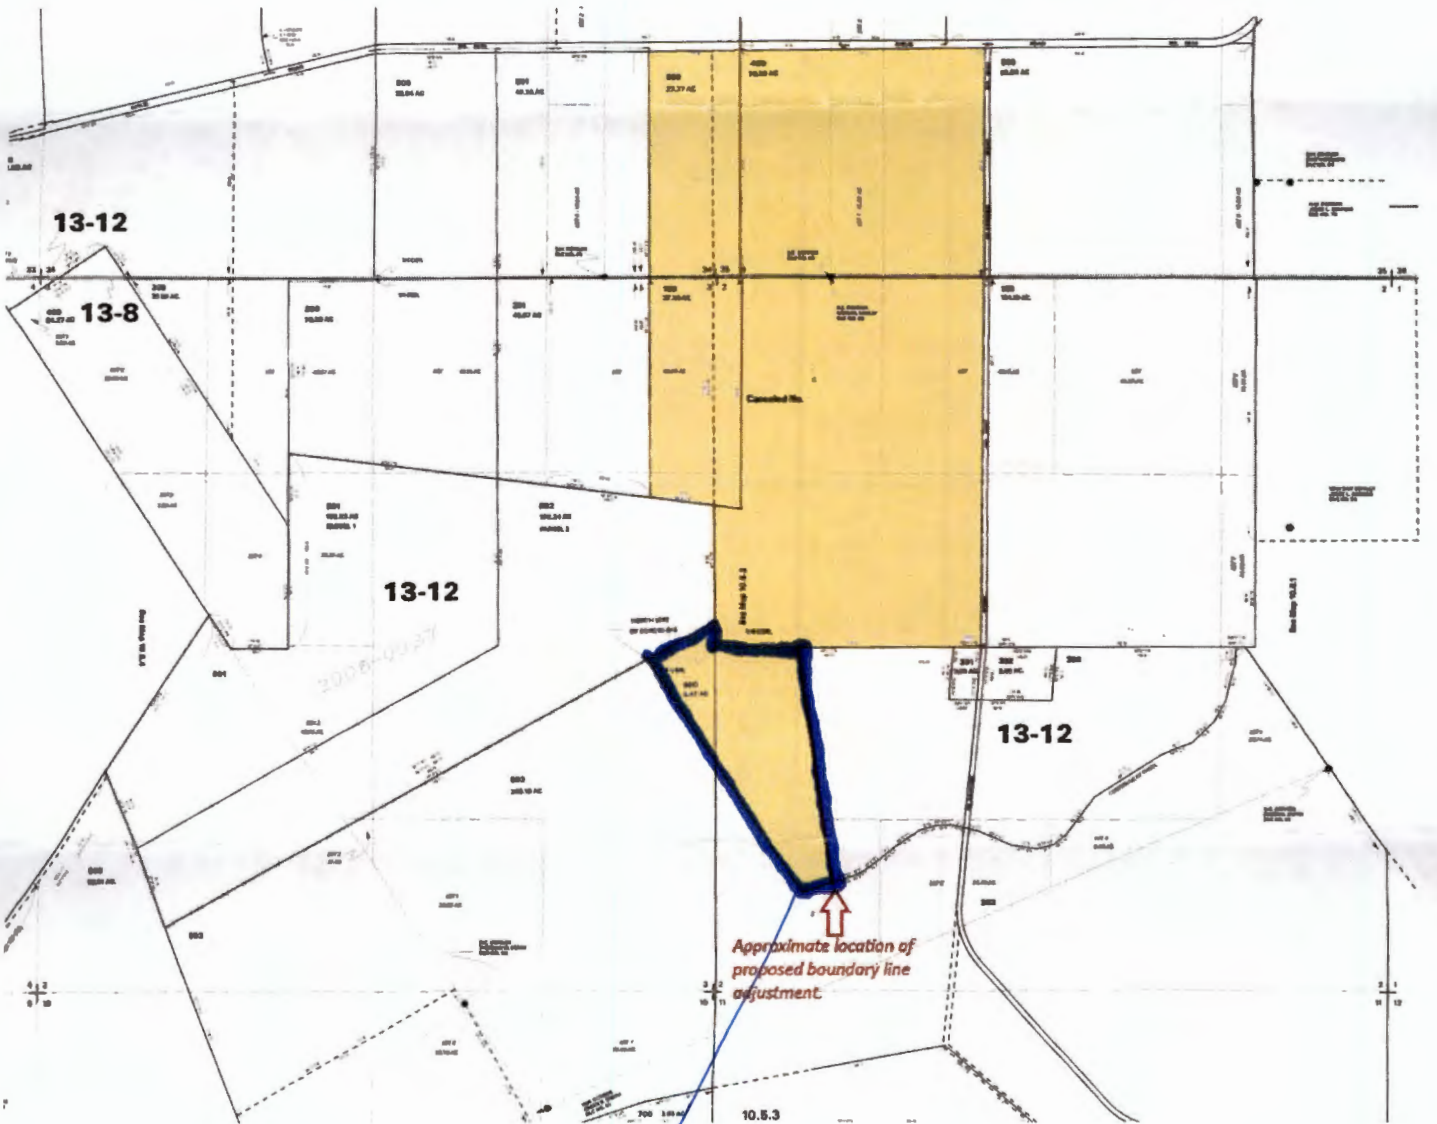

portion assigning

