


T.5S. R.1E. Section 21, W.M.

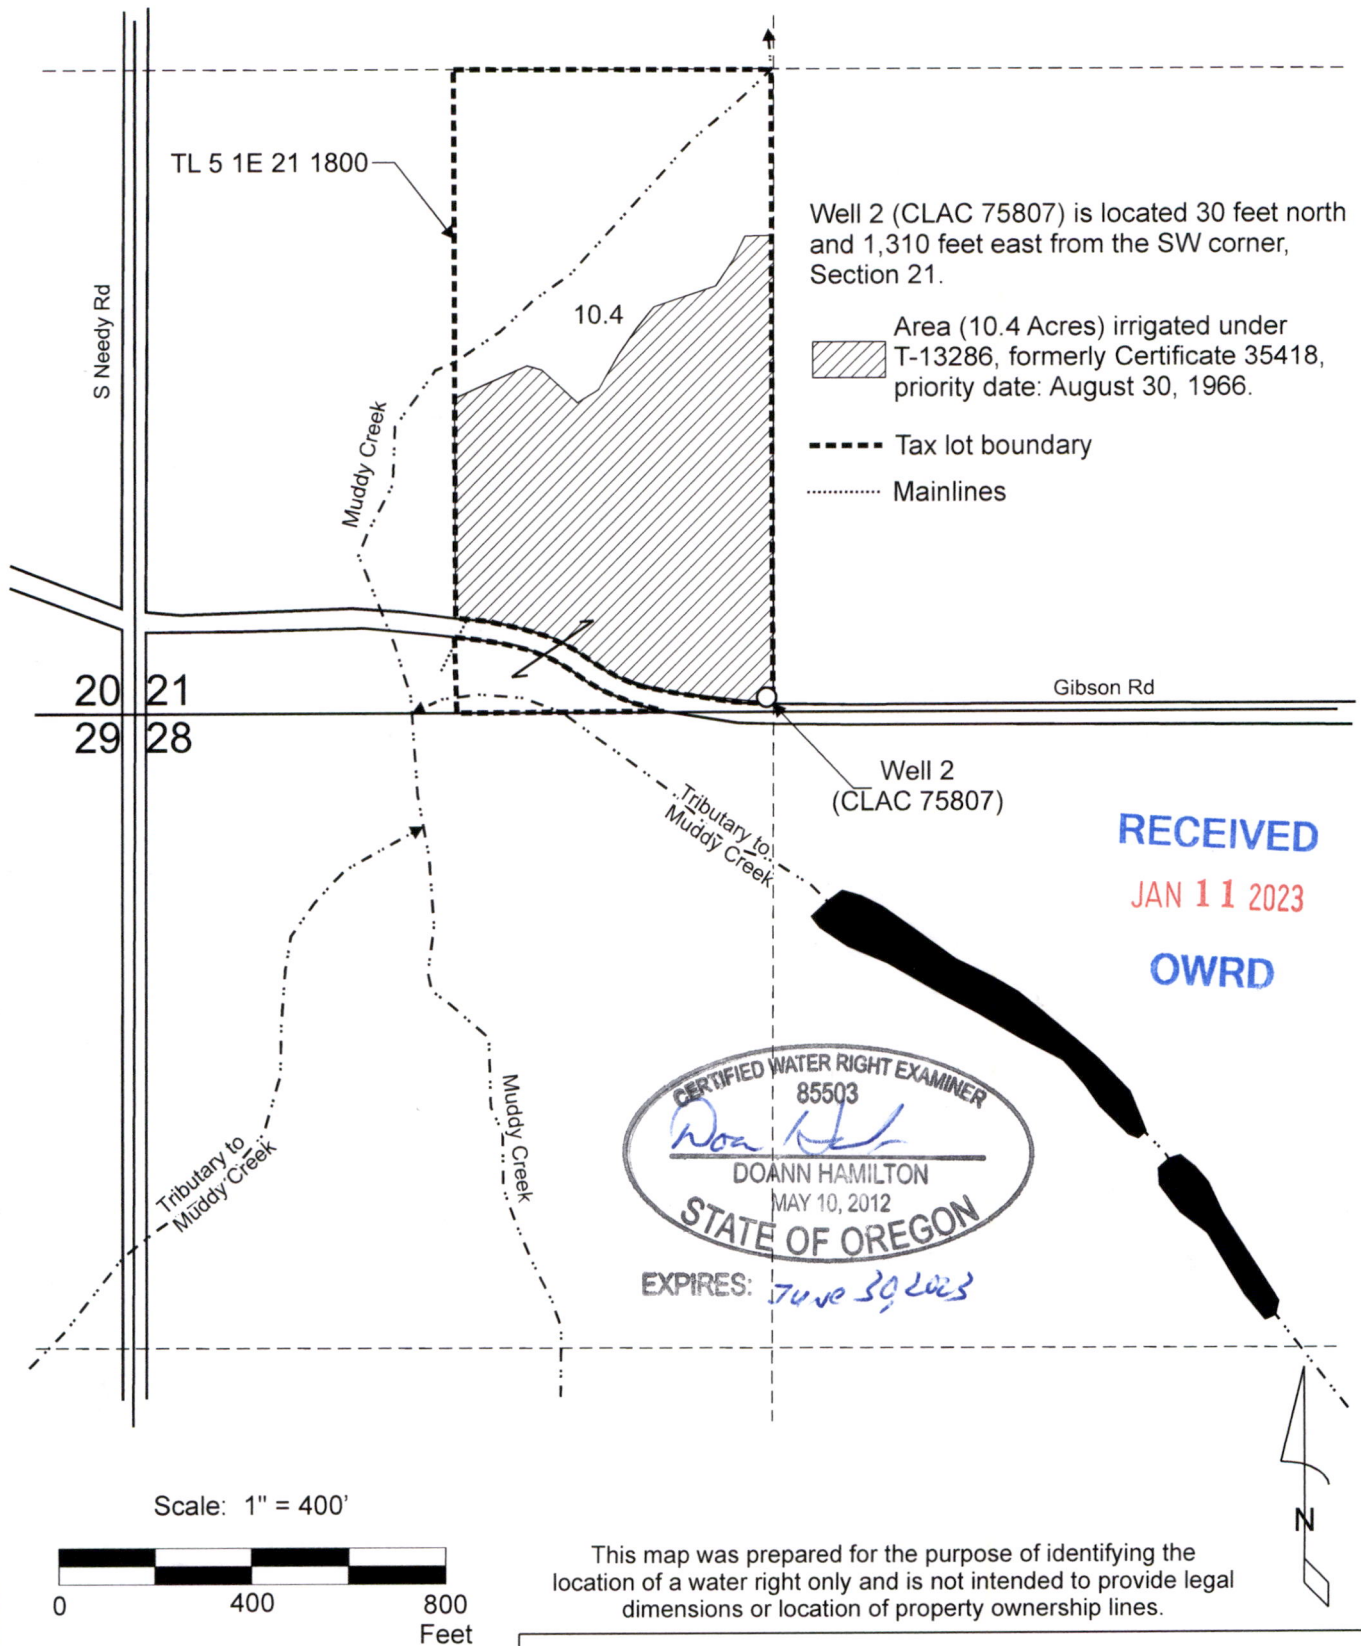

SnegirevT-13286COBUMap.cdr

Pacific Hydro-Geology Inc.

12/2022

Claim of Beneficial Use Map
T-13286, formerly Certificate 35418

Ivan Snegirev
T.5S. R.1E. Section 21, W.M.