


Township 2 S., Range 26 E.W.M.

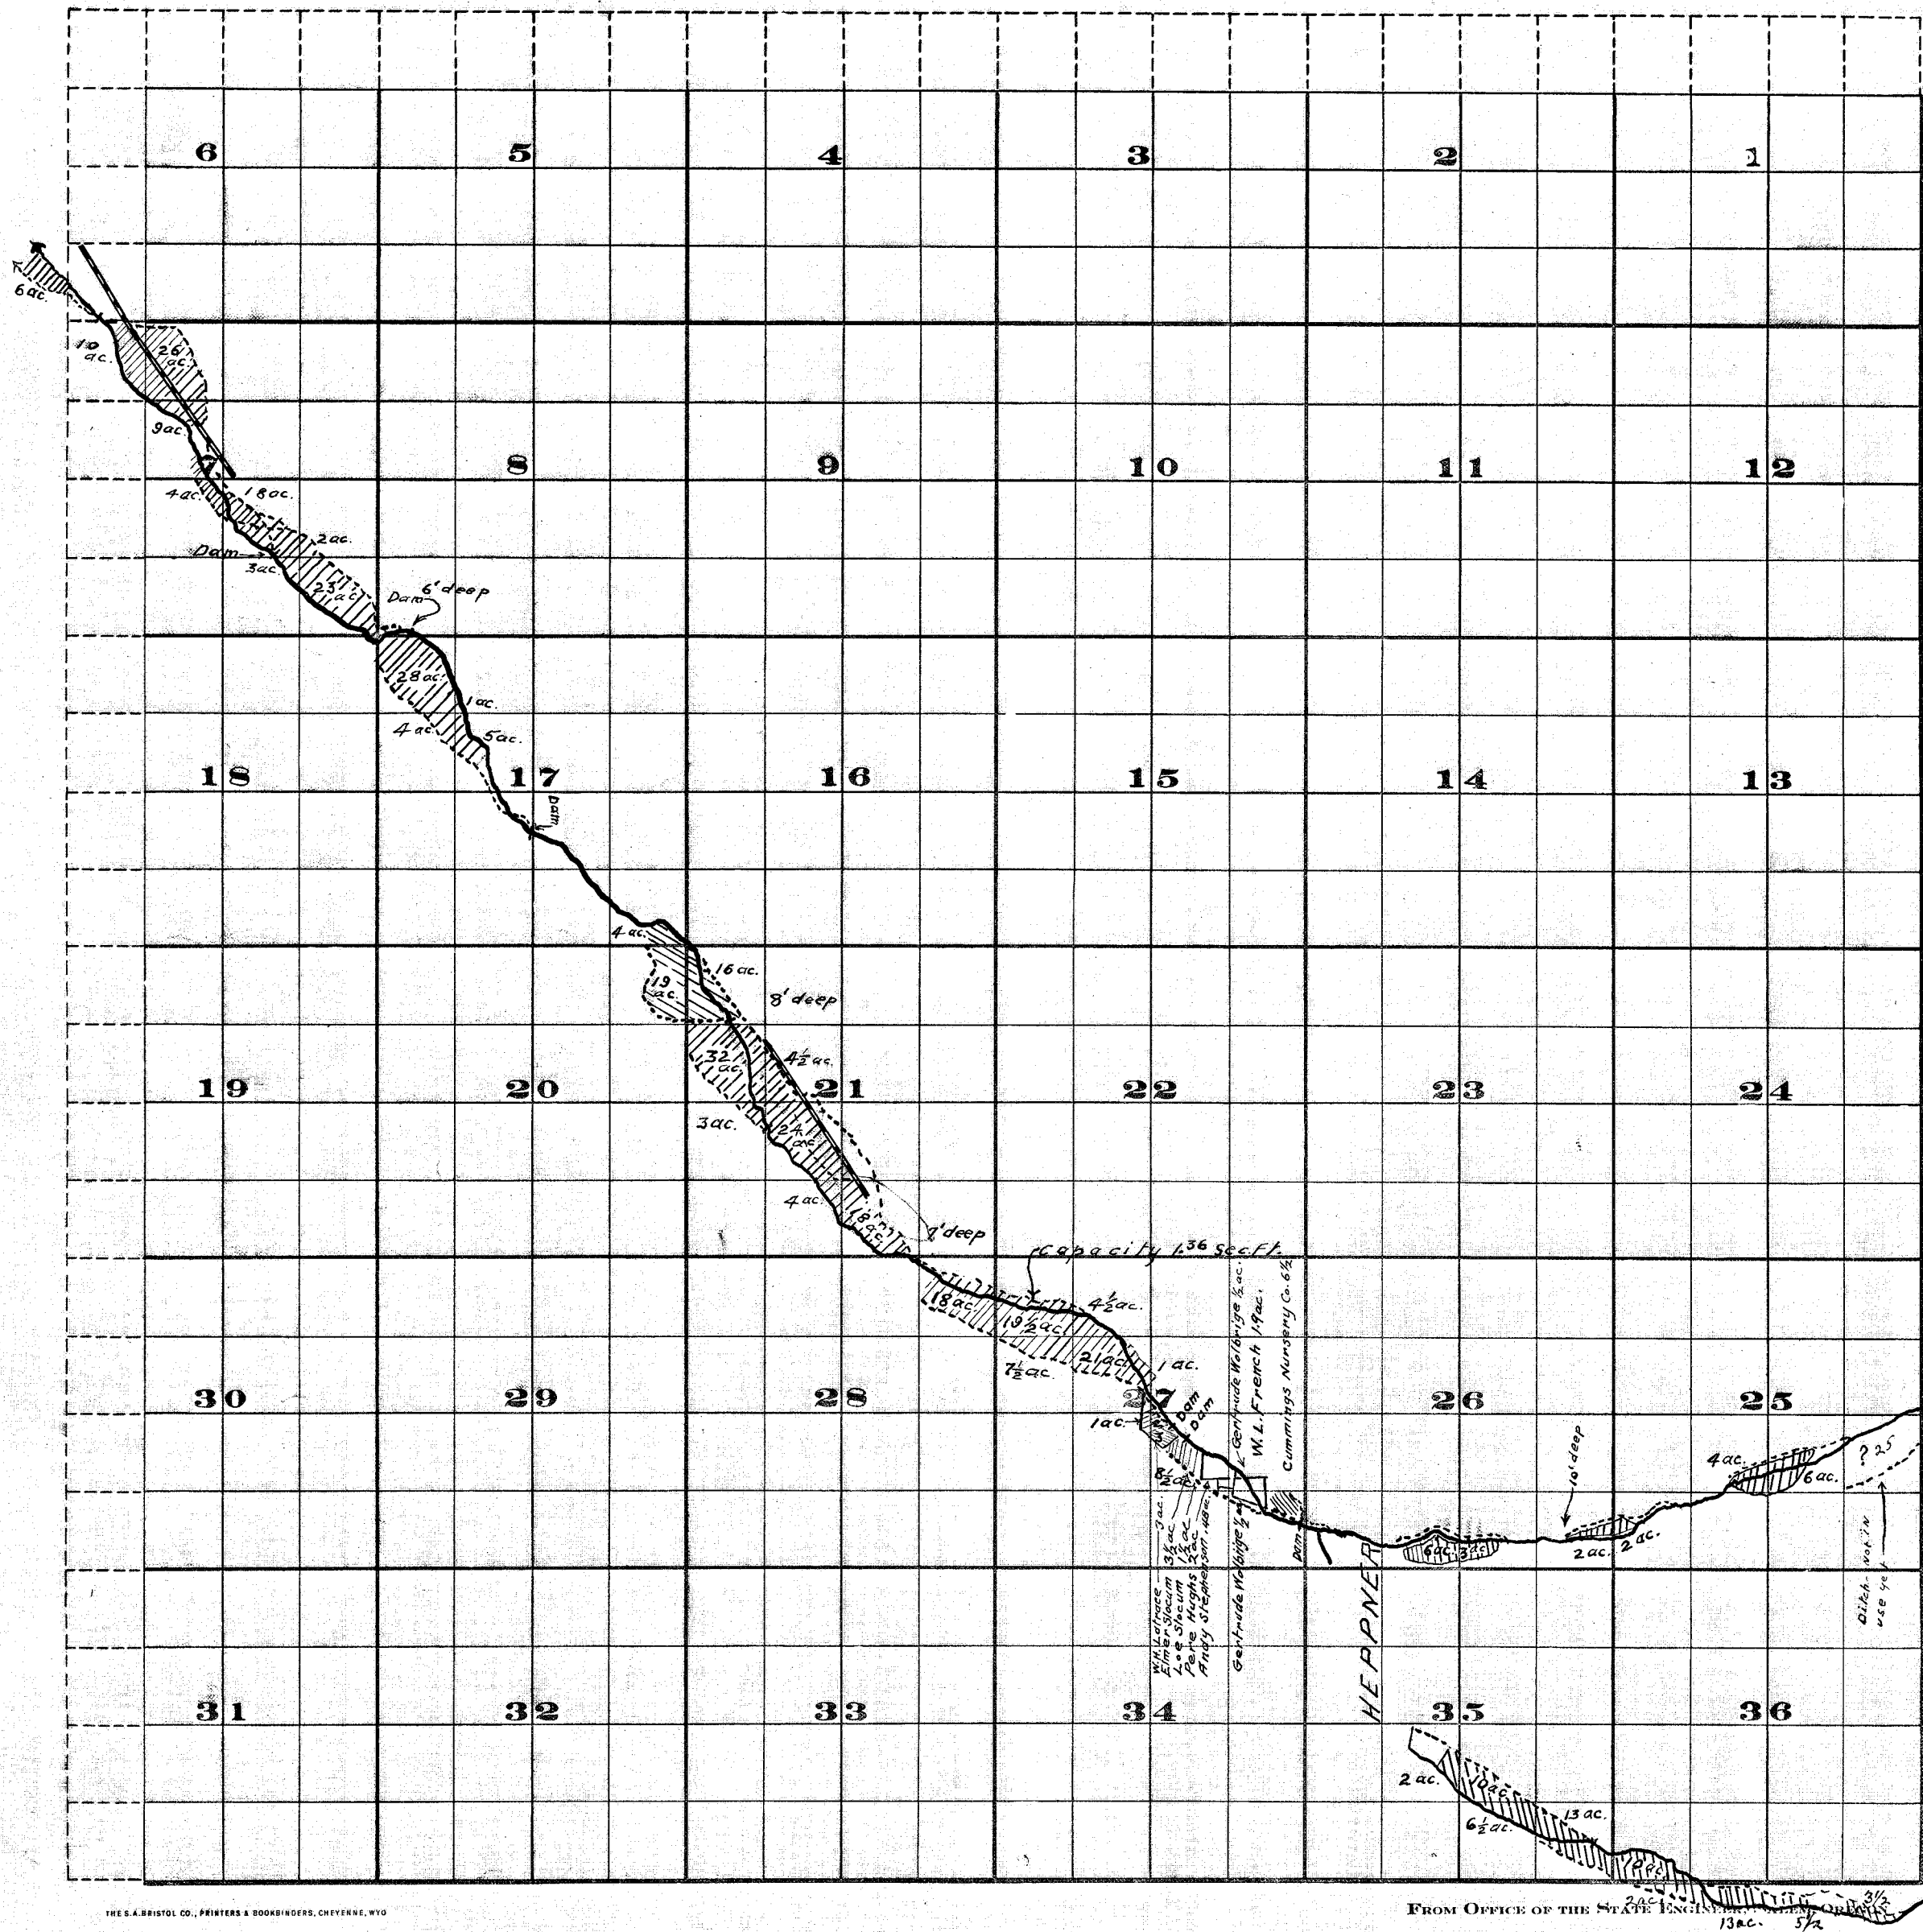

THE S.A. BRISTOL CO., PRINTERS & BOOKBINDERS, CHEYENNE, WYO

FROM OFFICE OF THE STATE ENGINEER

Surveyed by R.D. Cooper July 1909
 John H. Lewis - State Engineer.
 Examined July 14, 1909.

Willow Creek Adjudication

26
52

1017

1015

11

