

THIS MAP WAS PREPARED FOR
ASSESSMENT PURPOSE ONLY

N.W. 1/4 SEC. 34 T.10S. R.5W. W.M.
BENTON COUNTY
1" = 200'


0 100 200 Feet

10534B

REV: 12/29/2014
CANCELLED:
800
1000
1100 THRU 1101
1200
2400
700
100




RECEIVED
JAN 17 2023
OWRD

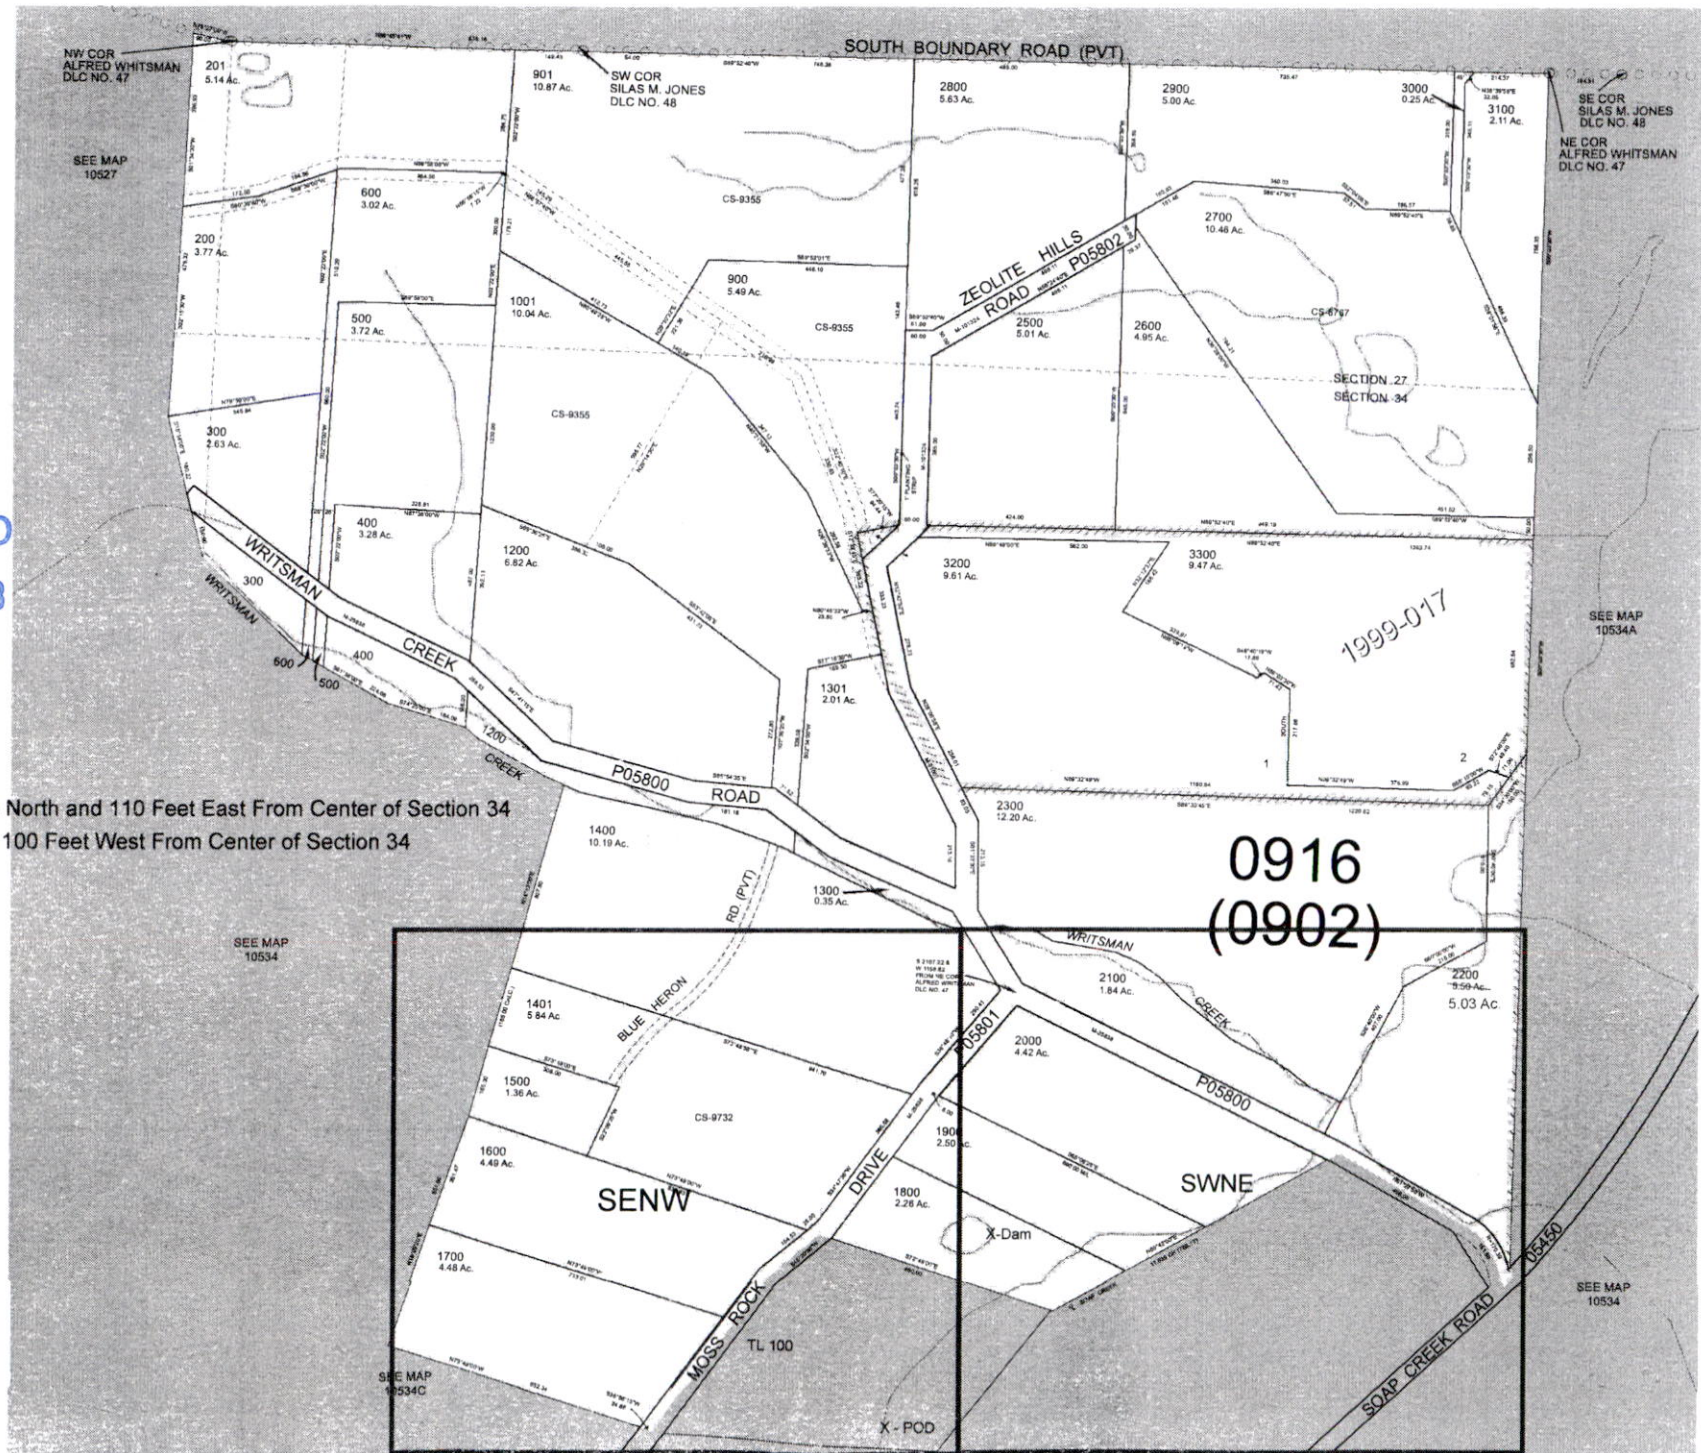

am Location: 640 Feet North and 110 Feet East From Center of Section 34
OD: 90 Feet North and 100 Feet West From Center of Section 34

RECEIVED
DEC 27 2022
OWRD

10534B

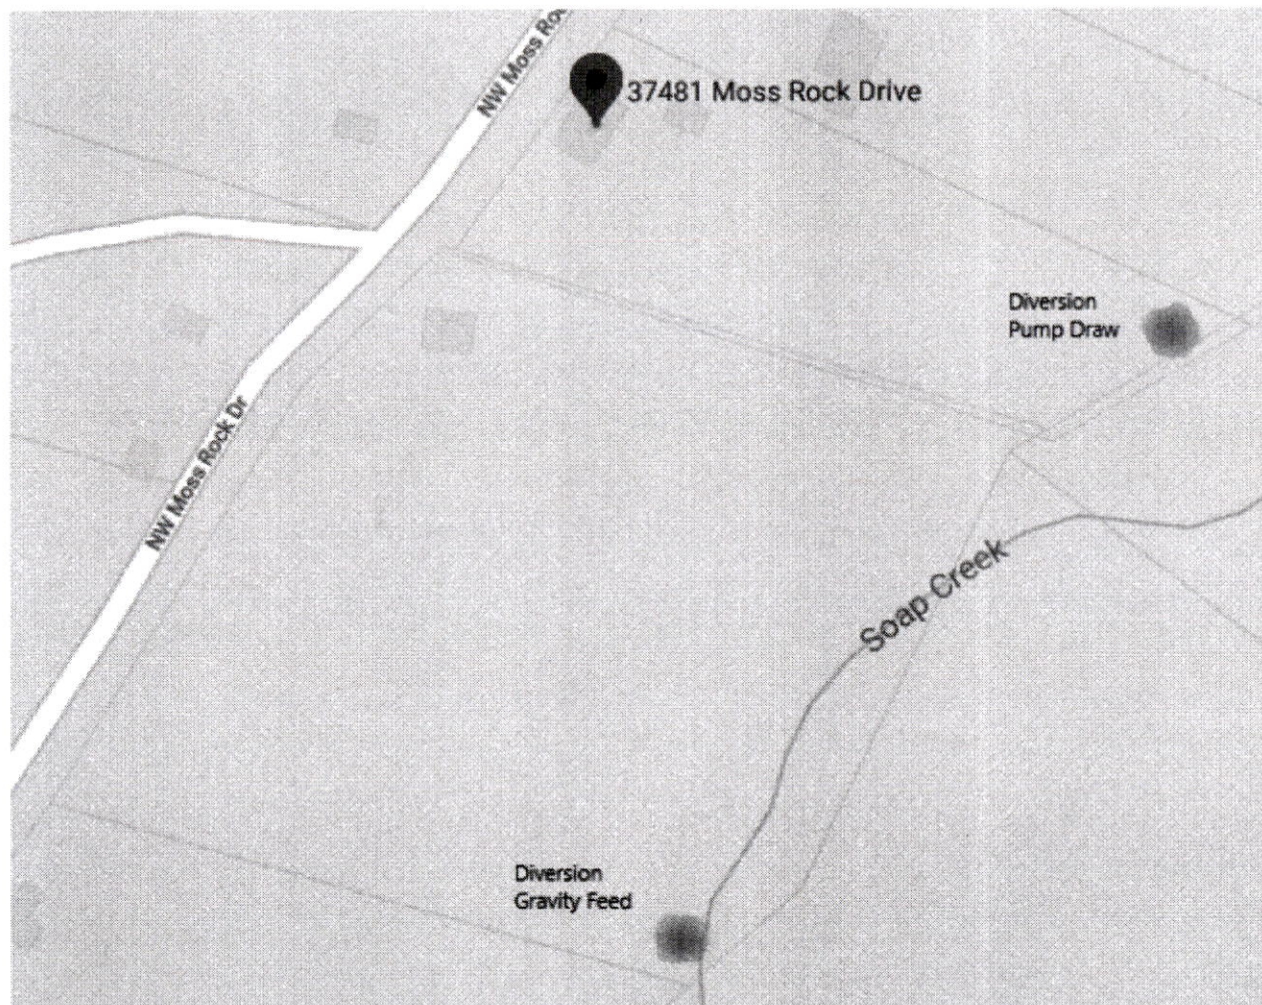

RECEIVED
JAN 17 2023
OWRD

RECEIVED
DEC 27 2022
OWRD