

RECEIVED

DEC 30 2022


OWRD

NORTH

OWRD

JAN 19 2023

RECEIVED

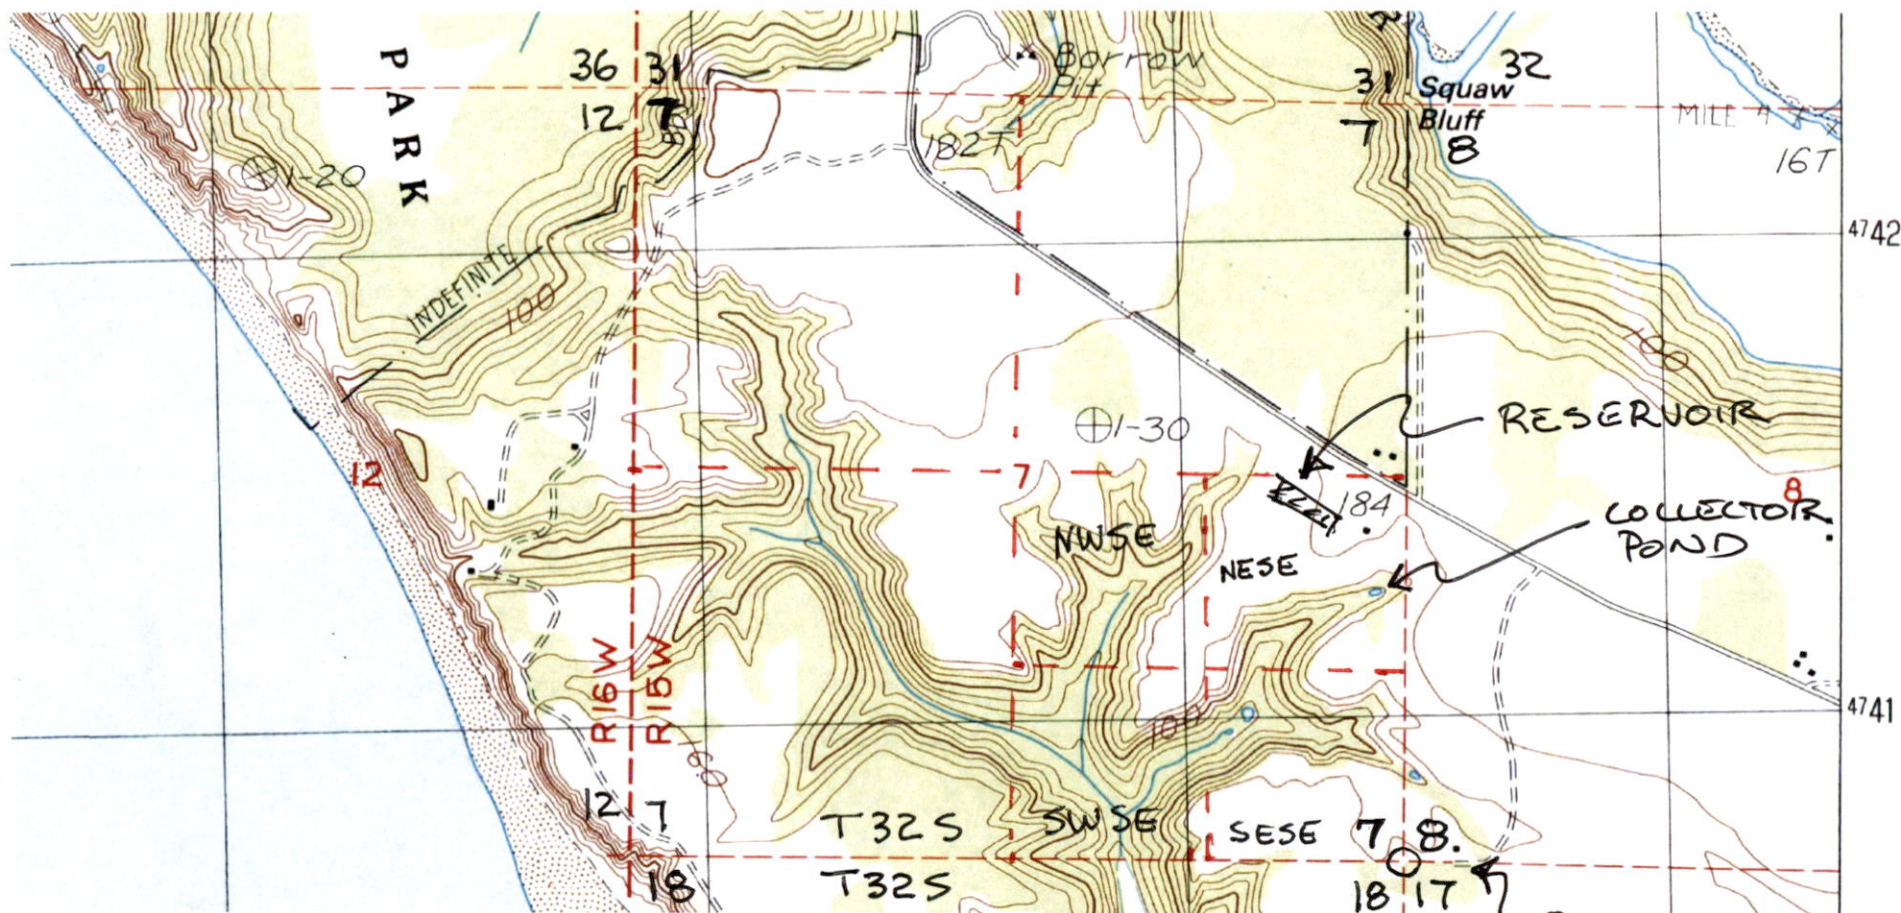

BASE MAP:


CAPE BLANCO, OREG

1986 USGS 7.5 MINUTE

4" = 1 MILE

SECTION  
CORNER  
REFERENCE:

- COLLECTOR POND  
NORTH 1875' & WEST 200'
- RESERVOIR:  
NORTH 2550' & WEST 700'

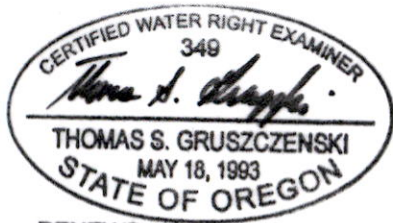



RENEWS: 06-30-2023



THIS APPLICATION MAP  
WAS PREPARED FOR THE  
PURPOSE OF IDENTIFY THE  
LOCATION OF A WATER  
RIGHT ONLY & IS NOT  
INTENDED TO PROVIDE  
LEGAL DIMENSIONS OR  
LOCATIONS OF PROPERTY  
OWNERSHIP LINES.

RECEIVED  
JAN 19 2023  
OWRD

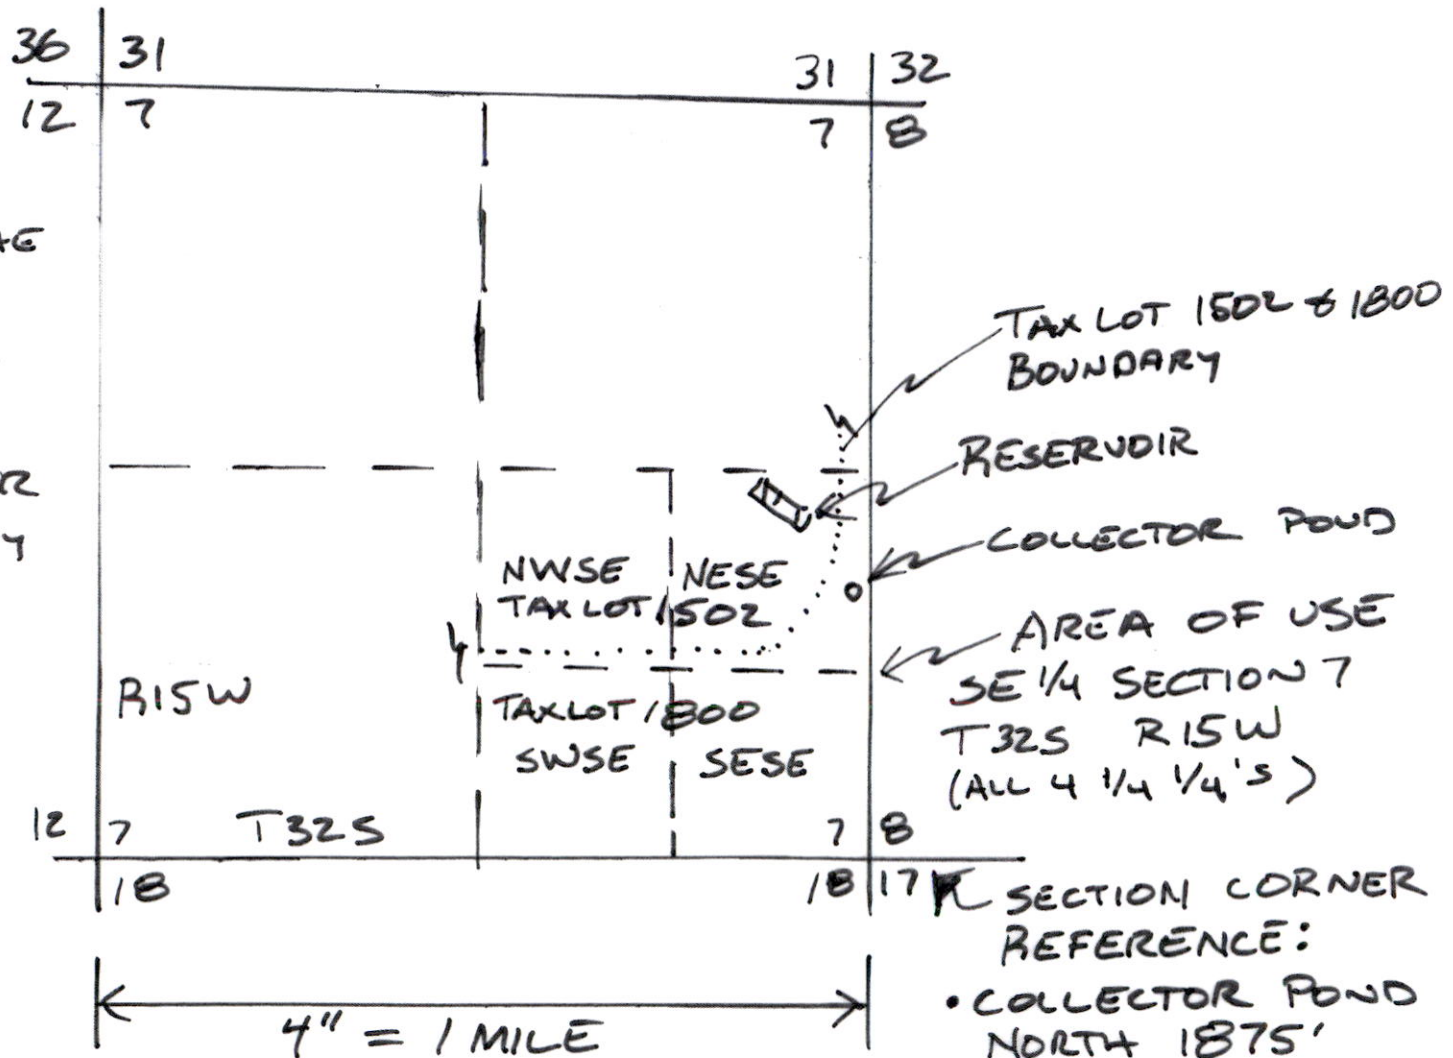


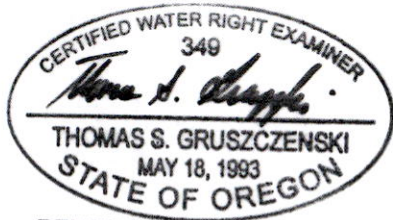


RENEWS: 06-30-2023

THIS APPLICATION MAP  
WAS PREPARED FOR THE  
PURPOSE OF IDENTIFY THE  
LOCATION OF A WATER  
RIGHT ONLY & IS NOT  
INTENDED TO PROVIDE  
LEGAL DIMENSIONS OR  
LOCATIONS OF PROPERTY  
OWNERSHIP LINES.

RECEIVED  
JAN 19 2023  
OWRD

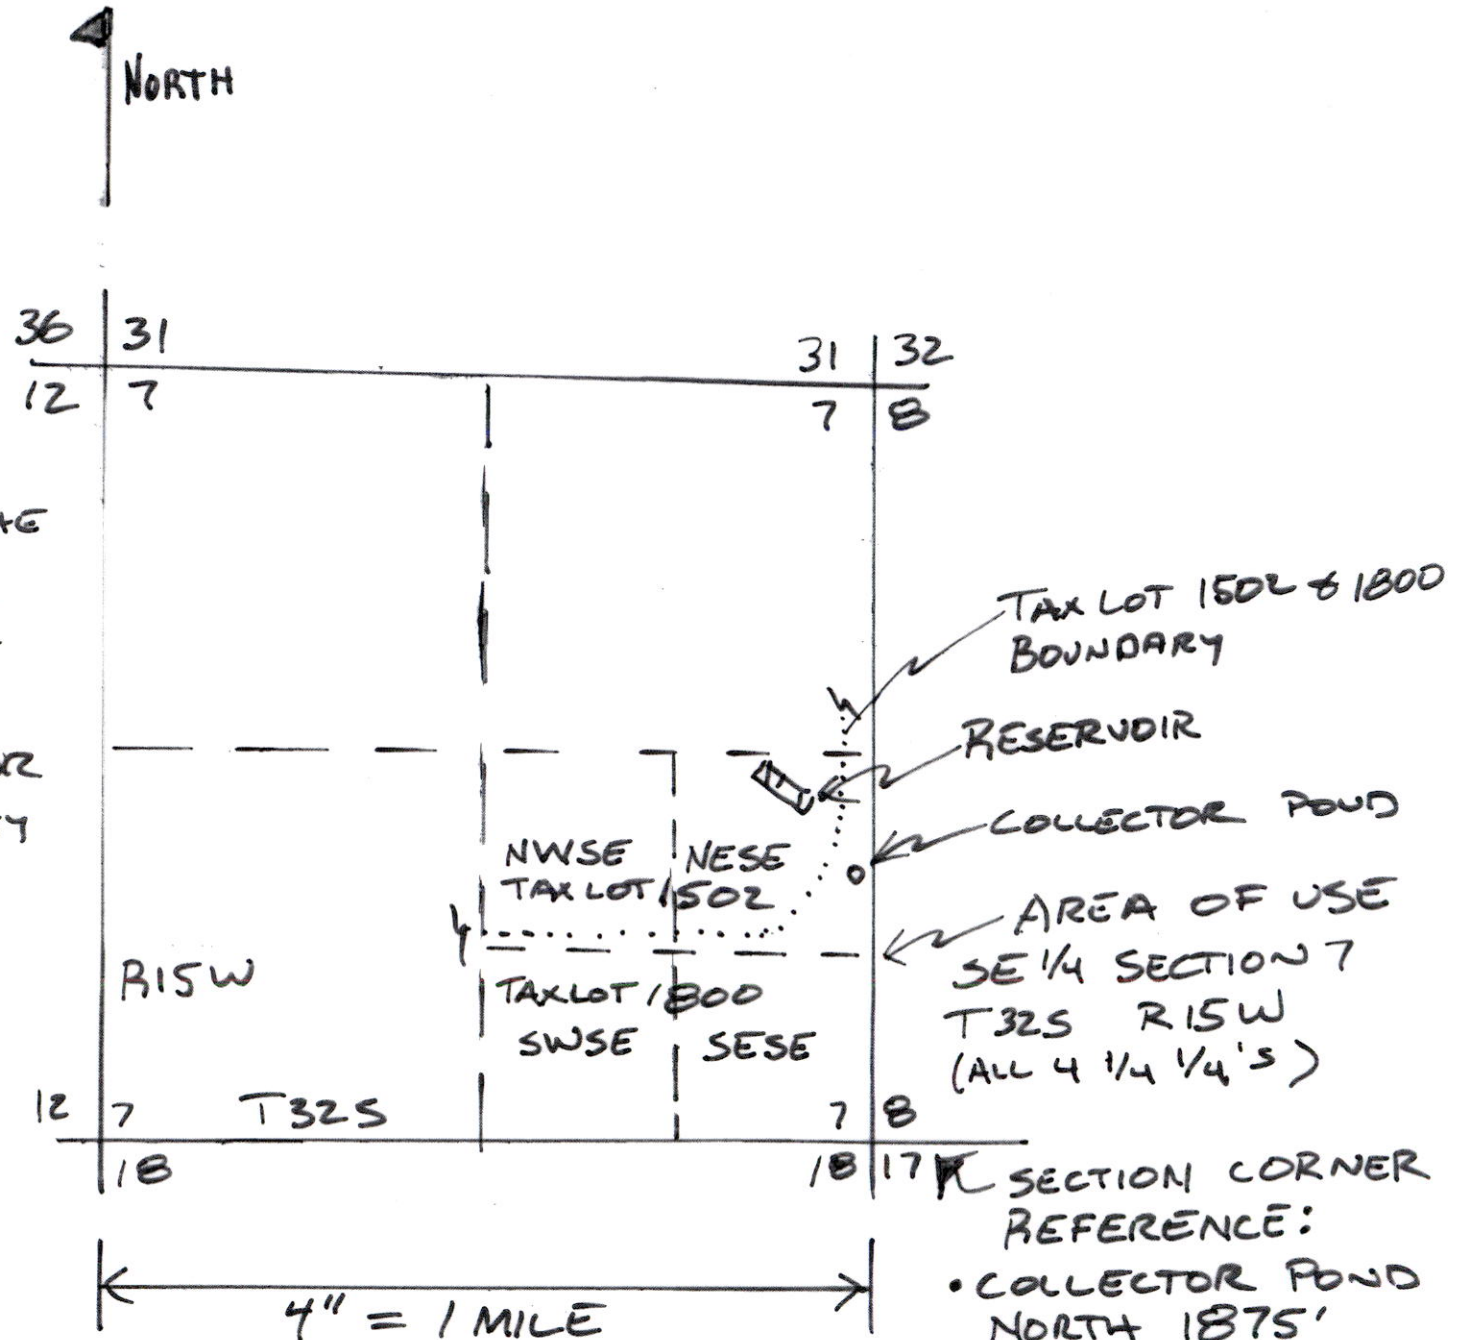

- SECTION CORNER  
REFERENCE:
- COLLECTOR POND  
NORTH 1875'  
WEST 200'
  - RESERVOIR  
NORTH 2250'  
WEST 700'

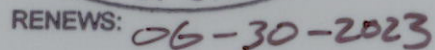

A hand-drawn map showing a section of land. The map is divided into a grid of sections. The top-left section is labeled '36' and '12'. The top-right section is labeled '31' and '7'. The bottom-left section is labeled '12' and '7'. The bottom-right section is labeled '7' and '8'. The map includes several labels: 'R15W' in the bottom-left section, 'T32S' in the bottom-right section, 'NWSE TAX LOT 1502' in the top-right section, and 'SWSE SESE TAX LOT 1800' in the bottom-right section. A scale bar at the bottom indicates '4" = 1 MILE'. There are also some handwritten notes and arrows on the right side of the map.

SECTION CORNER  
REFERENCE:

- COLLECTOR POND  
NORTH 1875'  
WEST 200'
- RESERVOIR  
NORTH 2250'  
WEST 700'

THIS APPLICATION MAP  
WAS PREPARED FOR THE  
PURPOSE OF IDENTIFY THE  
LOCATION OF A WATER  
RIGHT ONLY & IS NOT  
INTENDED TO PROVIDE  
LEGAL DIMENSIONS OR  
LOCATIONS OF PROPERTY  
OWNERSHIP LINES.