



Claim of Beneficial Use - Under, Kenny

Application R-87364, Permit R-14794

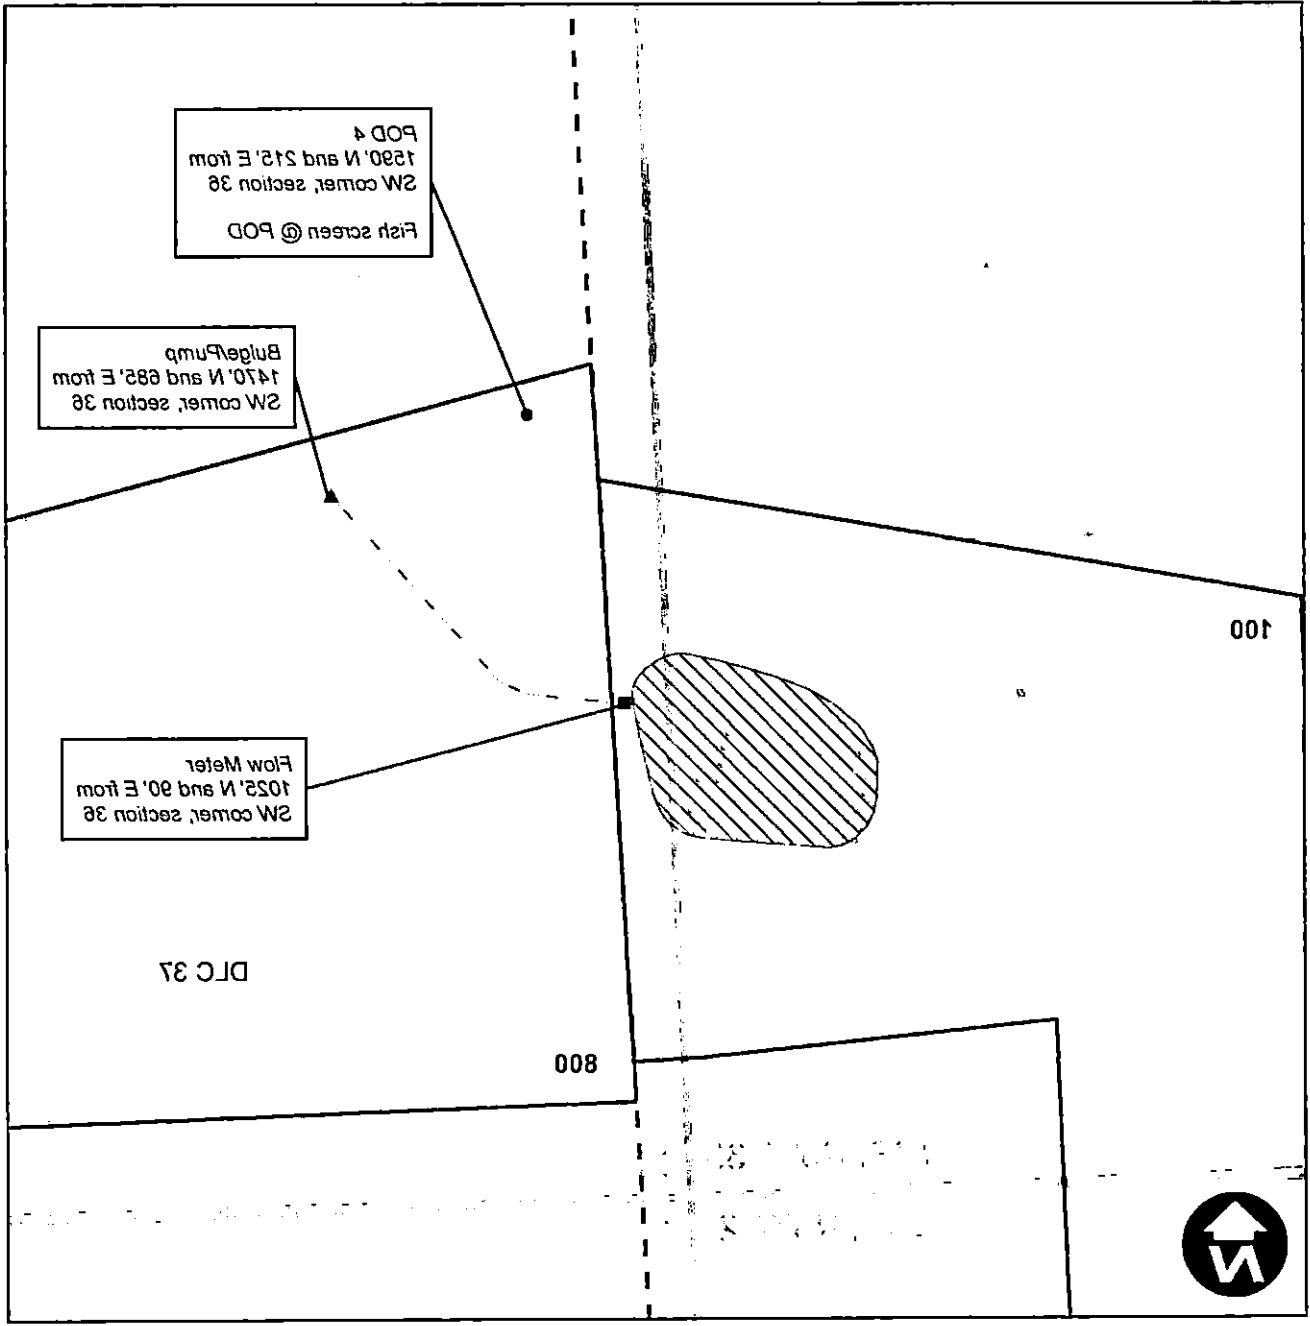


This map is not intended to provide legal dimensions or locations of property ownership lines

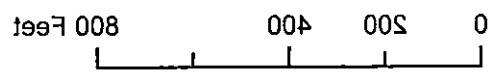


Legend

- Reservoir
- POD
- Flow Meter
- Fill Line
- Bulge Pump
- DLC
- Taxlot

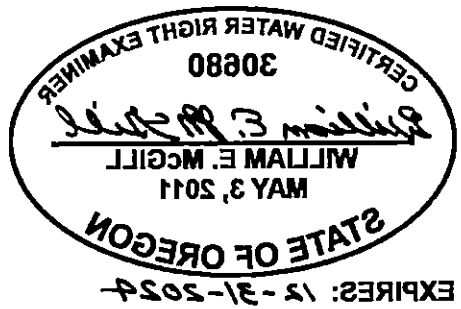


Claim of Beneficial Use - Unger, Kenny

Application R-87364, Permit R-14794

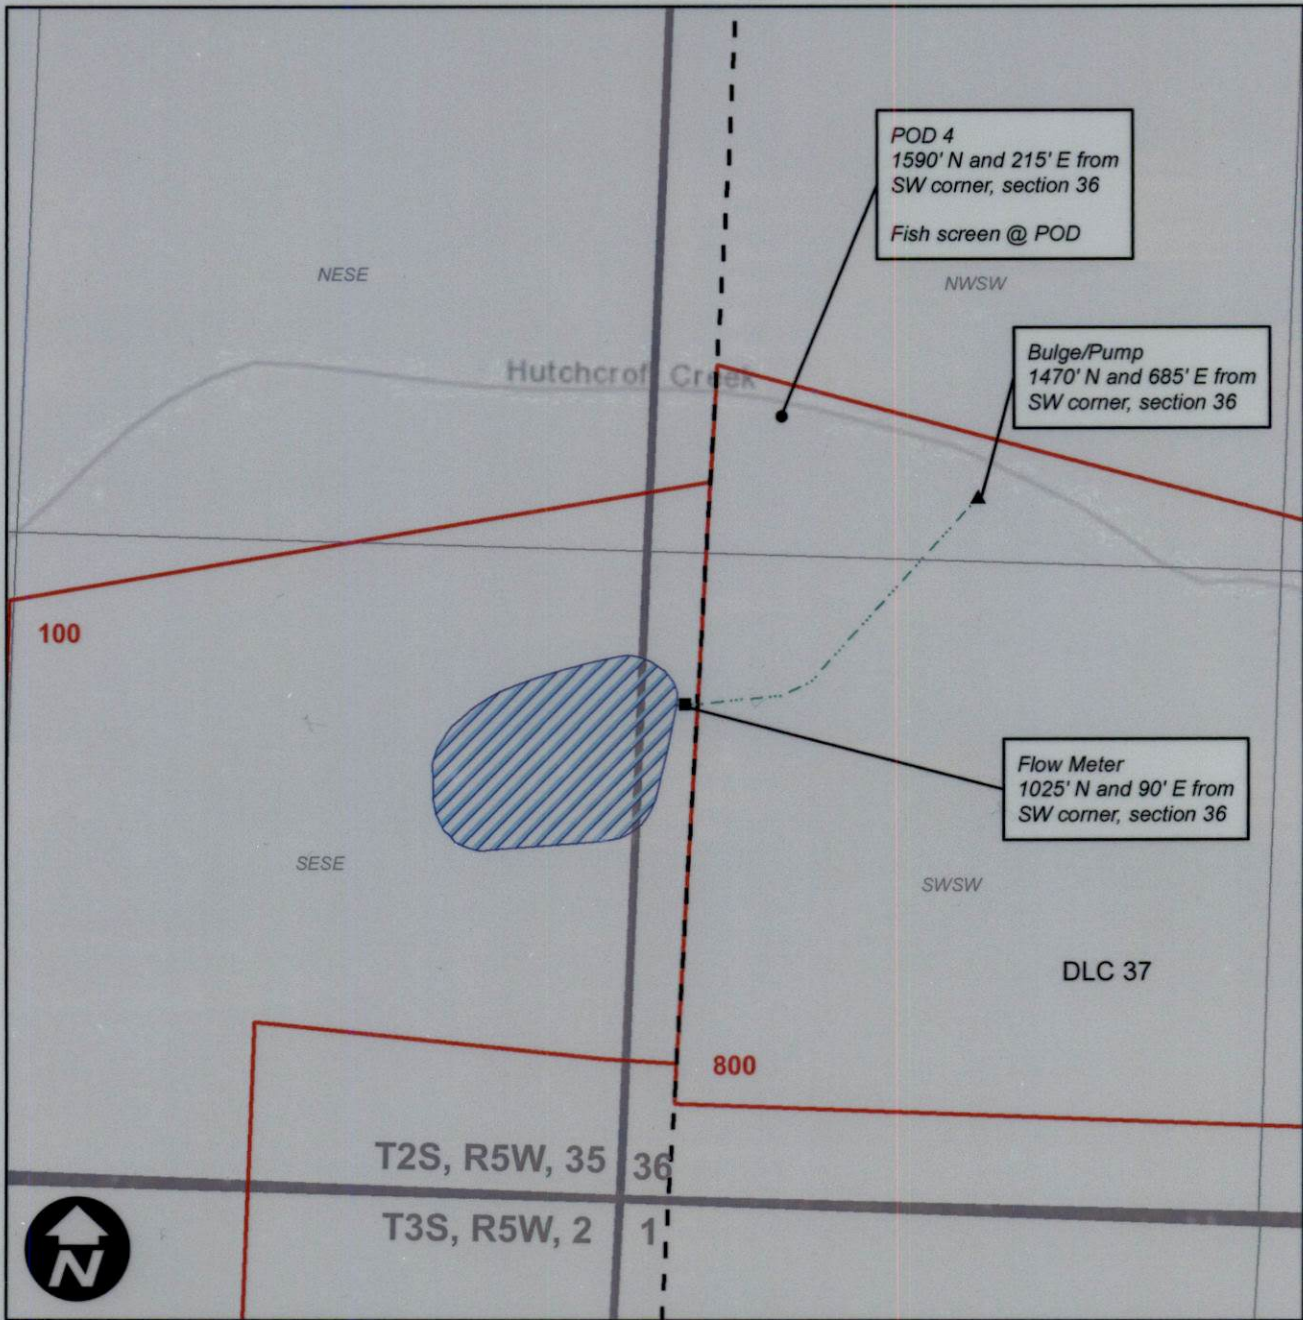

This map is not intended to provide legal dimensions or locations of property ownership lines.

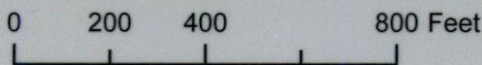

Legend

- Reservoir
- POD
- Bulge/Pump
- DLC
- Fill Line
- Flow Meter
- Taxlot

