


35-04-03-00-000501-00
+ 35-04-03-00-000504-00

RECEIVED
JAN 03 2023
OWRD

RECEIVED
JAN 30 2023
OWRD
SALEM, OREGON

MAP 34 6 34

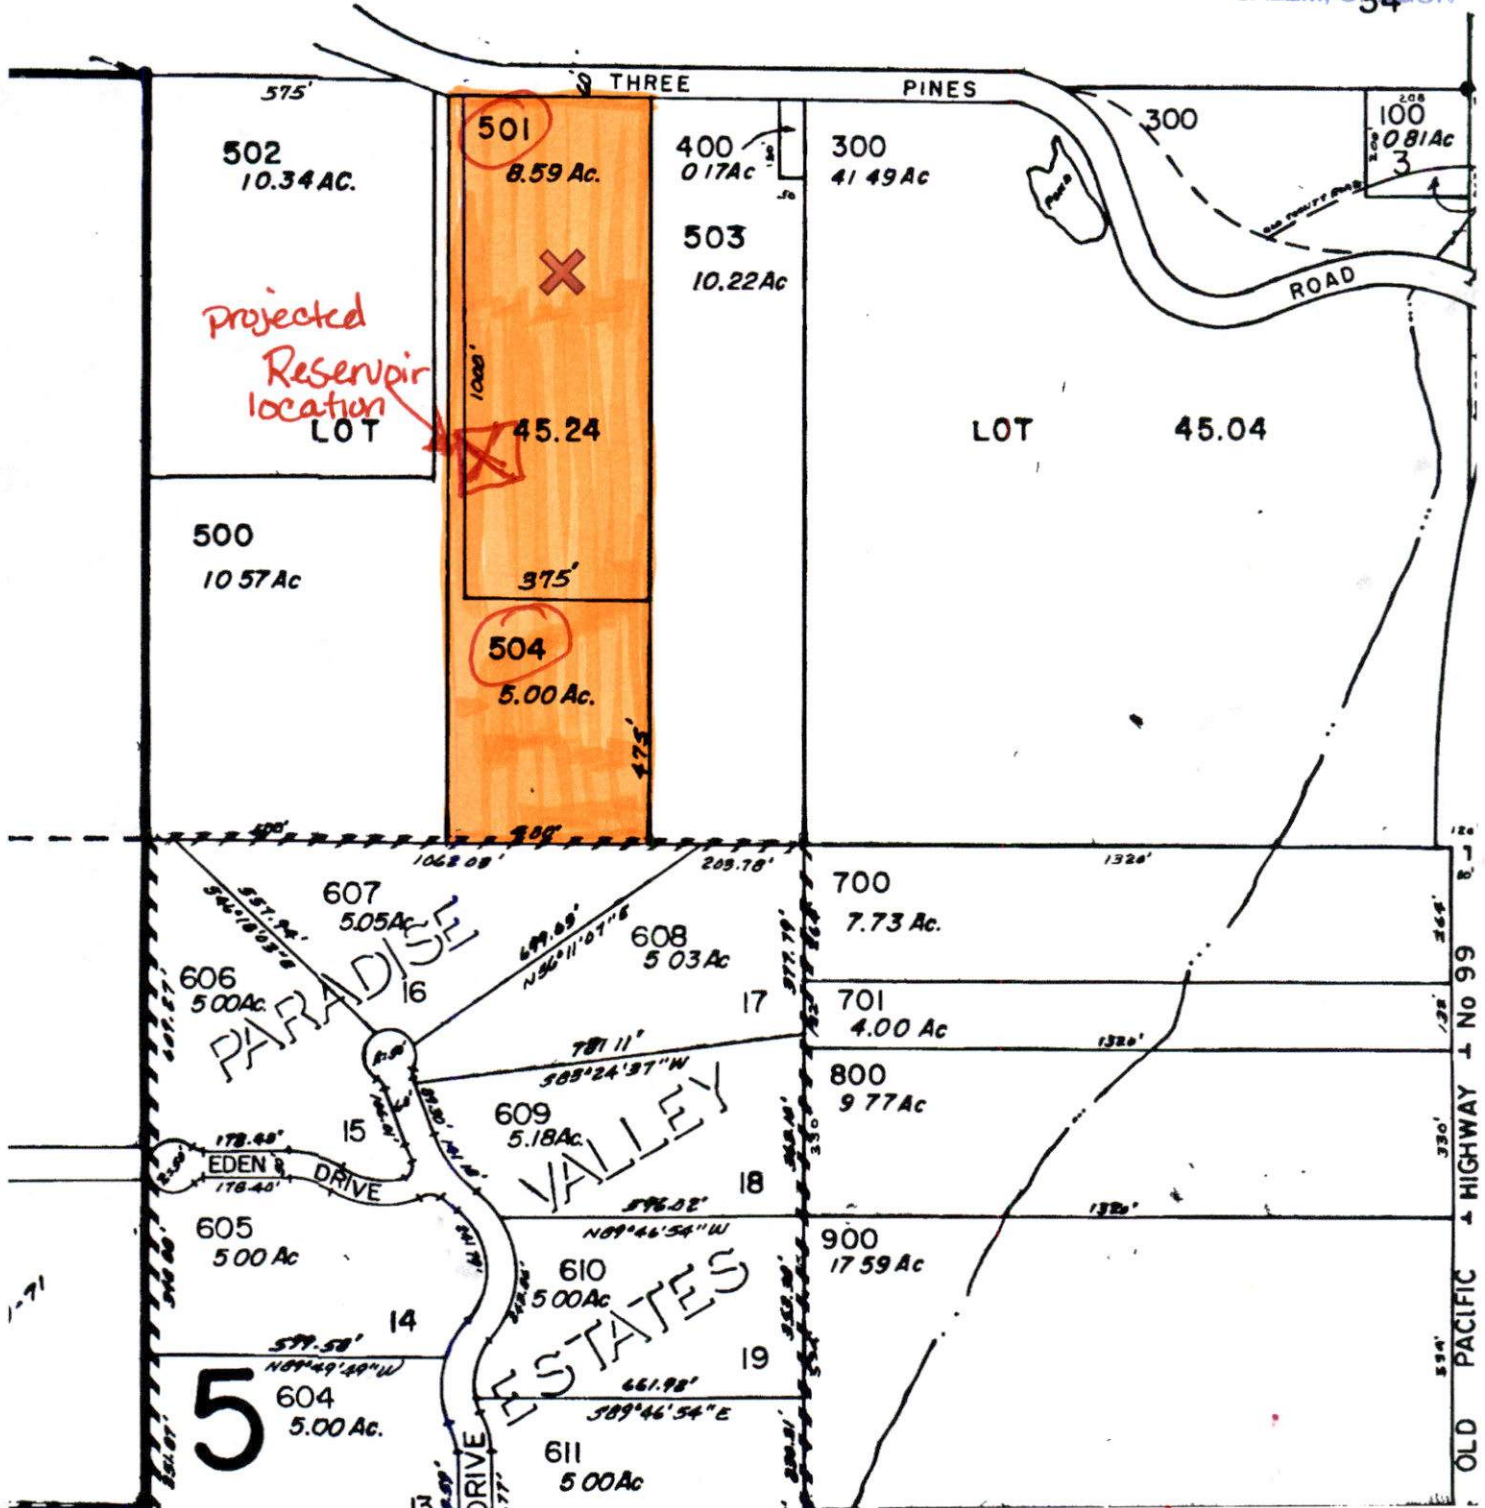

Land is seen as 1 tax lot per Josephine County as it is zoned EFU!

MAP TAX LOT: 35-06-03-00-000501-00
+ 35-06-03-00-000504-00

QT/QT
NW/NE

Township, Range, Section, 1/4 1/4 tax lot
(100 Feet East & 510 Feet South from the NW corner)


RECEIVED

JAN 03 2023

OWRD

450 THREE PINES RD GRANTS PASS OR 97526

THREE PINES RD

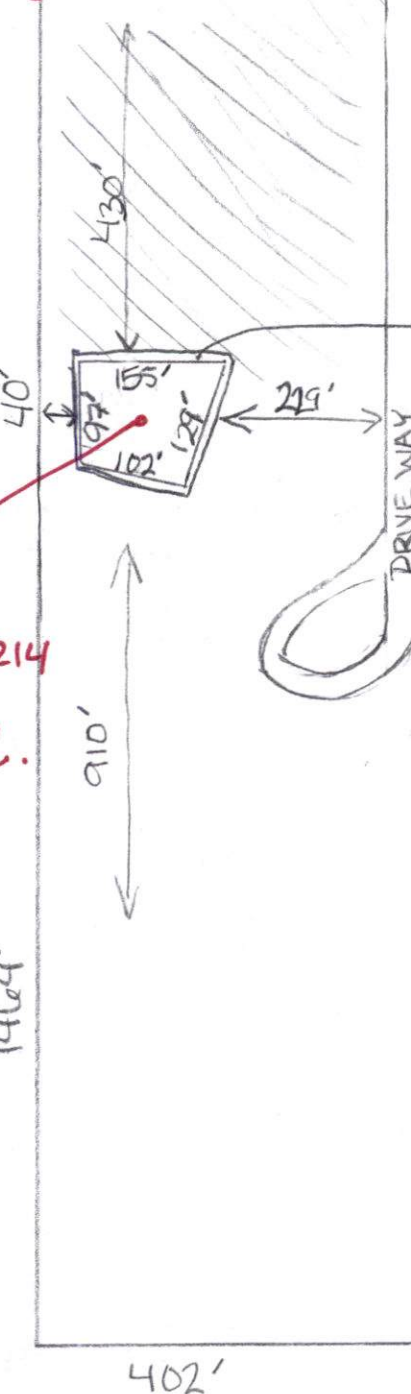

0.39 ACRE FEET
3.91 ACRE FEET
CAPACITY

42.56391, -123.39214
Coordinates to
center of pond.

MAX
9' sides above ground.

RECEIVED

JAN 30 2023

OWRD
SALEM, OREGON

