



17 16

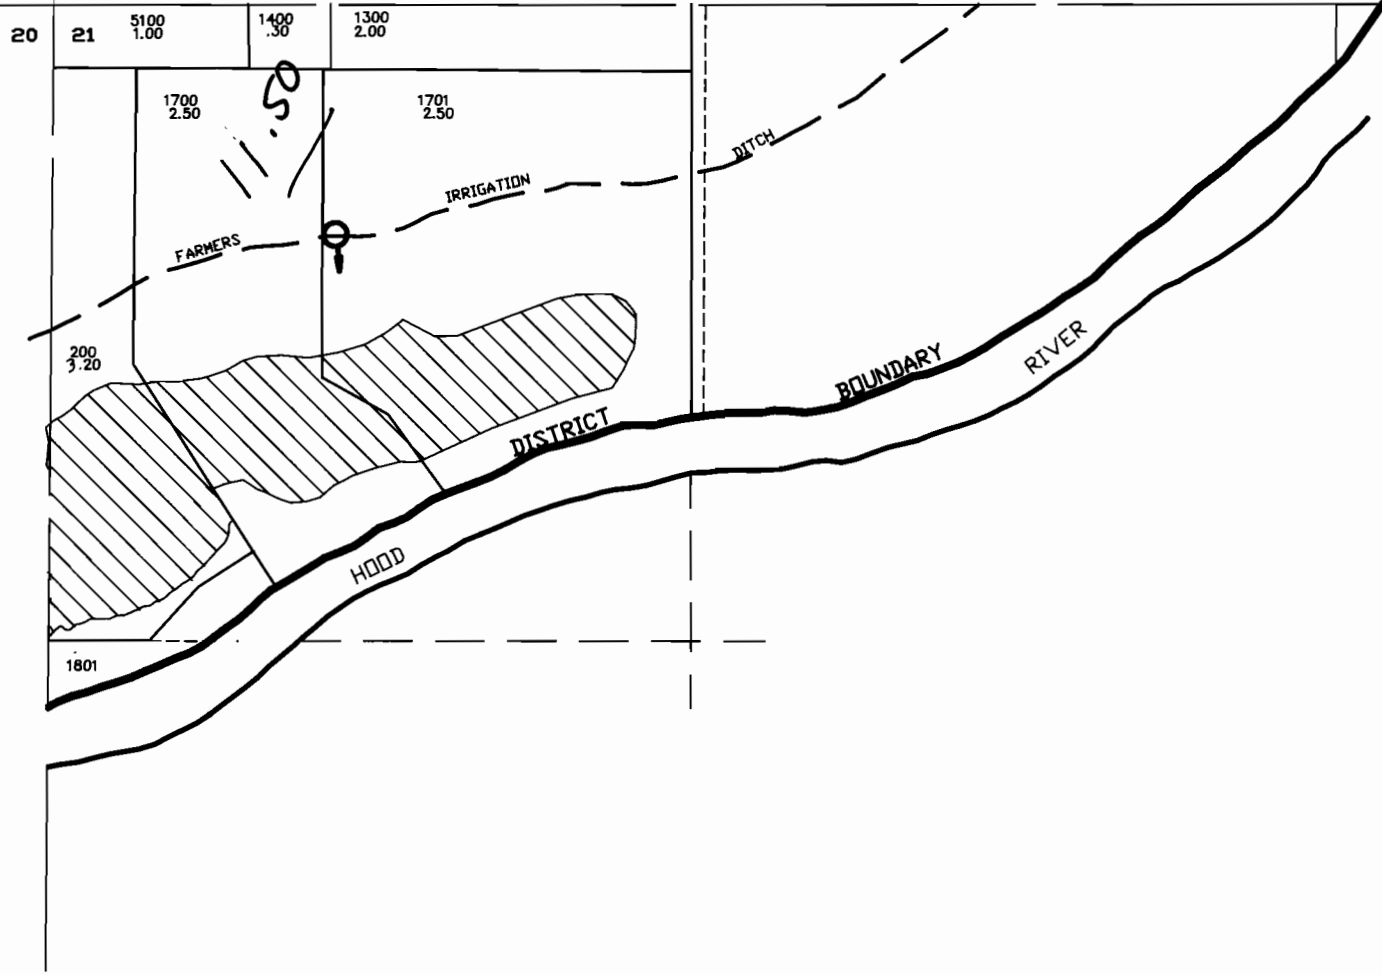

MAP SYMBOL LEGEND	
	SECTION LINE
	DISTRICT BOUNDARY
	QTR-SECTION LINE
	PROPERTY LINE
	RIGHT OF WAY
	PRIVATE ROAD
	DLC LINE
	EASEMENT
	RIVER
	CANAL
	CREEK
	B.P.A. EASEMENT
	PIPE
	PENSTOCK
	OPEN DITCH
	TURNOUT BOX
	PUMP FROM FARMERS DITCH
	RAINY CREEK PERMIT

WATER RIGHTS CERTIFICATES LEGEND	
	C-46954
	C-46955
	C-46956
	C-47710
	C-63288

FARMERS IRRIGATION DISTRICT
 HOOD RIVER OREGON
 SECTION 21 T2N R10E
 REVISION DATE: MAY 4, 1994

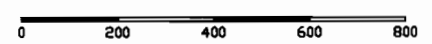

SCALE: 1" = 400' *Gony & Osborne, Inc.*