


THIS MAP IS FOR ASSESSMENT AND TAXATION PURPOSES ONLY

SEC. 17 T.8S. R.5W. W.M.

Polk County

1" = 400'

8.5.17

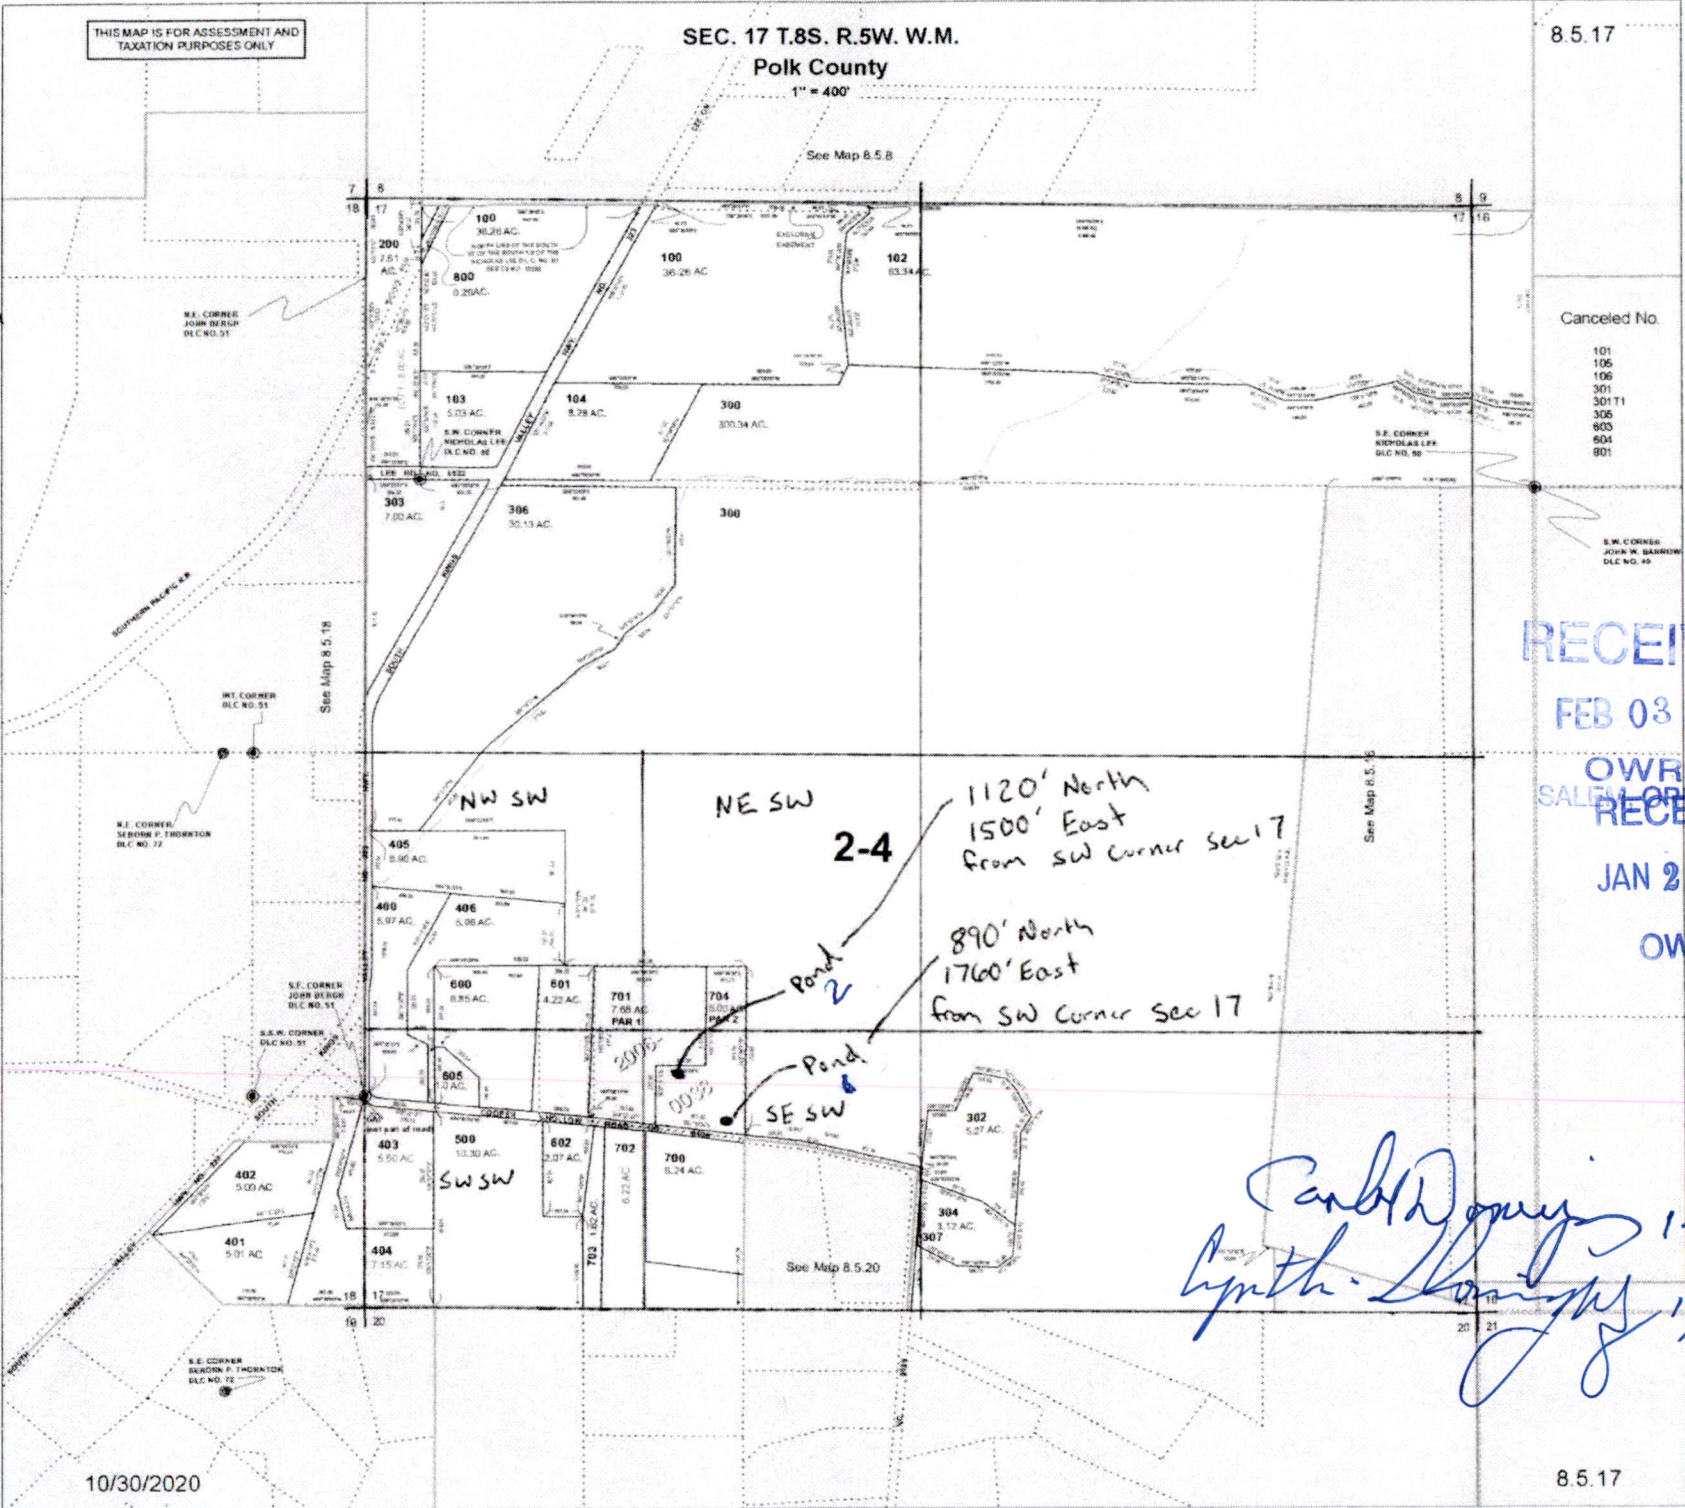

10/30/2020

8.5.17

Carla D. Jones 1-19-2023
Cynth. D. Jones 1/19/2023