



Section 10, T3S, R1E, W.M., Clackamas County, Oregon

Application G-12224, Permit G-11158
 CLAIM OF BENEFICIAL USE MAP
 Oregon CC, LLC

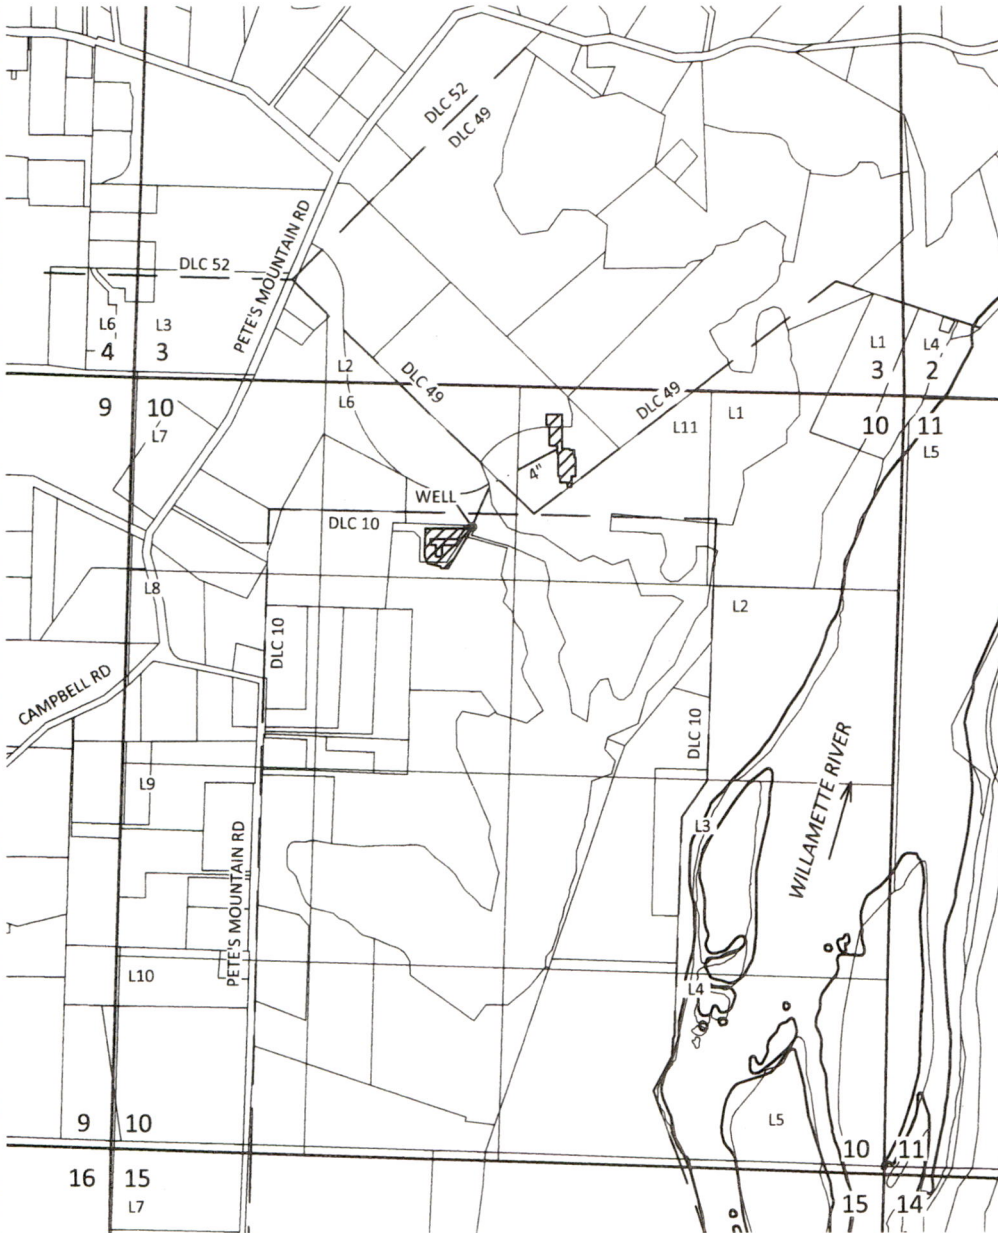

WELL LOCATION: 1030 FT S AND 2320 FT E
 FROM NW CORNER OF SECTION 10, T3S, R1E, W.M.

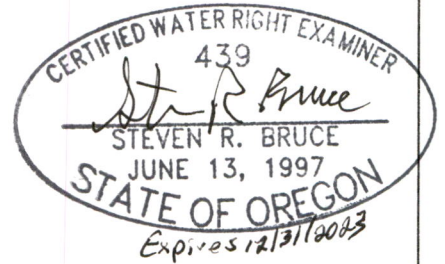

RECEIVED

JAN 30 2023

OWRD



SCALE



1 INCH = 1320 FEET

Site Inspection Conducted
 11/18/2022

December 12, 2022

This map is not intended to provide legal
 dimensions or locations of property
 ownership lines

Figure 1

KPFF 2200002.04

SKOOKUM
 WATER ASSOCIATES INC

1626 VICTORIAN WAY
 EUGENE, OR 97401
 (503) 319-8926

EXPLANATION



PLACE OF USE
 COMMERCIAL USE IN GOLF COURSE
 CLUBHOUSE FACILITIES
 PRIORITY: 9/5/1990



WELL



4" PIPE